




RECEIVED  
DIVISION OF MINE  
SUBSIDENCE REGULATION  
JUL 27 1979  
McMURRAY  
PENNSYLVANIA

DUQUESNE LIGHT CO.  
COAL DEPARTMENT  
WARWICK MINE NO. 2  
SCALE: 1"=100'  
MONONGAHELA TWP., GREENE COUNTY, PA.

*John L. Dwyer*  
RPE 2430E

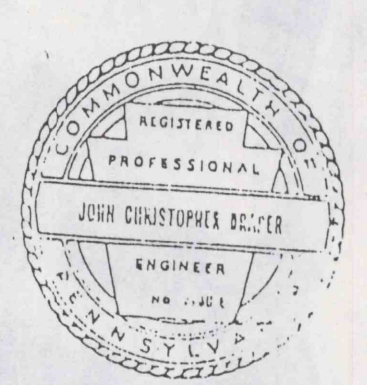

LEGEND  
FINAL MAP. MINING WAS COMPLETED AT  
THE END OF 6-22-79.

PROPERTY LINE	---
PROTECTED STRUCTURES	11-10-25
UNPROTECTED STRUCTURES (NEW, AFTER LAW)	11-10-25-A
STRUCTURES DEMOLISHED	11-10-25-B

FINAL  
Sh. 7