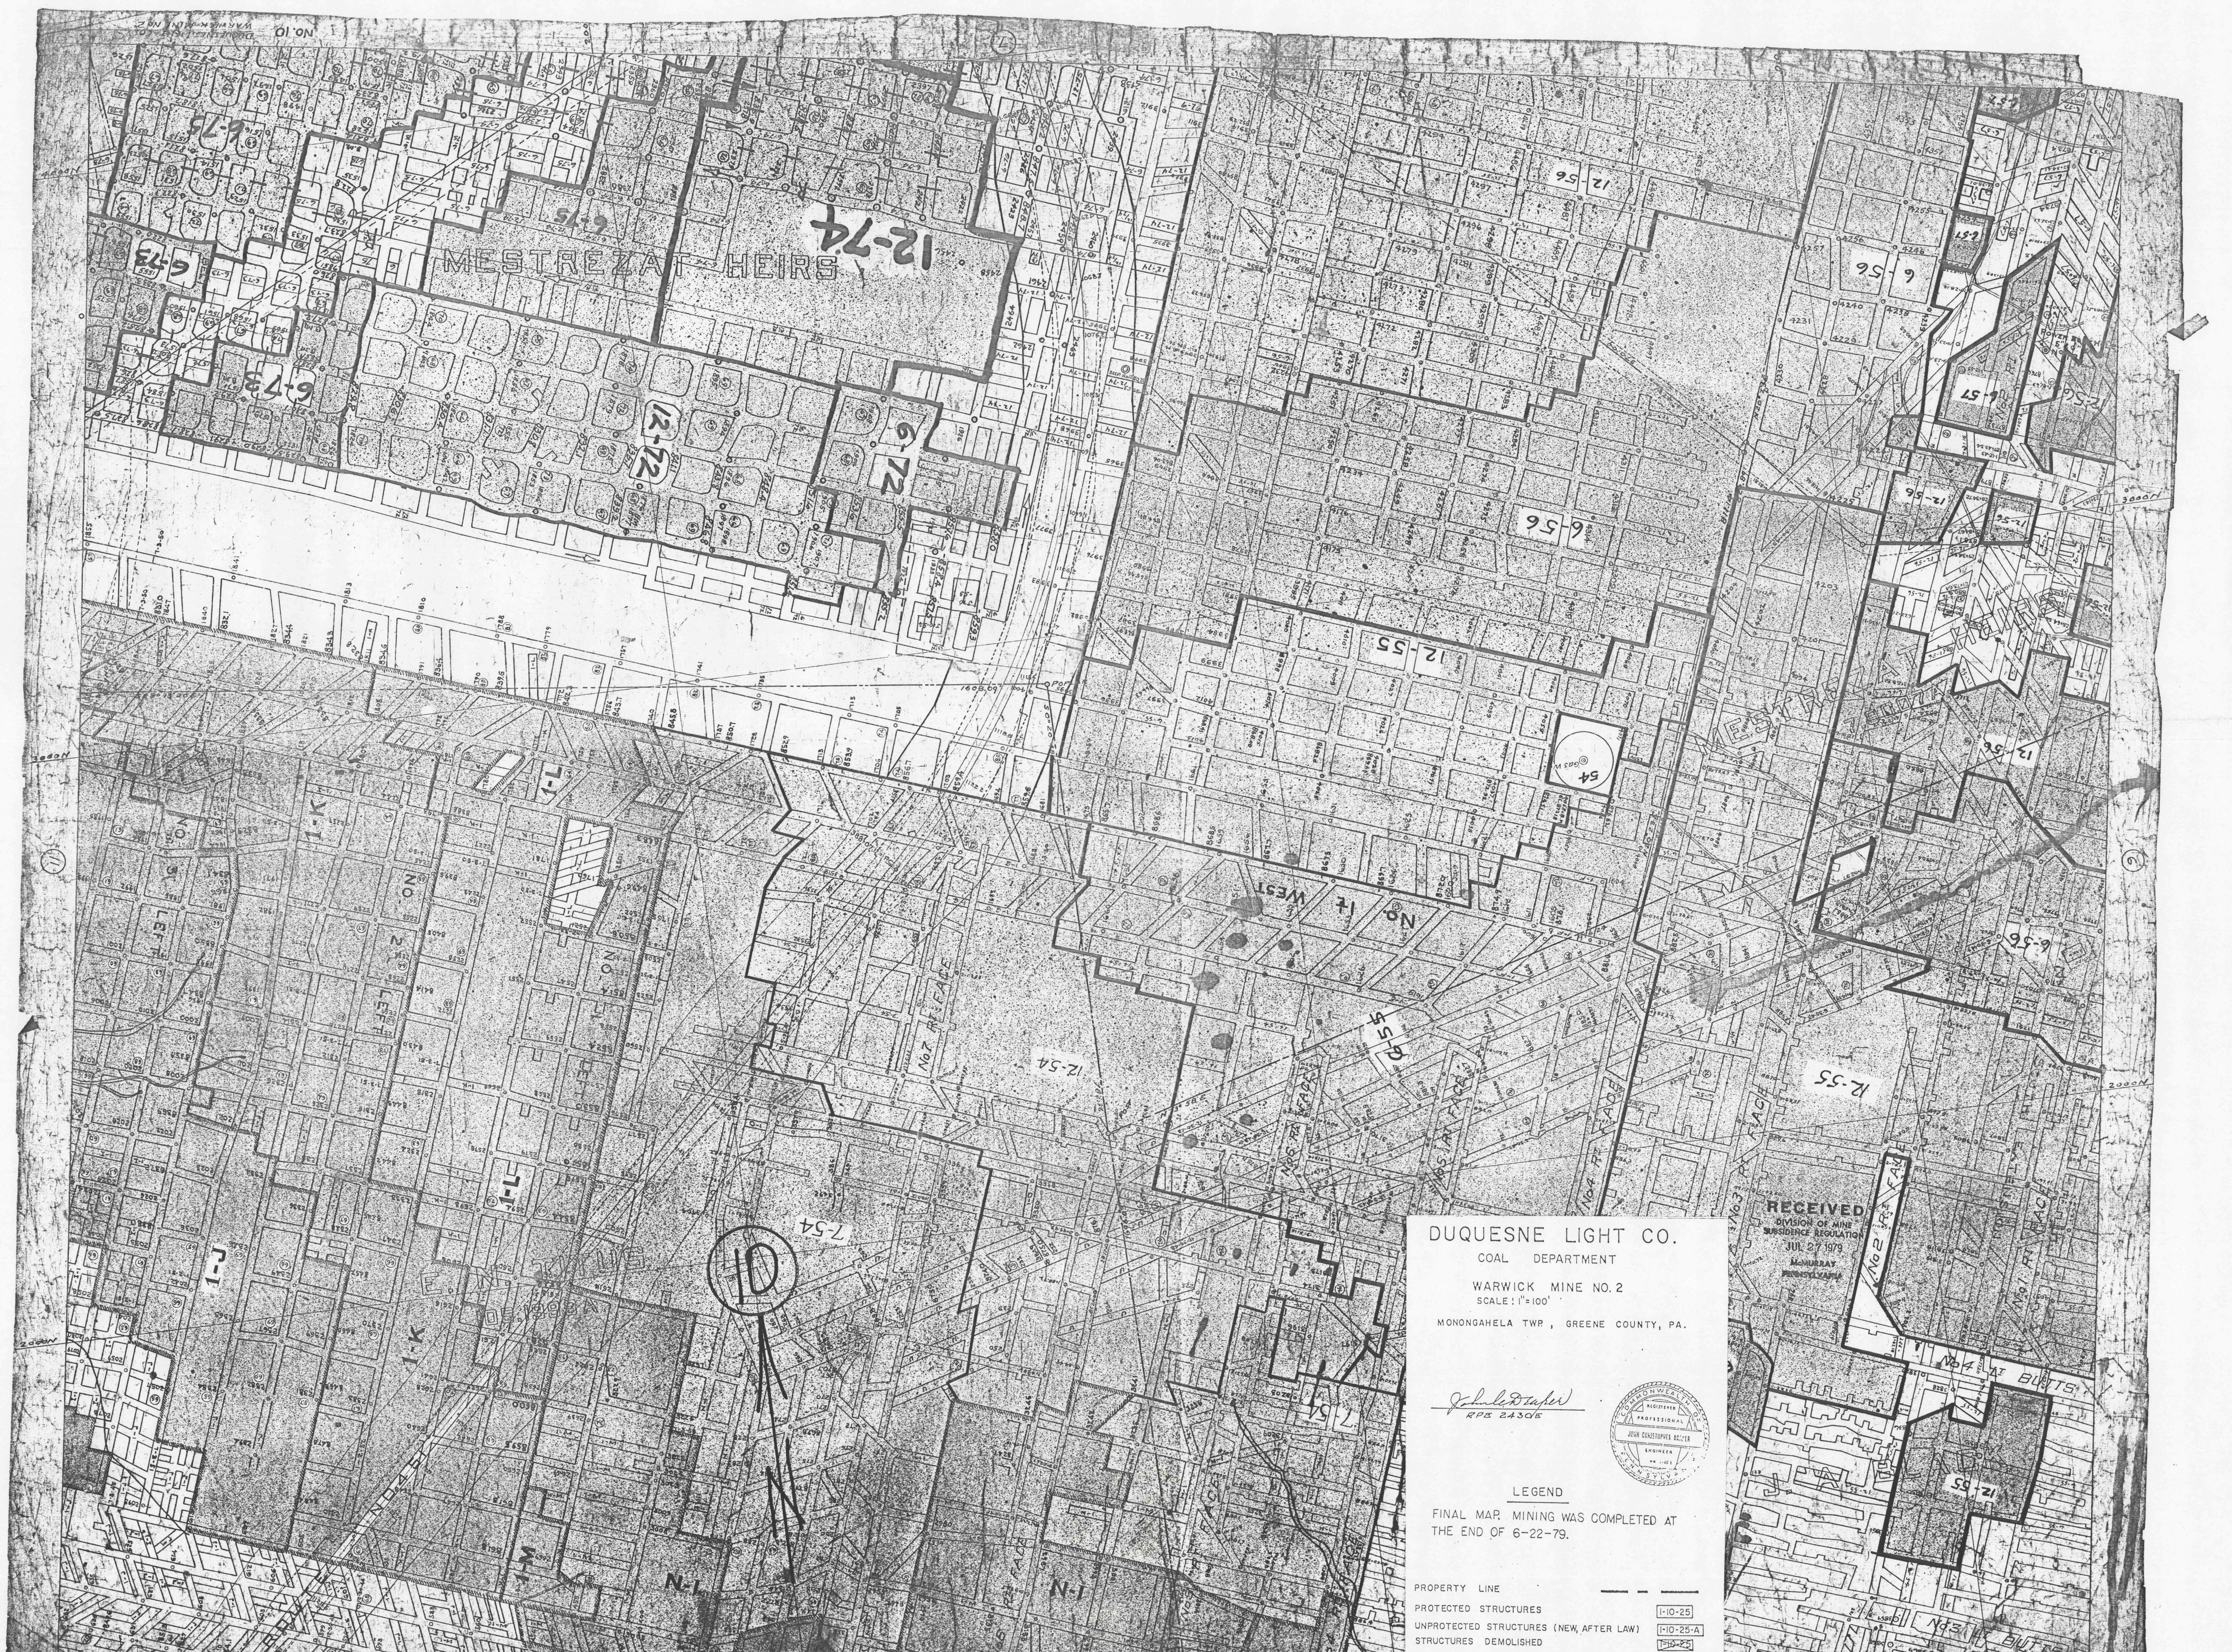
MESTREZAT HEIRS
12-74
12-72
6-72
6-73
6-75
12-56
6-56
12-55
6-55
12-54
7-54
6-57
No 12 WEST
No 7 Rt FACE
No 5 Rt FACE
No 4 Rt FACE
No 3 Rt FACE
No 2 Rt FACE
No 4 Rt BUTTS
1-J
1-K
1-L
1-M
N-1
10
N

DUQUESNE LIGHT CO.
COAL DEPARTMENT
WARWICK MINE NO. 2
SCALE: 1"=100'
MONONGAHELA TWP., GREENE COUNTY, PA.

John C. Draper
RPE 2430E

JOHN CHRISTOPHER DRAPER

RECEIVED
DIVISION OF MINE
SUBSIDENCE REGULATION
JUL 27 1979
McMURRAY
PENNSYLVANIA

LEGEND

FINAL MAP. MINING WAS COMPLETED AT THE END OF 6-22-79.

PROPERTY LINE	— — — —
PROTECTED STRUCTURES	1-10-25
UNPROTECTED STRUCTURES (NEW, AFTER LAW)	1-10-25-A
STRUCTURES DEMOLISHED	~~1-10-25~~

FINAL