


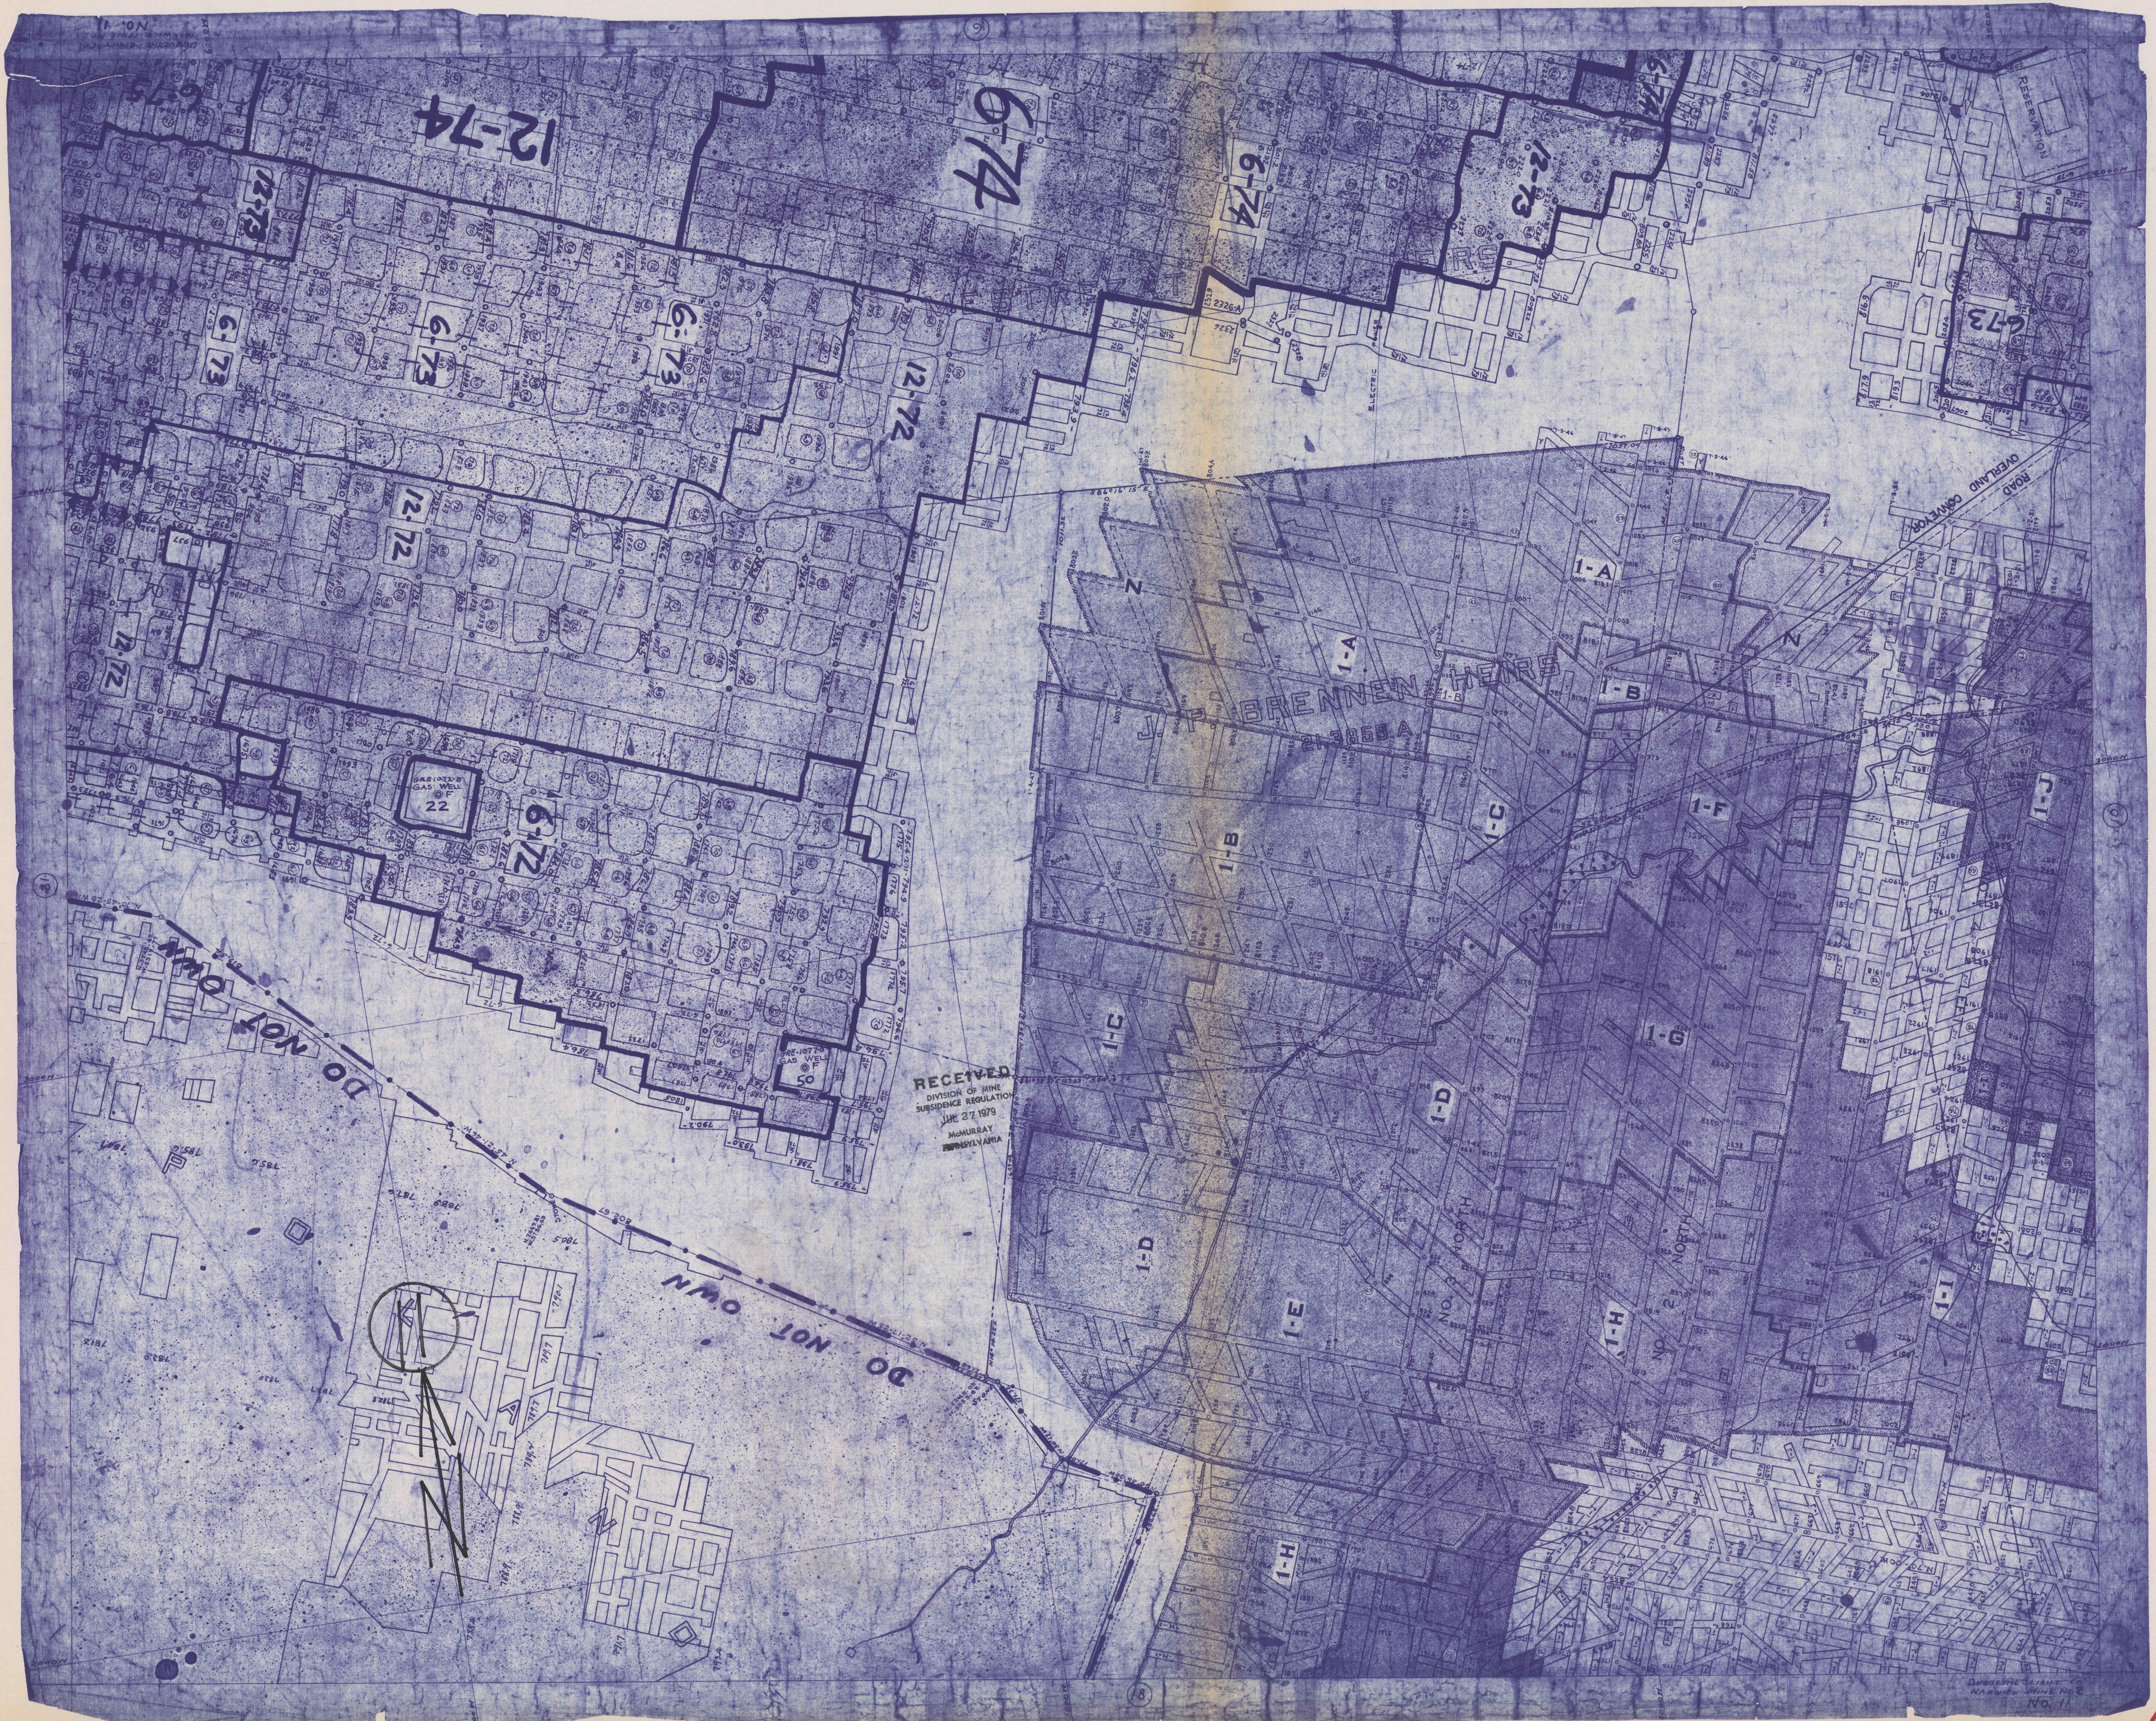

RECEIVED
DIVISION OF MINE
SUBSIDENCE REGULATION
JUNE 27 1979
McMURRAY
PENNSYLVANIA