


RECEIVED
DIVISION OF MINE
SUBSISTENCE REGULATION
JUL 27 1979
McMURRAY
PENNSYLVANIA

DUQUESNE LIGHT CO.
COAL DEPARTMENT
WARWICK MINE No. 2
SCALE: 1"=100'
MONONGAHELA TWP., GREENE COUNTY, PA.

John D. Staper
RPE 24305

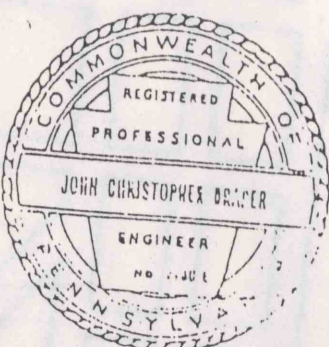

LEGEND


FINAL MAP. MINING WAS COMPLETED AT
THE END OF 6-22-79.

PROPERTY LINE
PROTECTED STRUCTURES
UNPROTECTED STRUCTURES (NEW, AFTER LAW)
STRUCTURES DEMOLISHED

1-0-25
1-10-25-A
1-10-25-B

9-25
WELL

DO NOT OWN

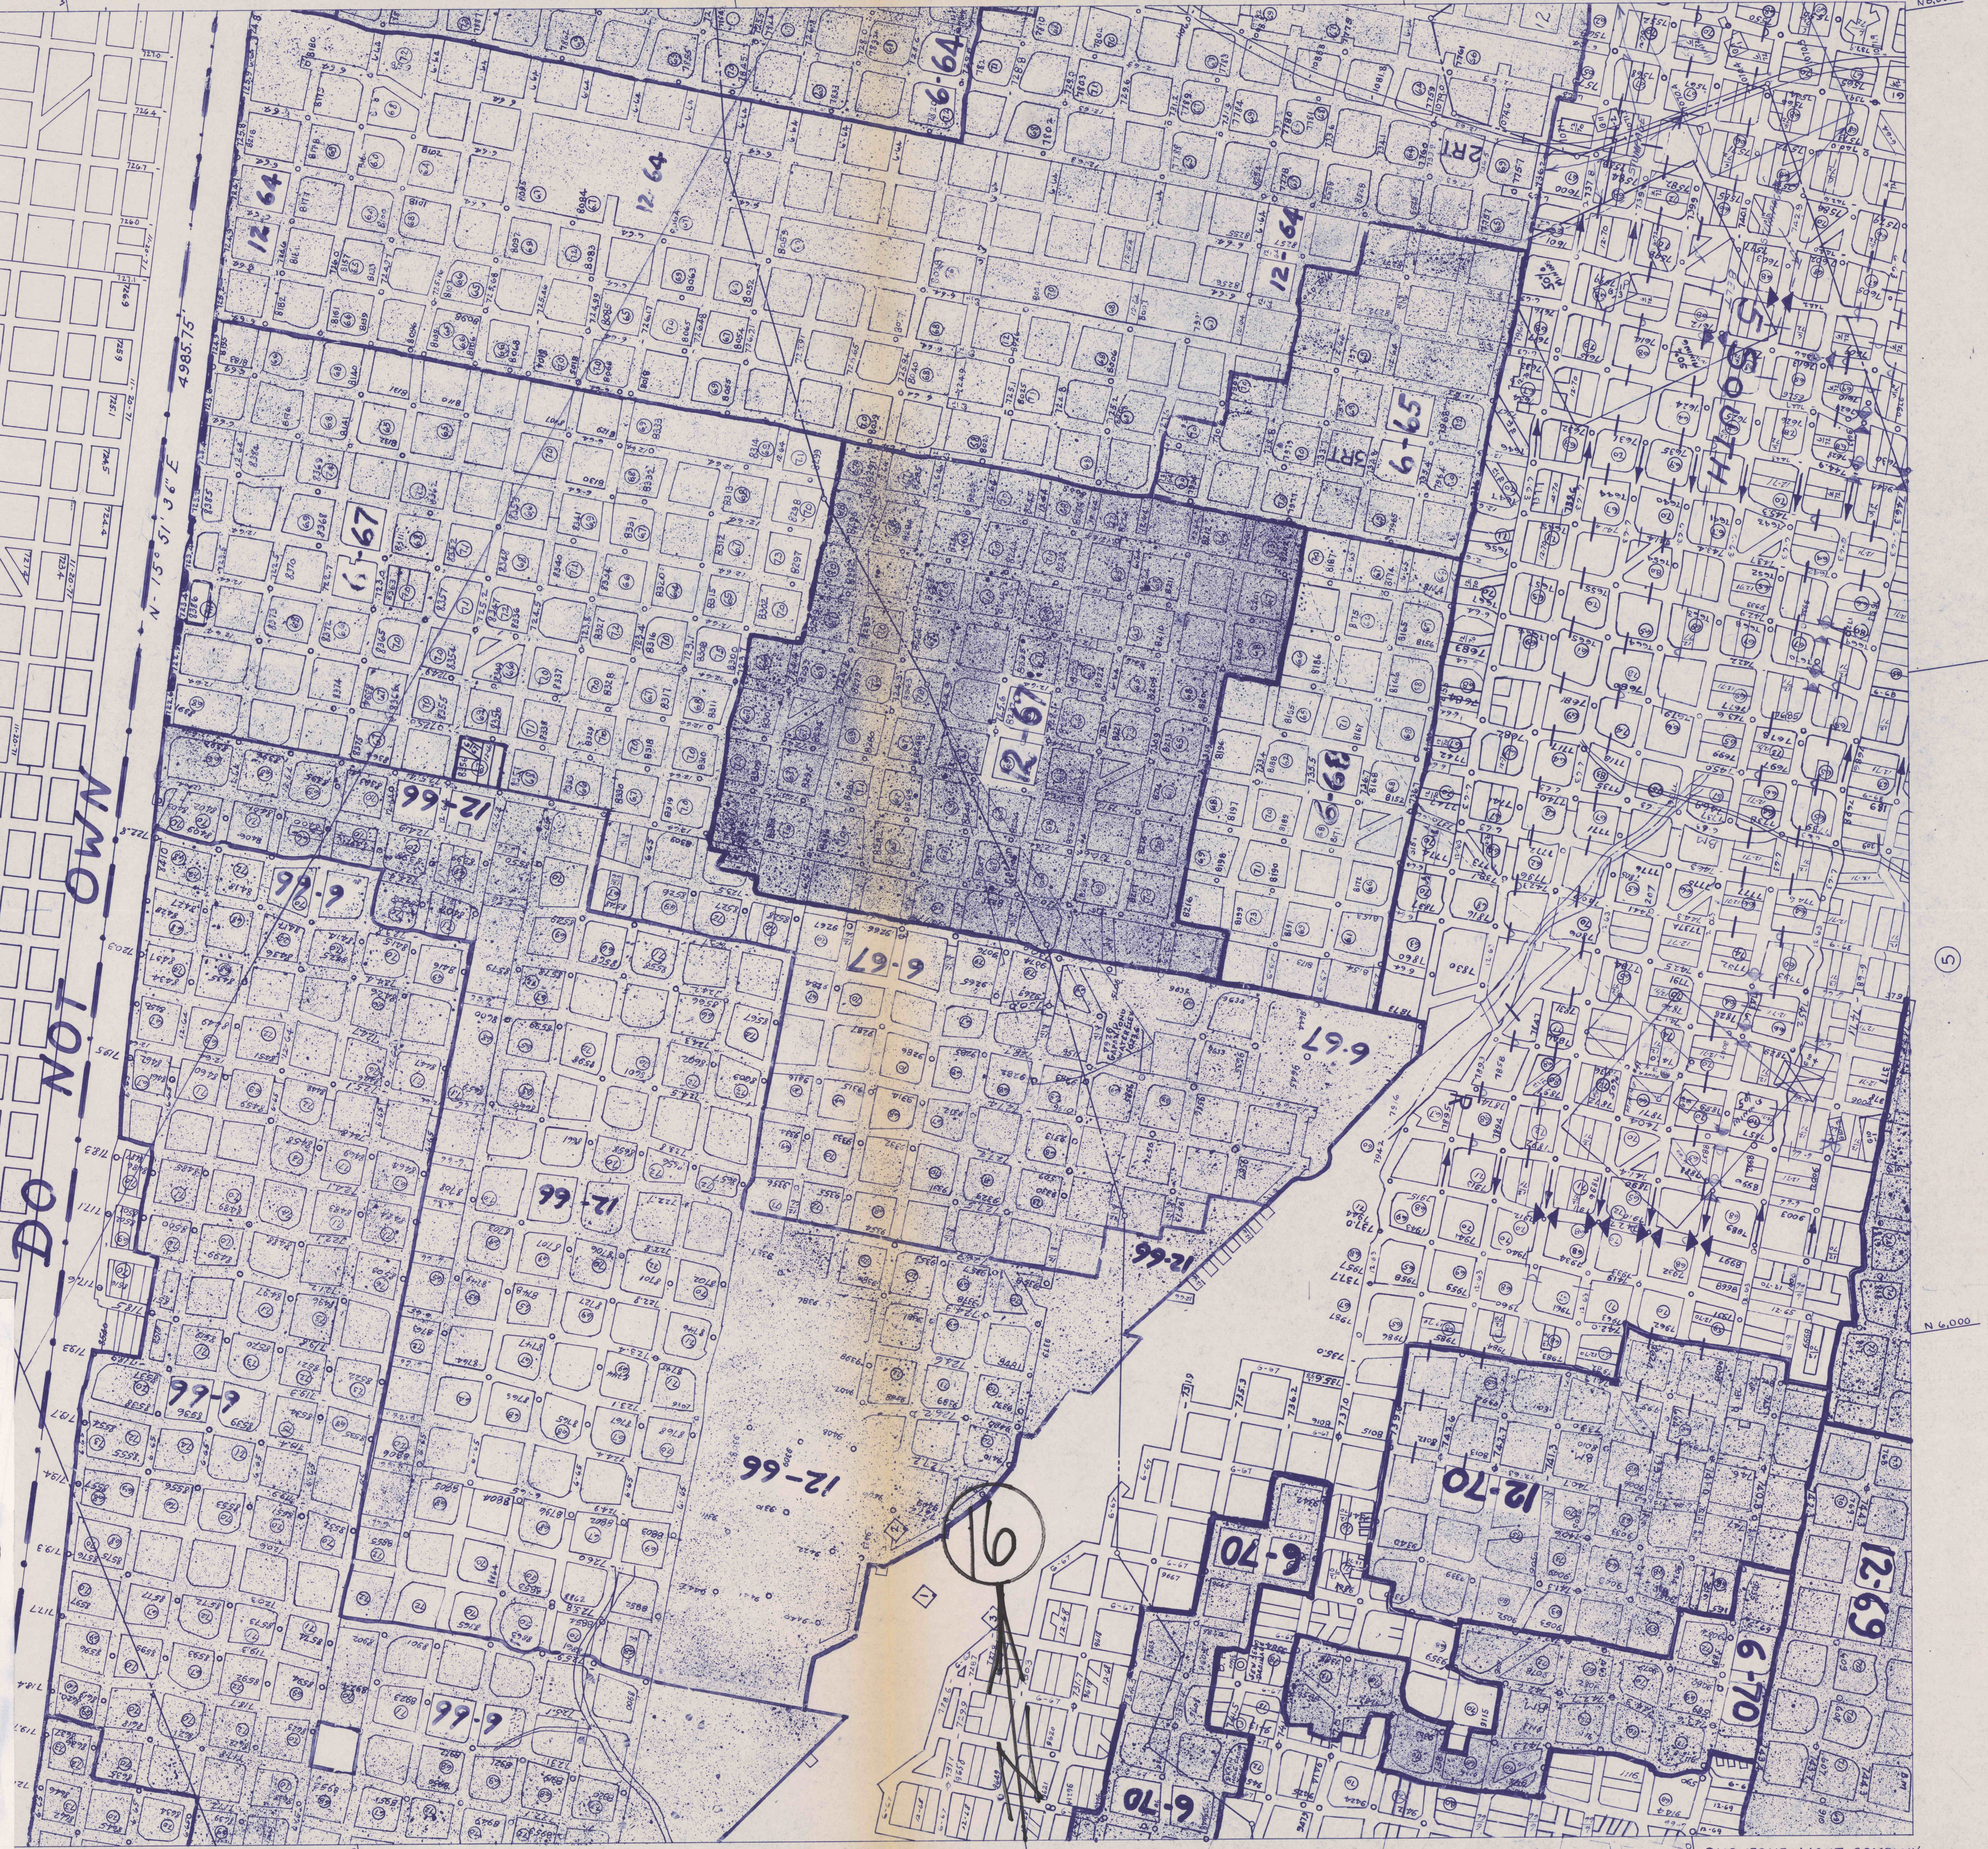

DUQUESNE LIGHT COMPANY
WARWICK MINE No 2
PITTSBURGH COAL