


No 17
WARWICK MINE NO. 2
PITTSBURGH, PA.

U.S. STEEL ROBEINA MINE

RECEIVED
DIVISION OF MINE
SUBSIDENCE REGULATION
JUL 27 1979
MCMURRAY
PITTSBURGH, PA.

DUQUESNE LIGHT CO.
COAL DEPARTMENT
WARWICK MINE NO. 2
SCALE 1"=100'
MONONGAHELA TWP., GREENE COUNTY, PA.


John D. Stupen
RPS 24306

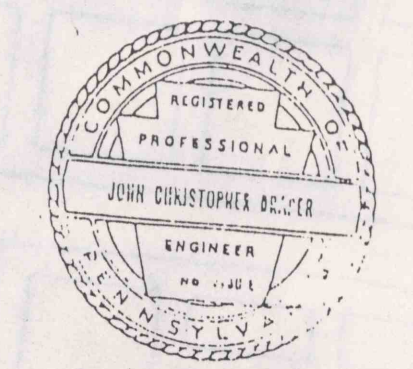

LEGEND
FINAL MAP. MINING WAS COMPLETED AT
THE END OF 6-22-79.

PROPERTY LINE
PROTECTED STRUCTURES
UNPROTECTED STRUCTURES (NEW, AFTER LAW)
STRUCTURES DEMOLISHED

10-25
10-25-A
10-25-B

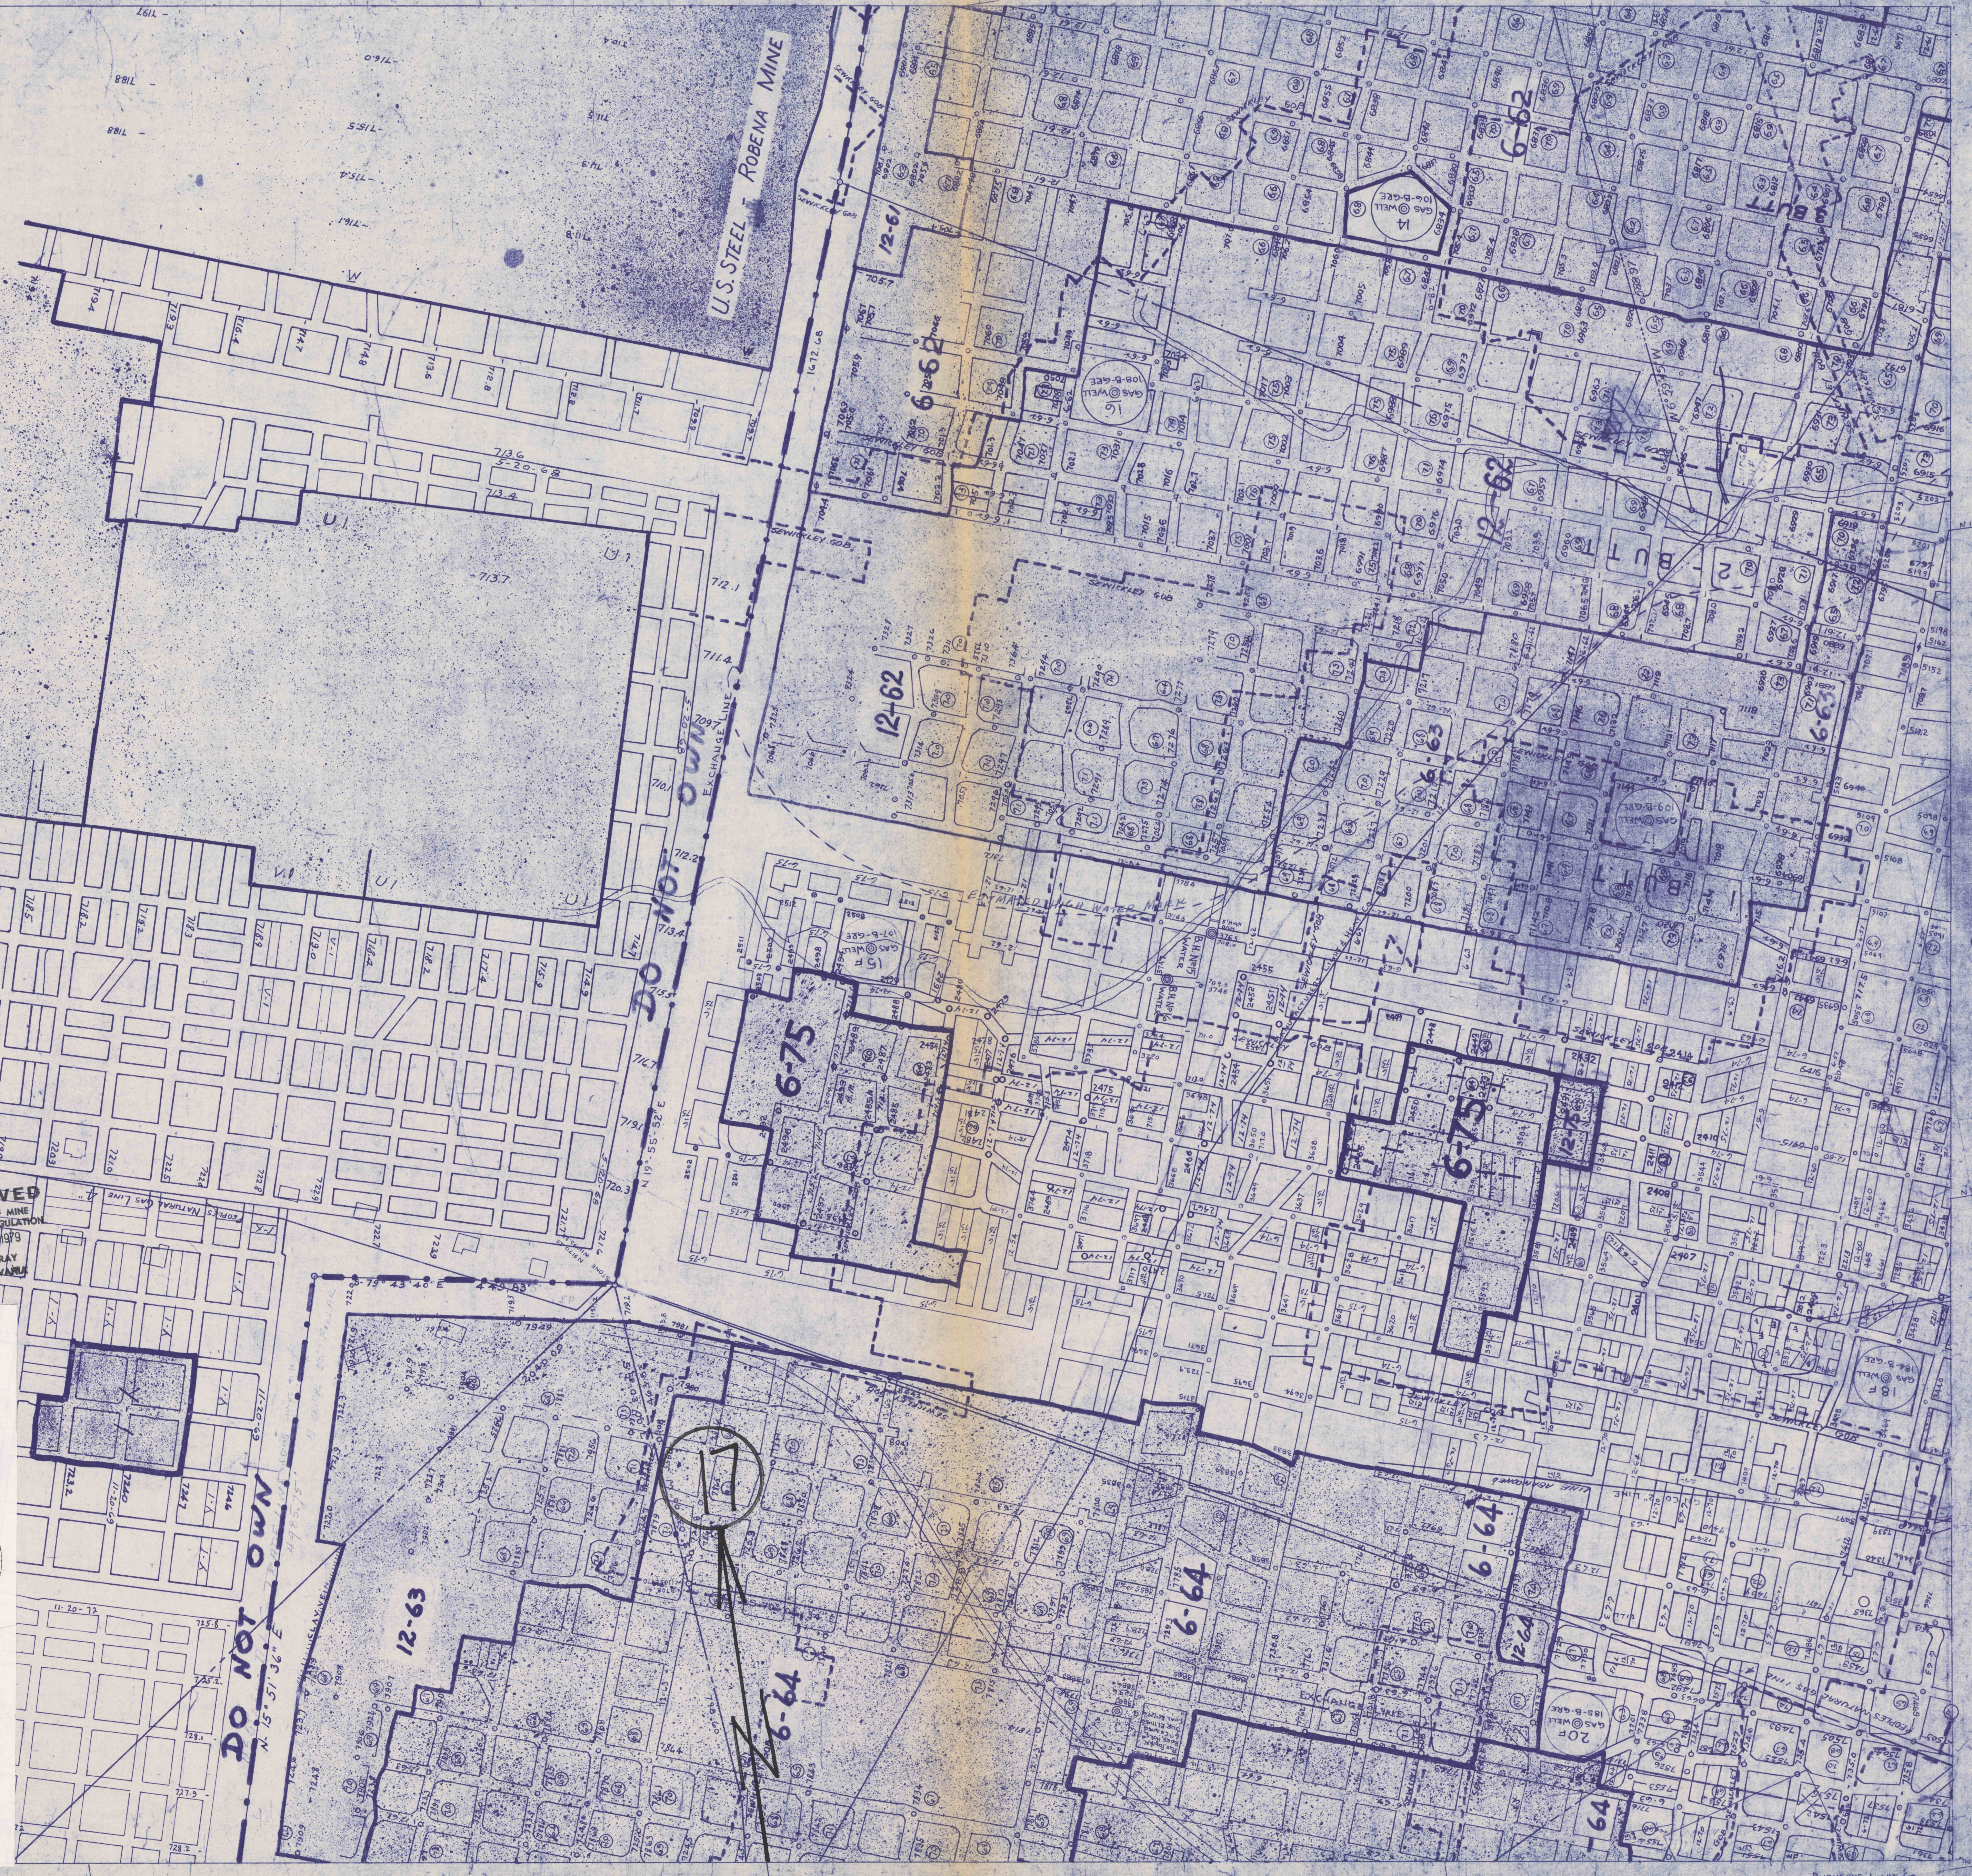

DUQUESNE LIGHT CO.
WARWICK MINE NO. 2
PITTSBURGH, PA.

FINAL

17