

DUQUESNE LIGHT CO.


COAL DEPARTMENT

WARWICK MINE NO. 2

SCALE: 1"=100'

MONONGAHELA TWP., GREENE COUNTY, PA.

John D. Staher
RPS 24306

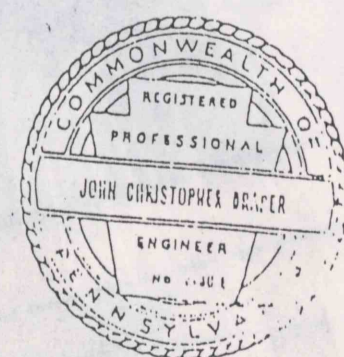

LEGEND

FINAL MAP. MINING WAS COMPLETED AT
THE END OF 6-22-79.

PROPERTY LINE

PROTECTED STRUCTURES

UNPROTECTED STRUCTURES (NEW, AFTER LAW)

STRUCTURES DEMOLISHED

1-10-25

1-10-25-A

1-10-25-B

RECEIVED

DIVISION OF MINE

SURVEILLANCE REGULATION

JUL 27 1979

McMURRAY

PENNSYLVANIA

19
N
Z

FINAL