


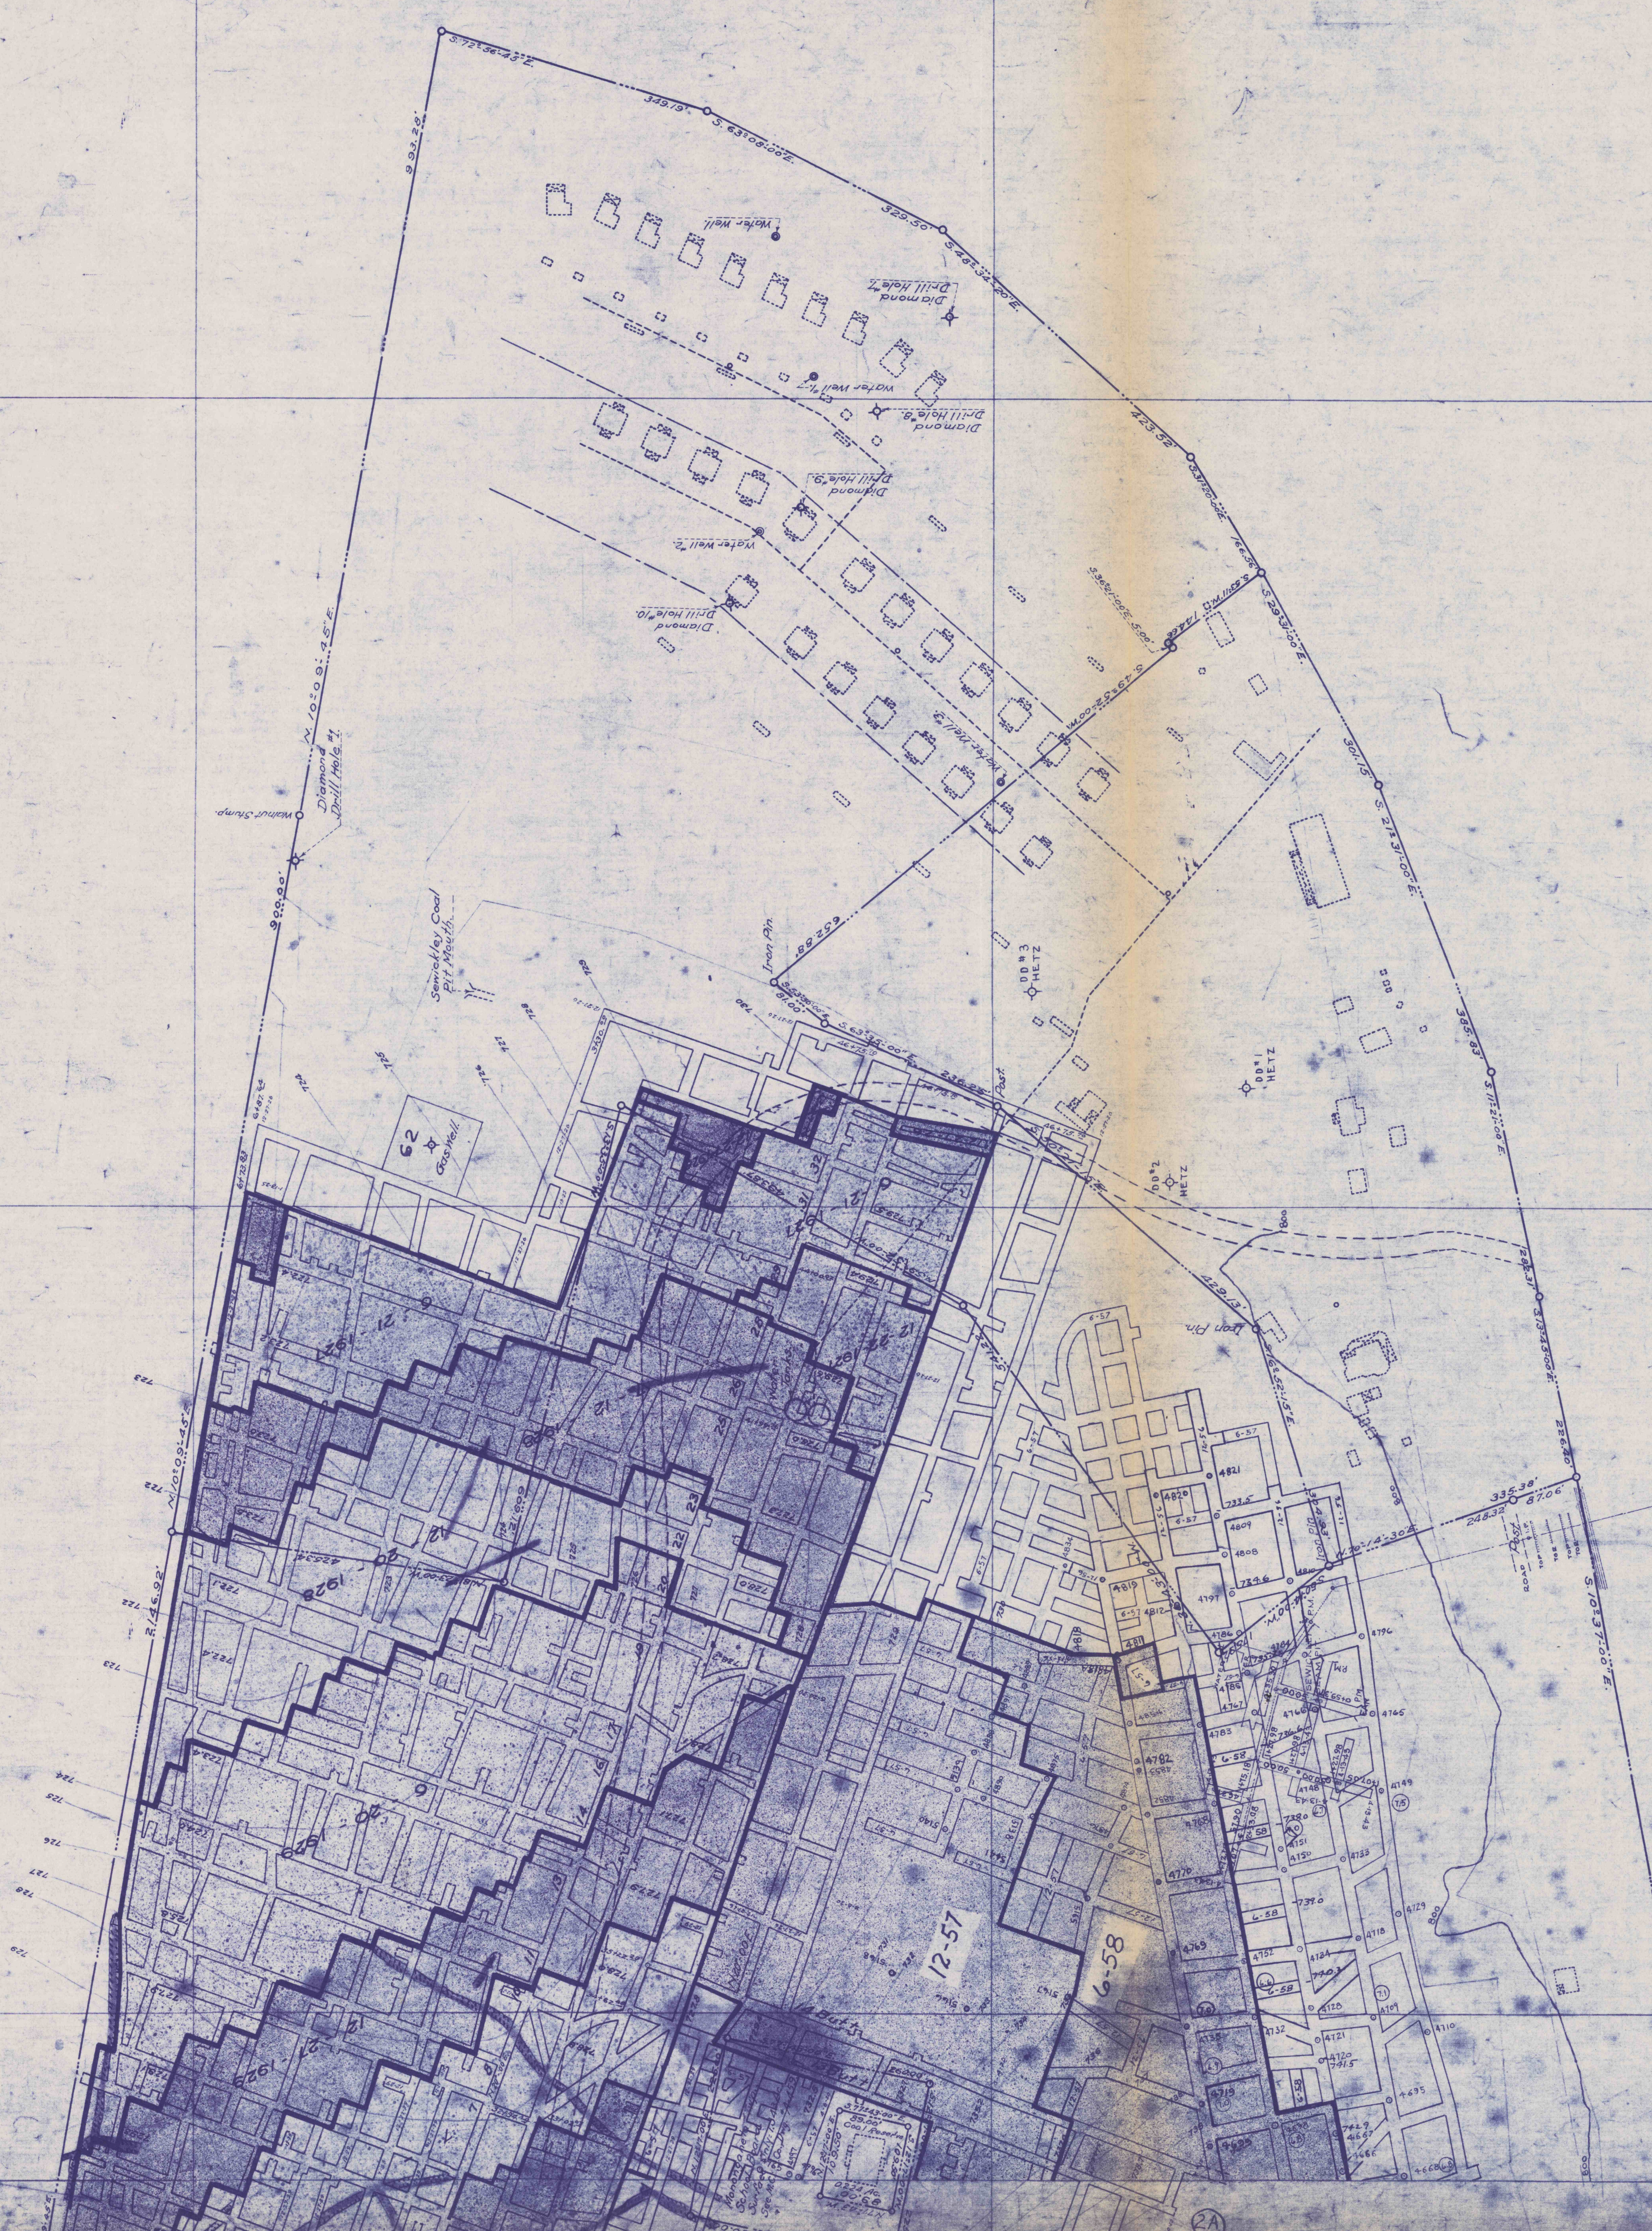



RECEIVED
DIVISION OF MINE
SUBSIDENCE REGULATION
JUL 27 1979
McMURRAY
PENNSYLVANIA

DUQUESNE LIGHT CO.
COAL DEPARTMENT
WARWICK MINE NO. 2
SCALE: 1"=100'
MONONGAHELA TWP., GREENE COUNTY, PA.

John D. [Signature]
RPS 24305

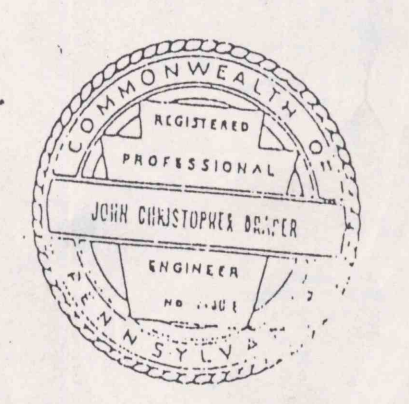

LEGEND
FINAL MAP. MINING WAS COMPLETED AT
THE END OF 6-22-79.

PROPERTY LINE	---
PROTECTED STRUCTURES	[Symbol]
UNPROTECTED STRUCTURES (NEW, AFTER LAW)	[Symbol]
STRUCTURES DEMOLISHED	[Symbol]

FINAL