



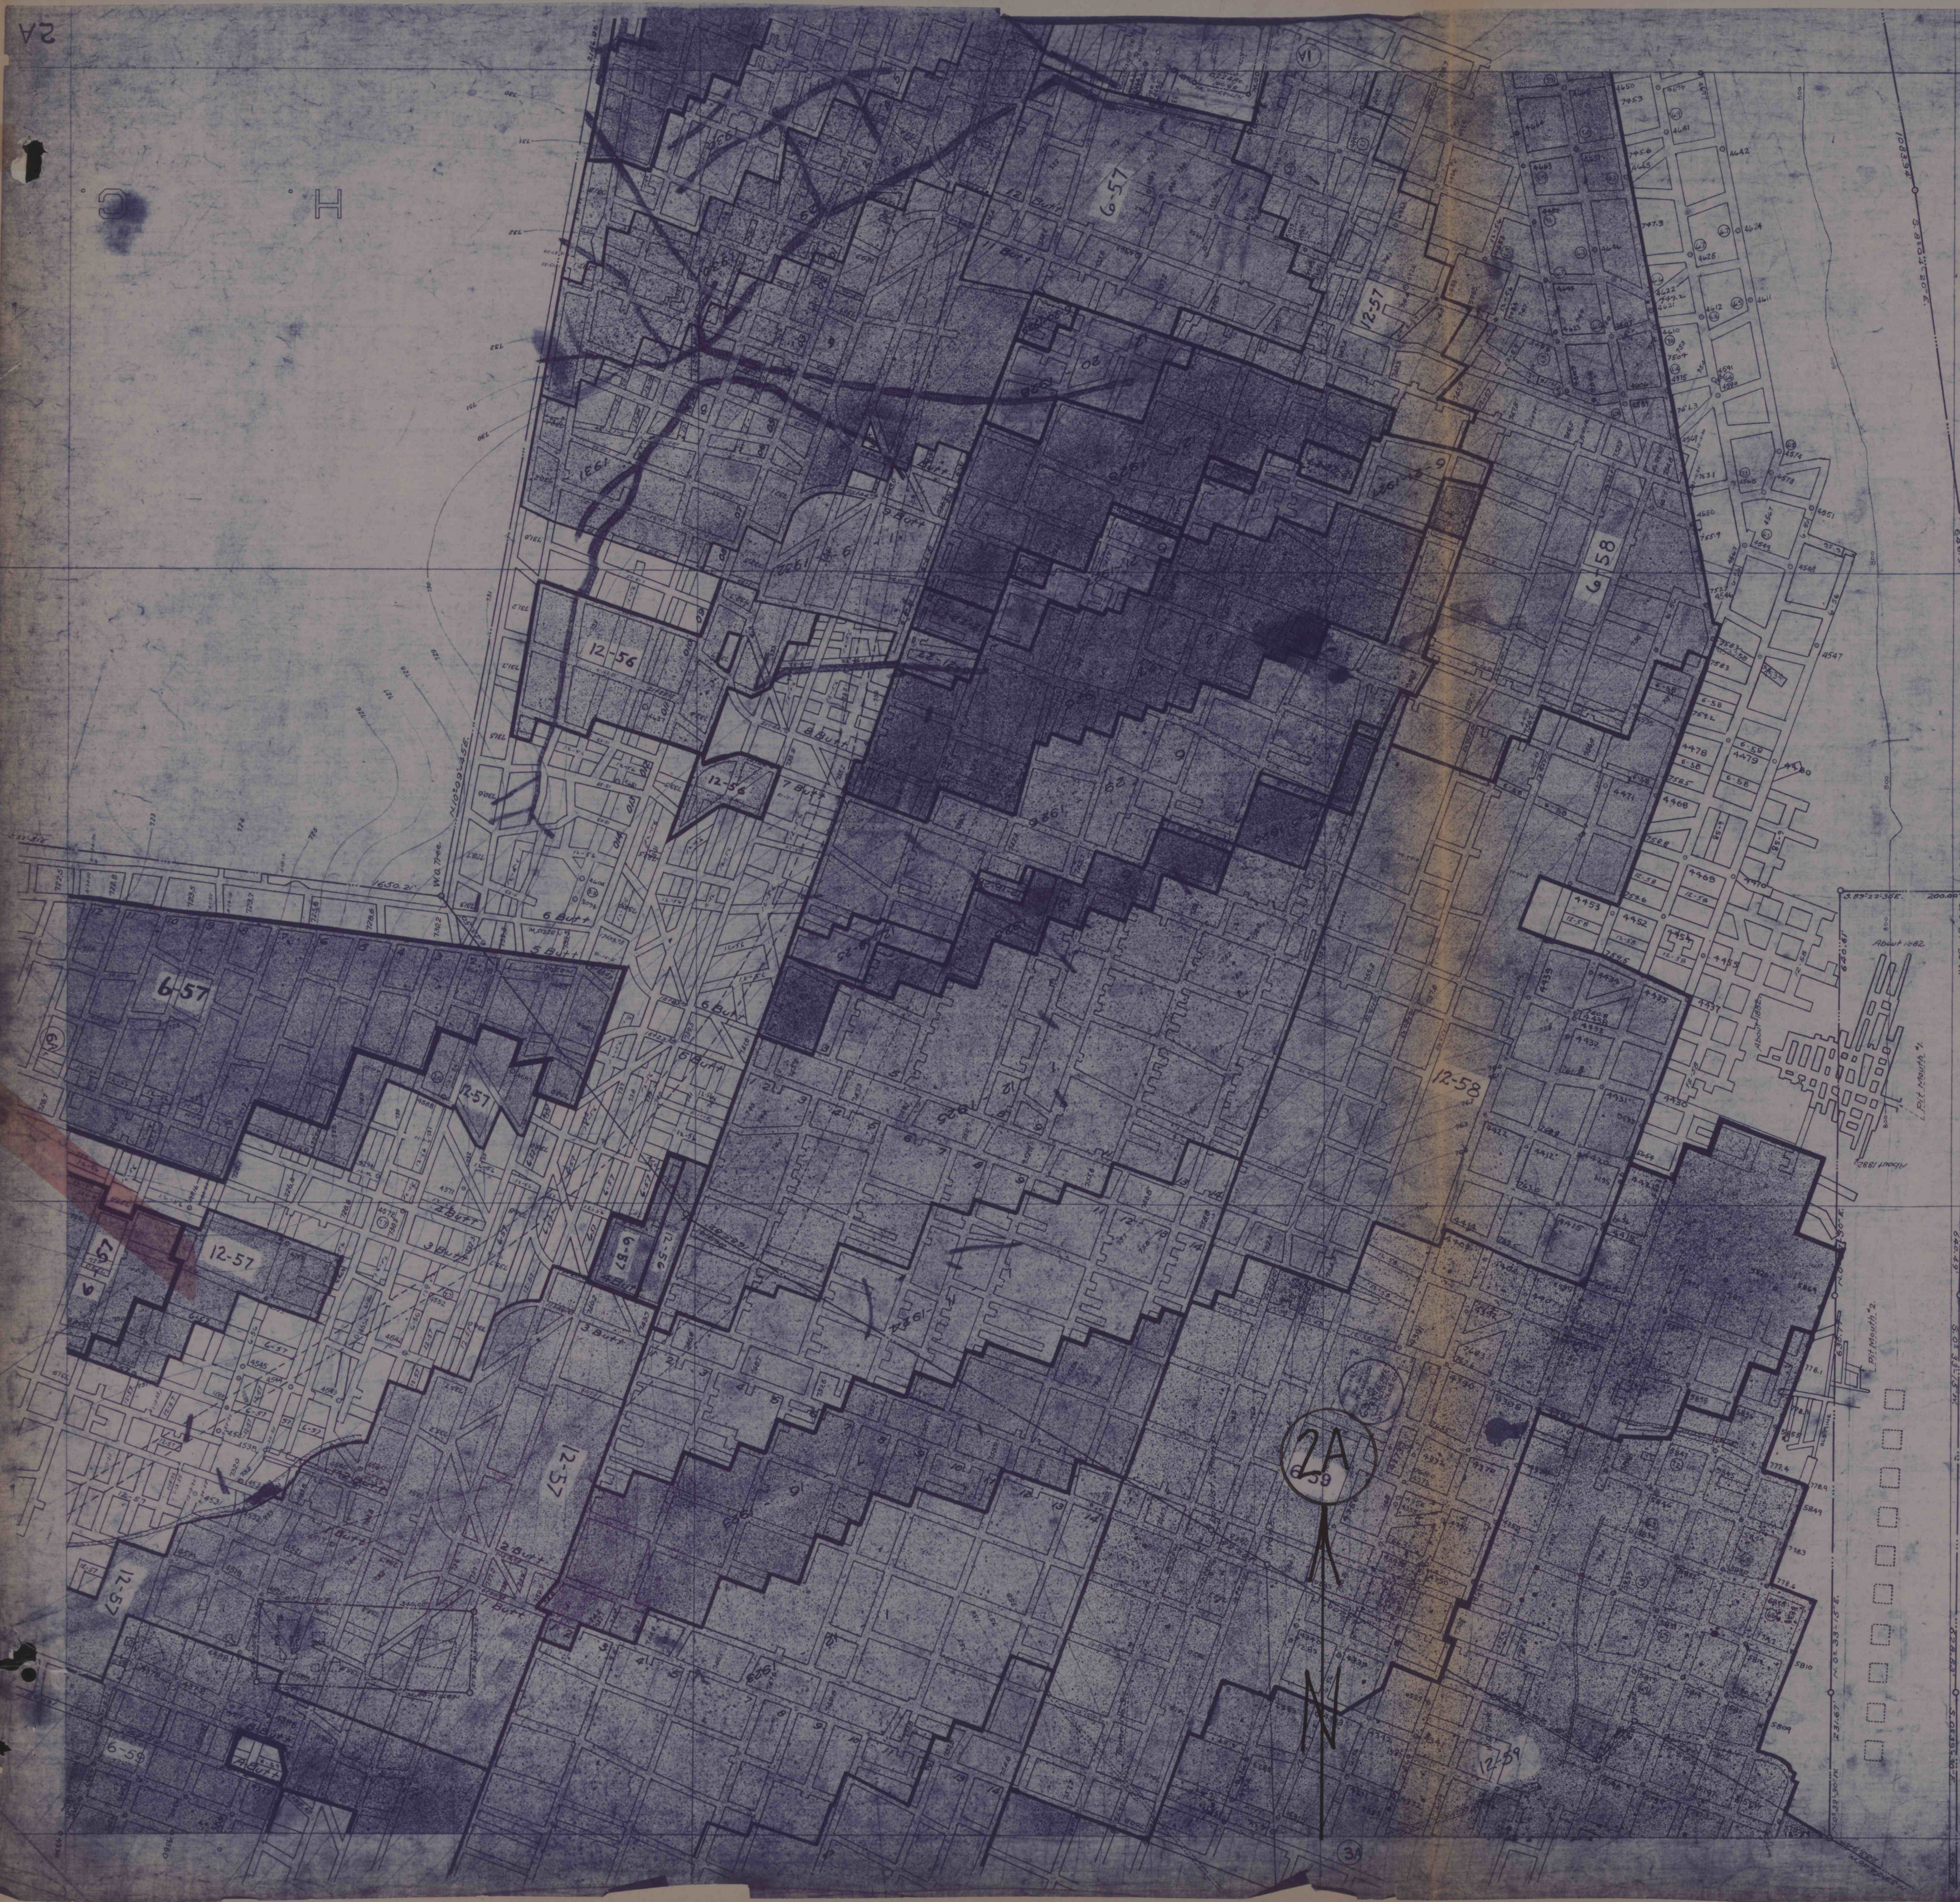

RECEIVED
DIVISION OF MINE
SUBSIDENCE REGULATION
JUL 27 1979
MURRAY
PENNSYLVANIA

DUQUESNE LIGHT CO.
COAL DEPARTMENT
WARWICK MINE NO. 2
SCALE: 1"=100'
MONONGAHELA TWP., GREENE COUNTY, PA.

John D. Taylor
RPE 24306

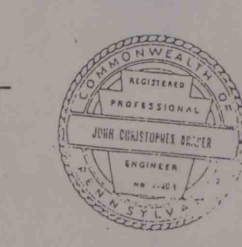

LEGEND
FINAL MAP, MINING WAS COMPLETED AT
THE END OF 6-22-79.

PROPERTY LINE
PROTECTED STRUCTURES
UNPROTECTED STRUCTURES (NEW, AFTER LAW)
STRUCTURES DEMOLISHED

FINAL

2A