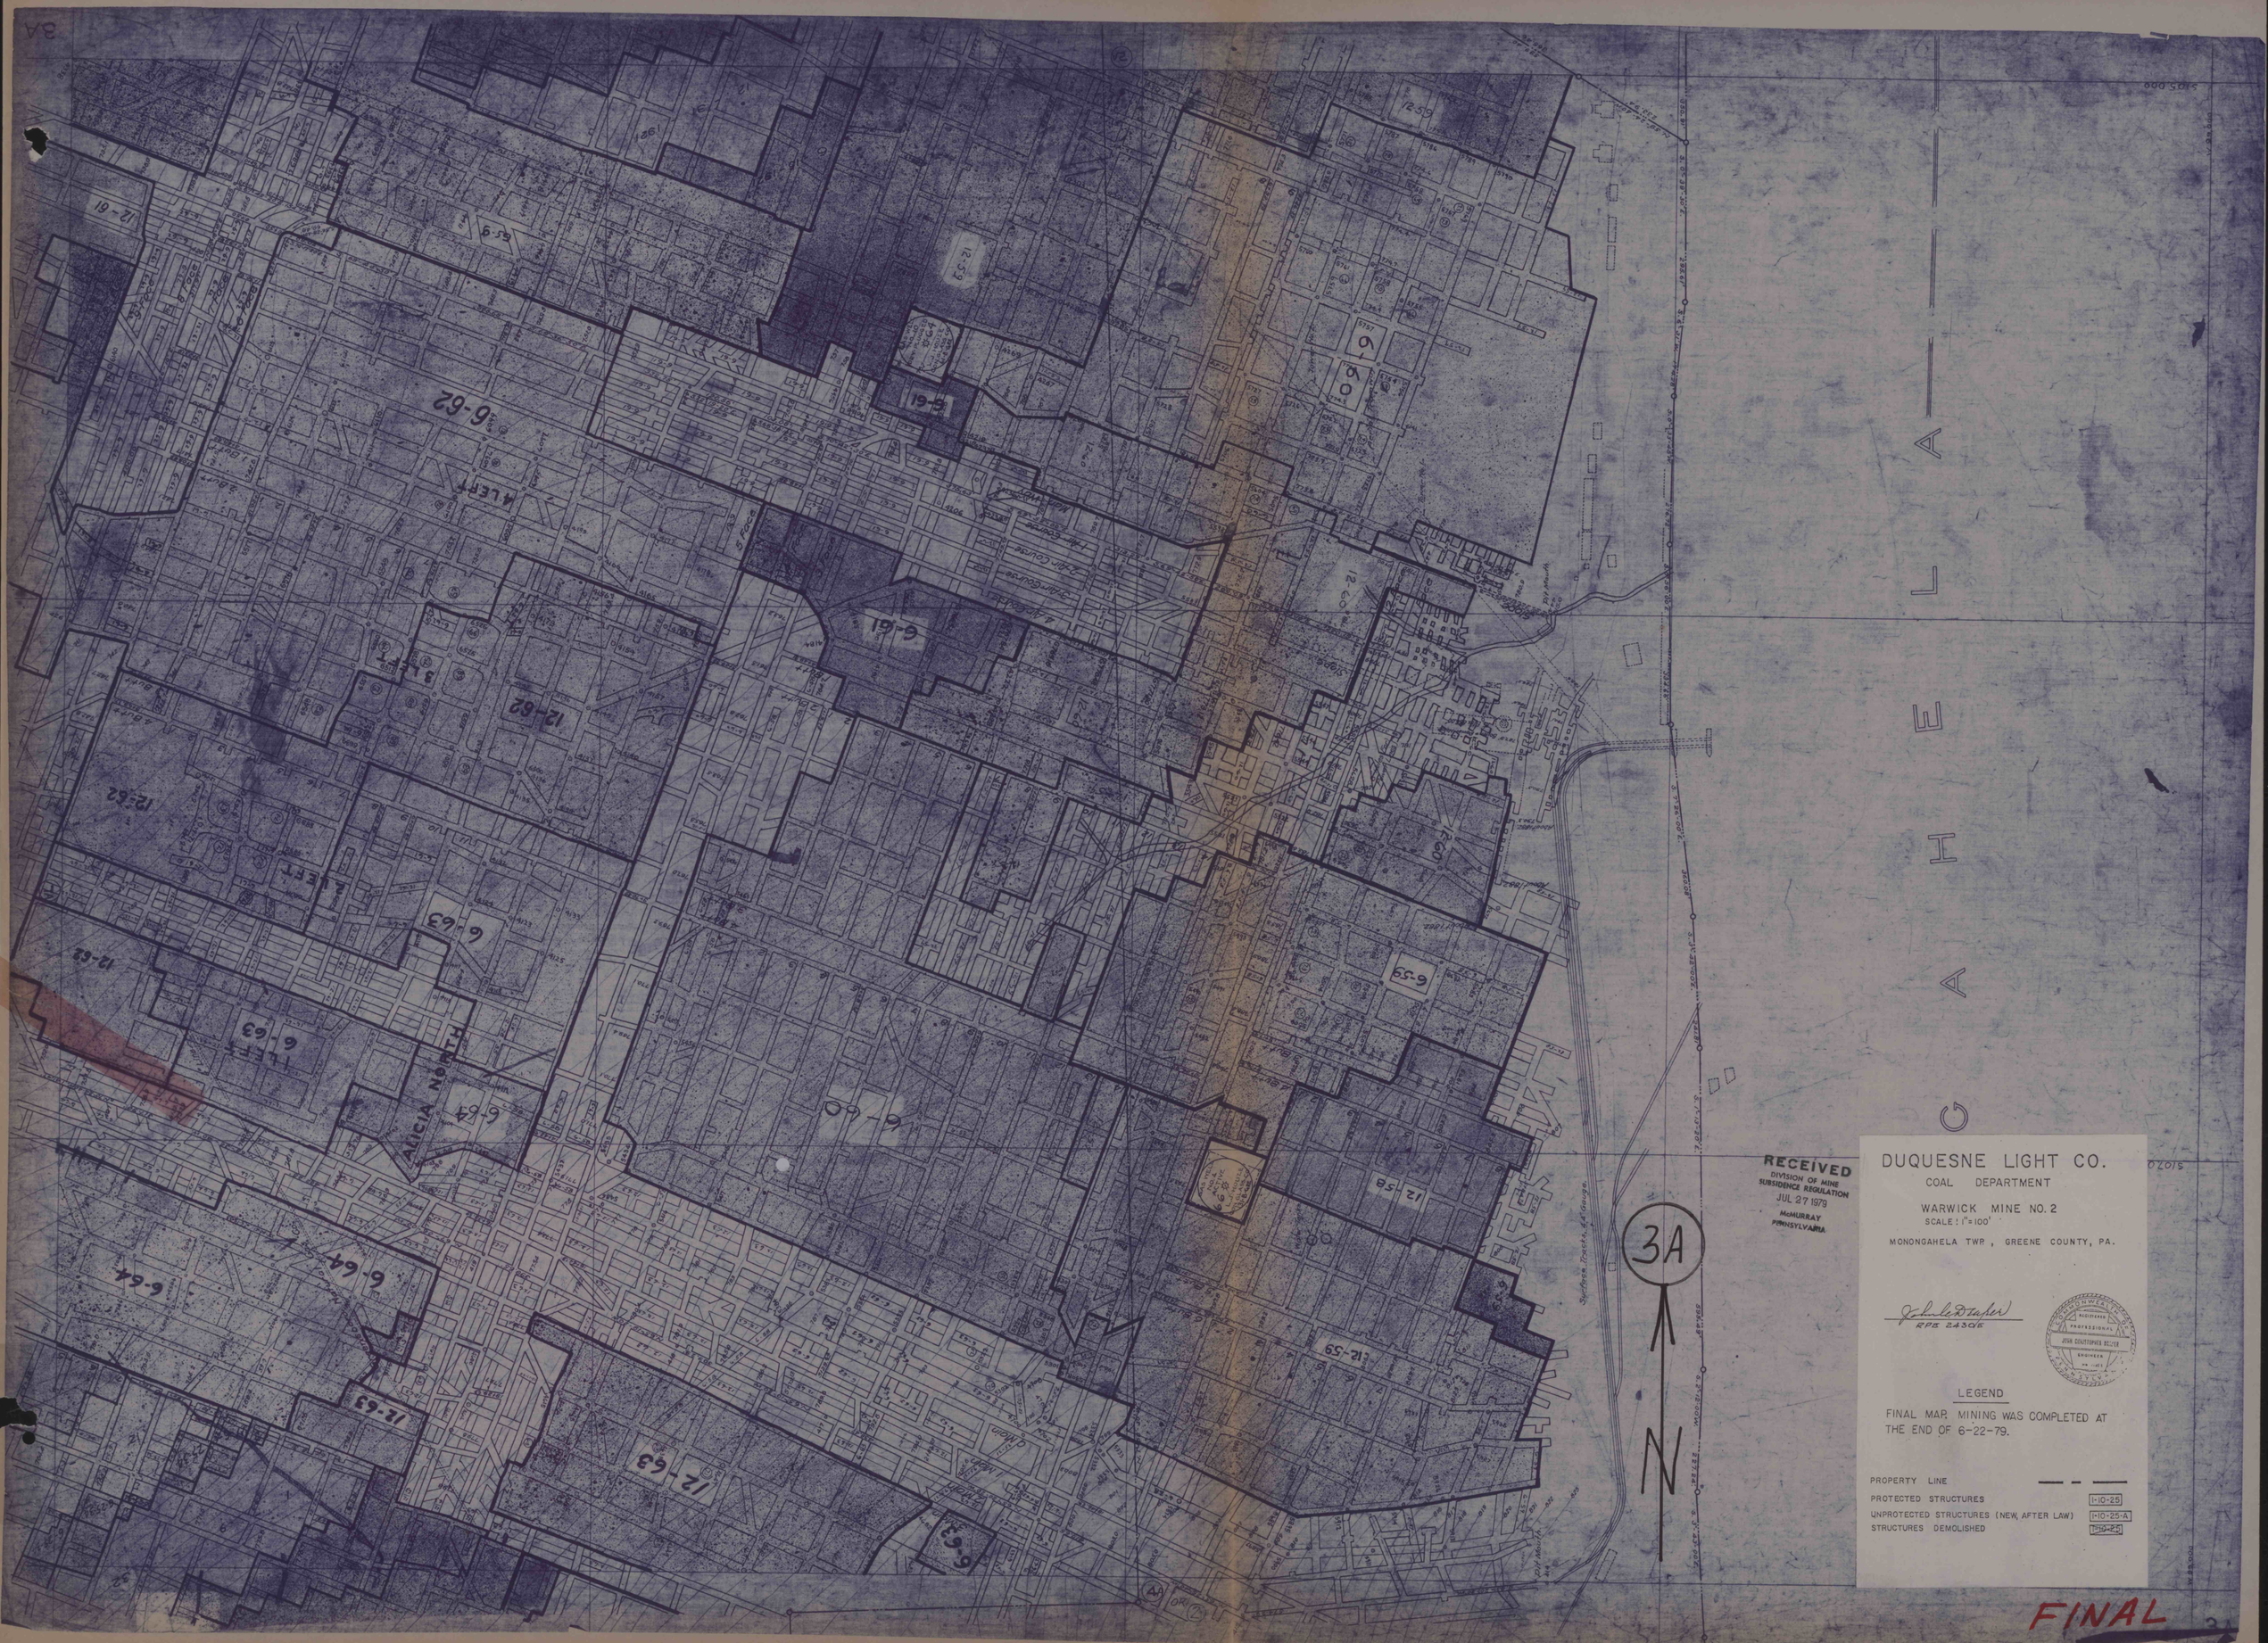
3A
N
RECEIVED
DIVISION OF MINE SUBSIDENCE REGULATION
JUL 27 1979
McMURRAY PENNSYLVANIA
DUQUESNE LIGHT CO.
COAL DEPARTMENT
WARWICK MINE NO. 2
SCALE: 1"=100'
MONONGAHELA TWP., GREENE COUNTY, PA.
RPE 24306
LEGEND
FINAL MAP. MINING WAS COMPLETED AT THE END OF 6-22-79.
PROPERTY LINE
PROTECTED STRUCTURES
UNPROTECTED STRUCTURES (NEW, AFTER LAW)
STRUCTURES DEMOLISHED
FINAL