


F R I C C O K E

DUQUESNE LIGHT CO.
COAL DEPARTMENT
WARWICK MINE NO. 2
SCALE: 1"=100'
MONONGAHELA TWP., GREENE COUNTY, PA.

John L. Disher
RPS 24306

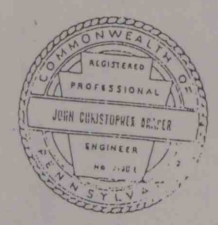


LEGEND

RECEIVED
DIVISION OF MINE
SUBSIDIARY REGULATION
JUL 27 1979
M. MURRAY
PENNSYLVANIA

FINAL MAP MINING WAS COMPLETED AT
THE END OF 6-22-79.

- PROPERTY LINE
- PROTECTED STRUCTURES
- UNPROTECTED STRUCTURES (NEW, AFTER LAW)
- STRUCTURES DEMOLISHED

1-10-25
1-10-25-A
1-10-25

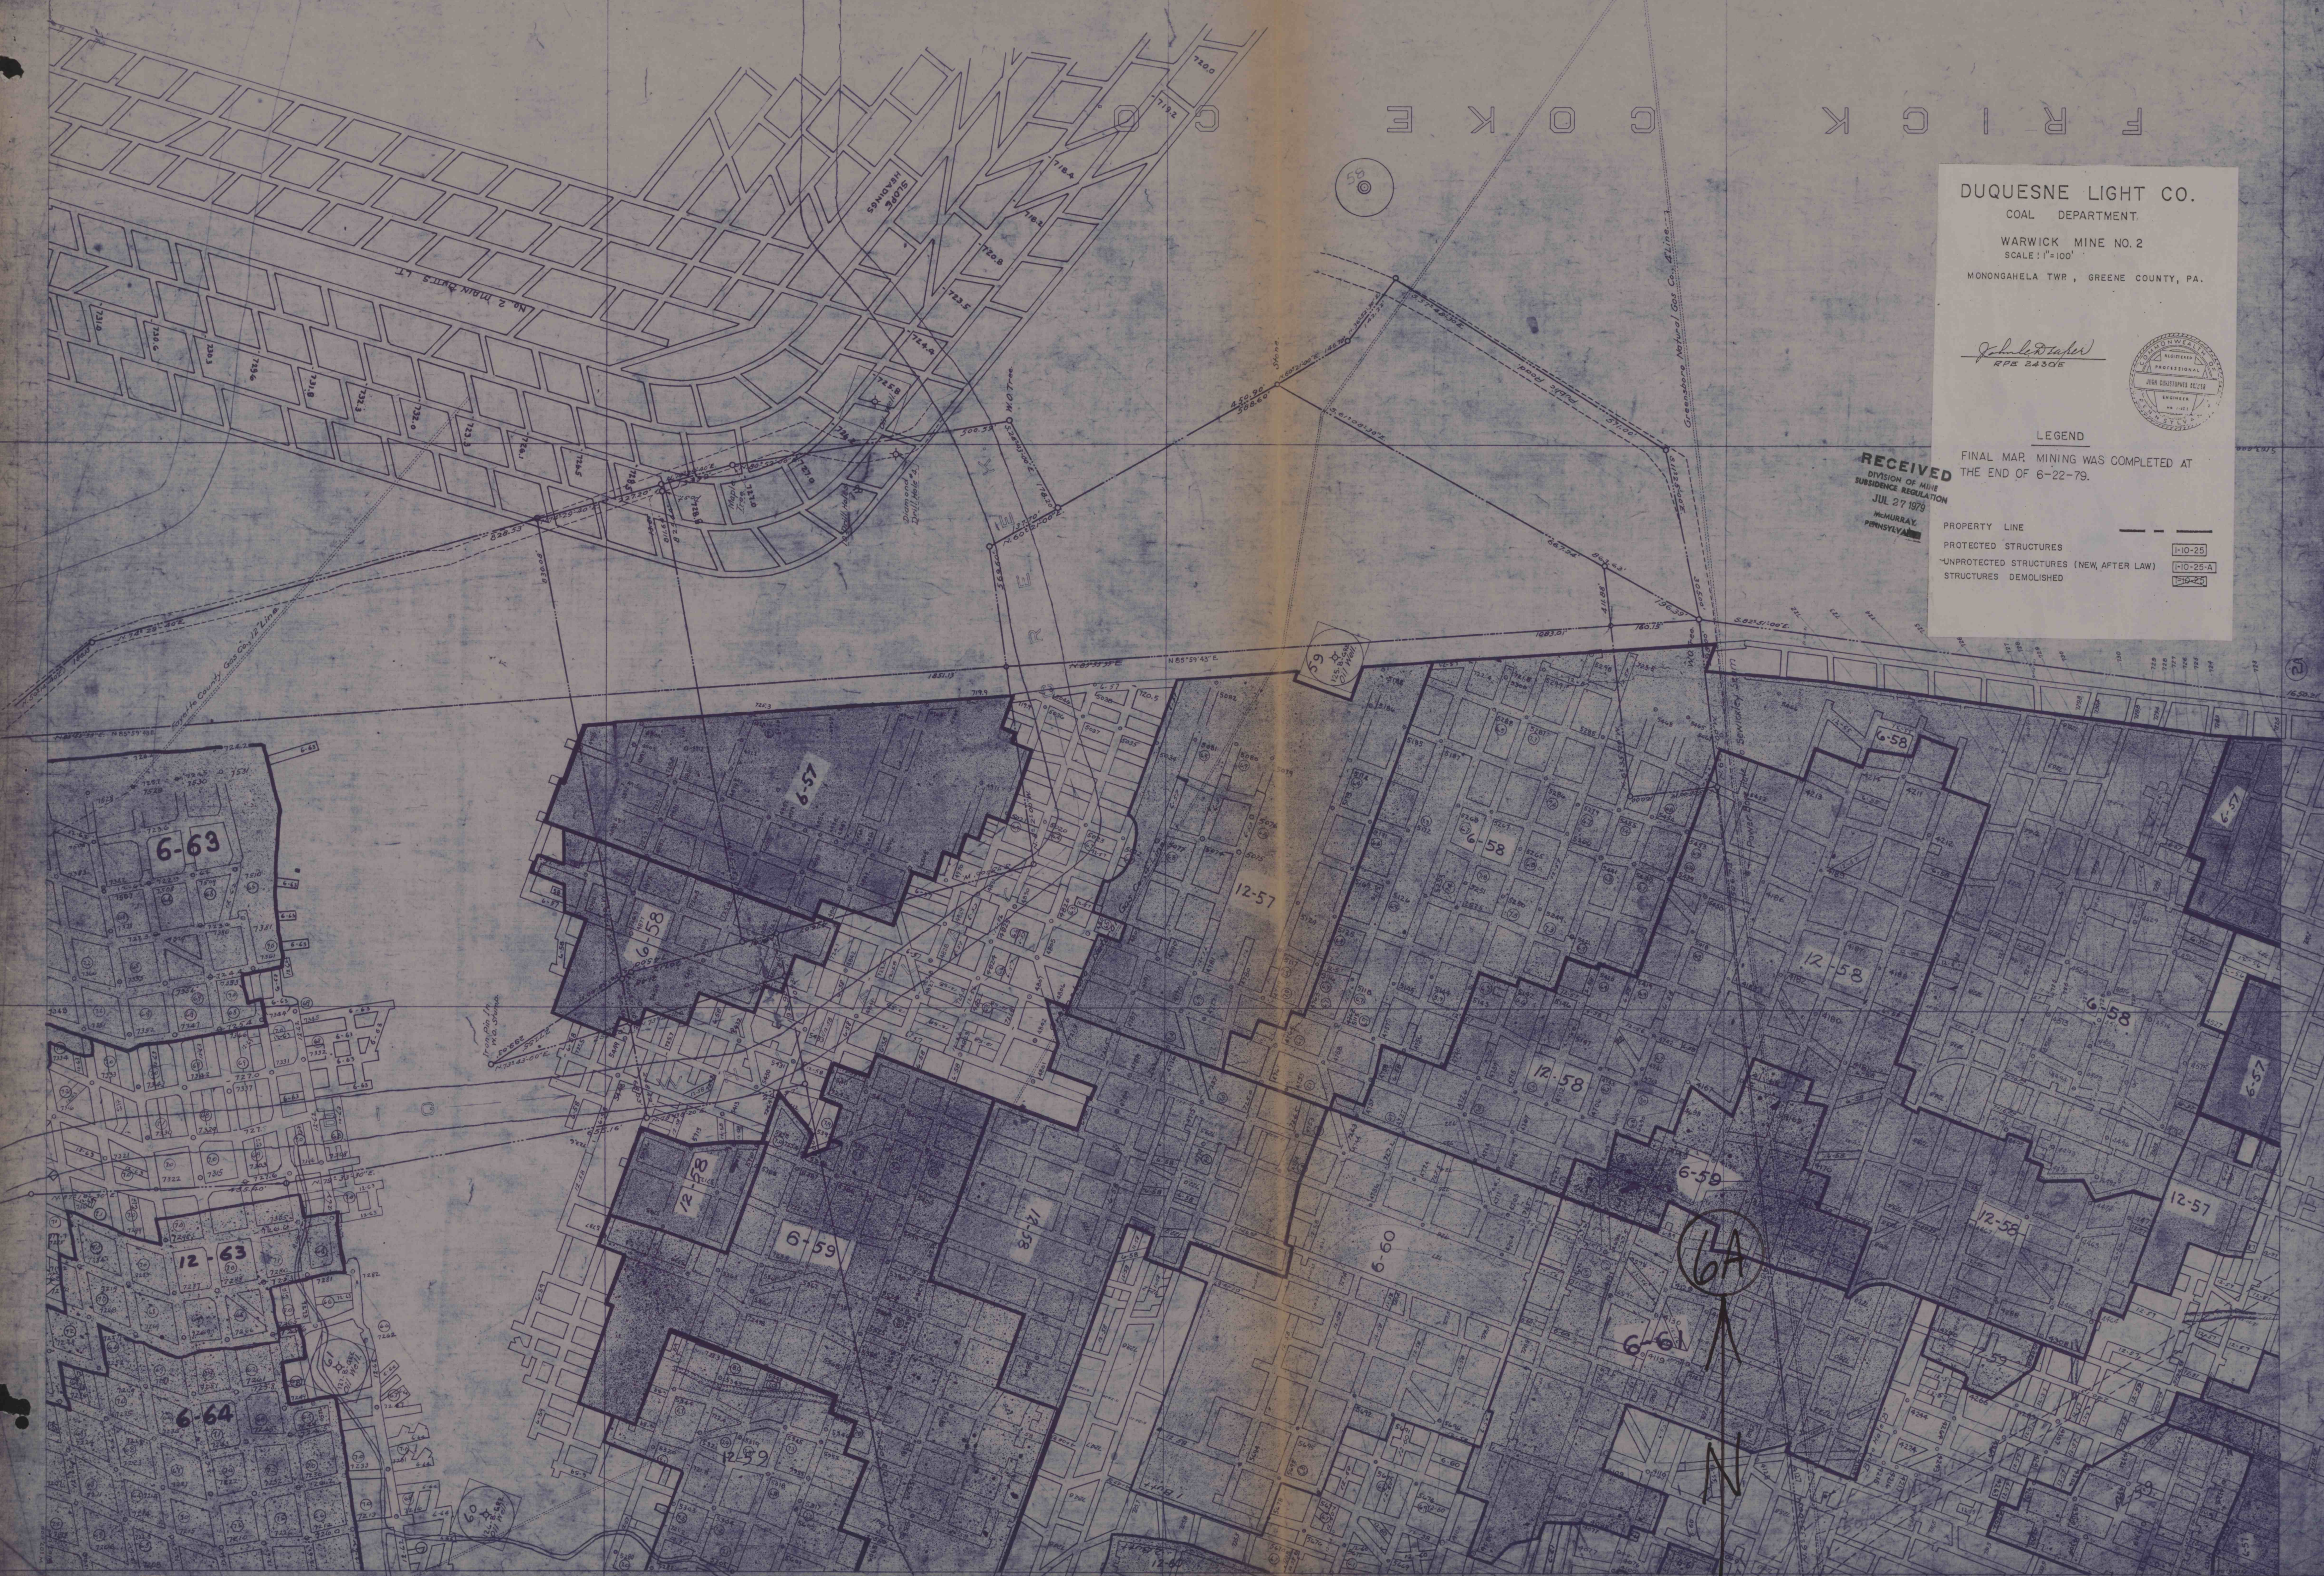

FINAL