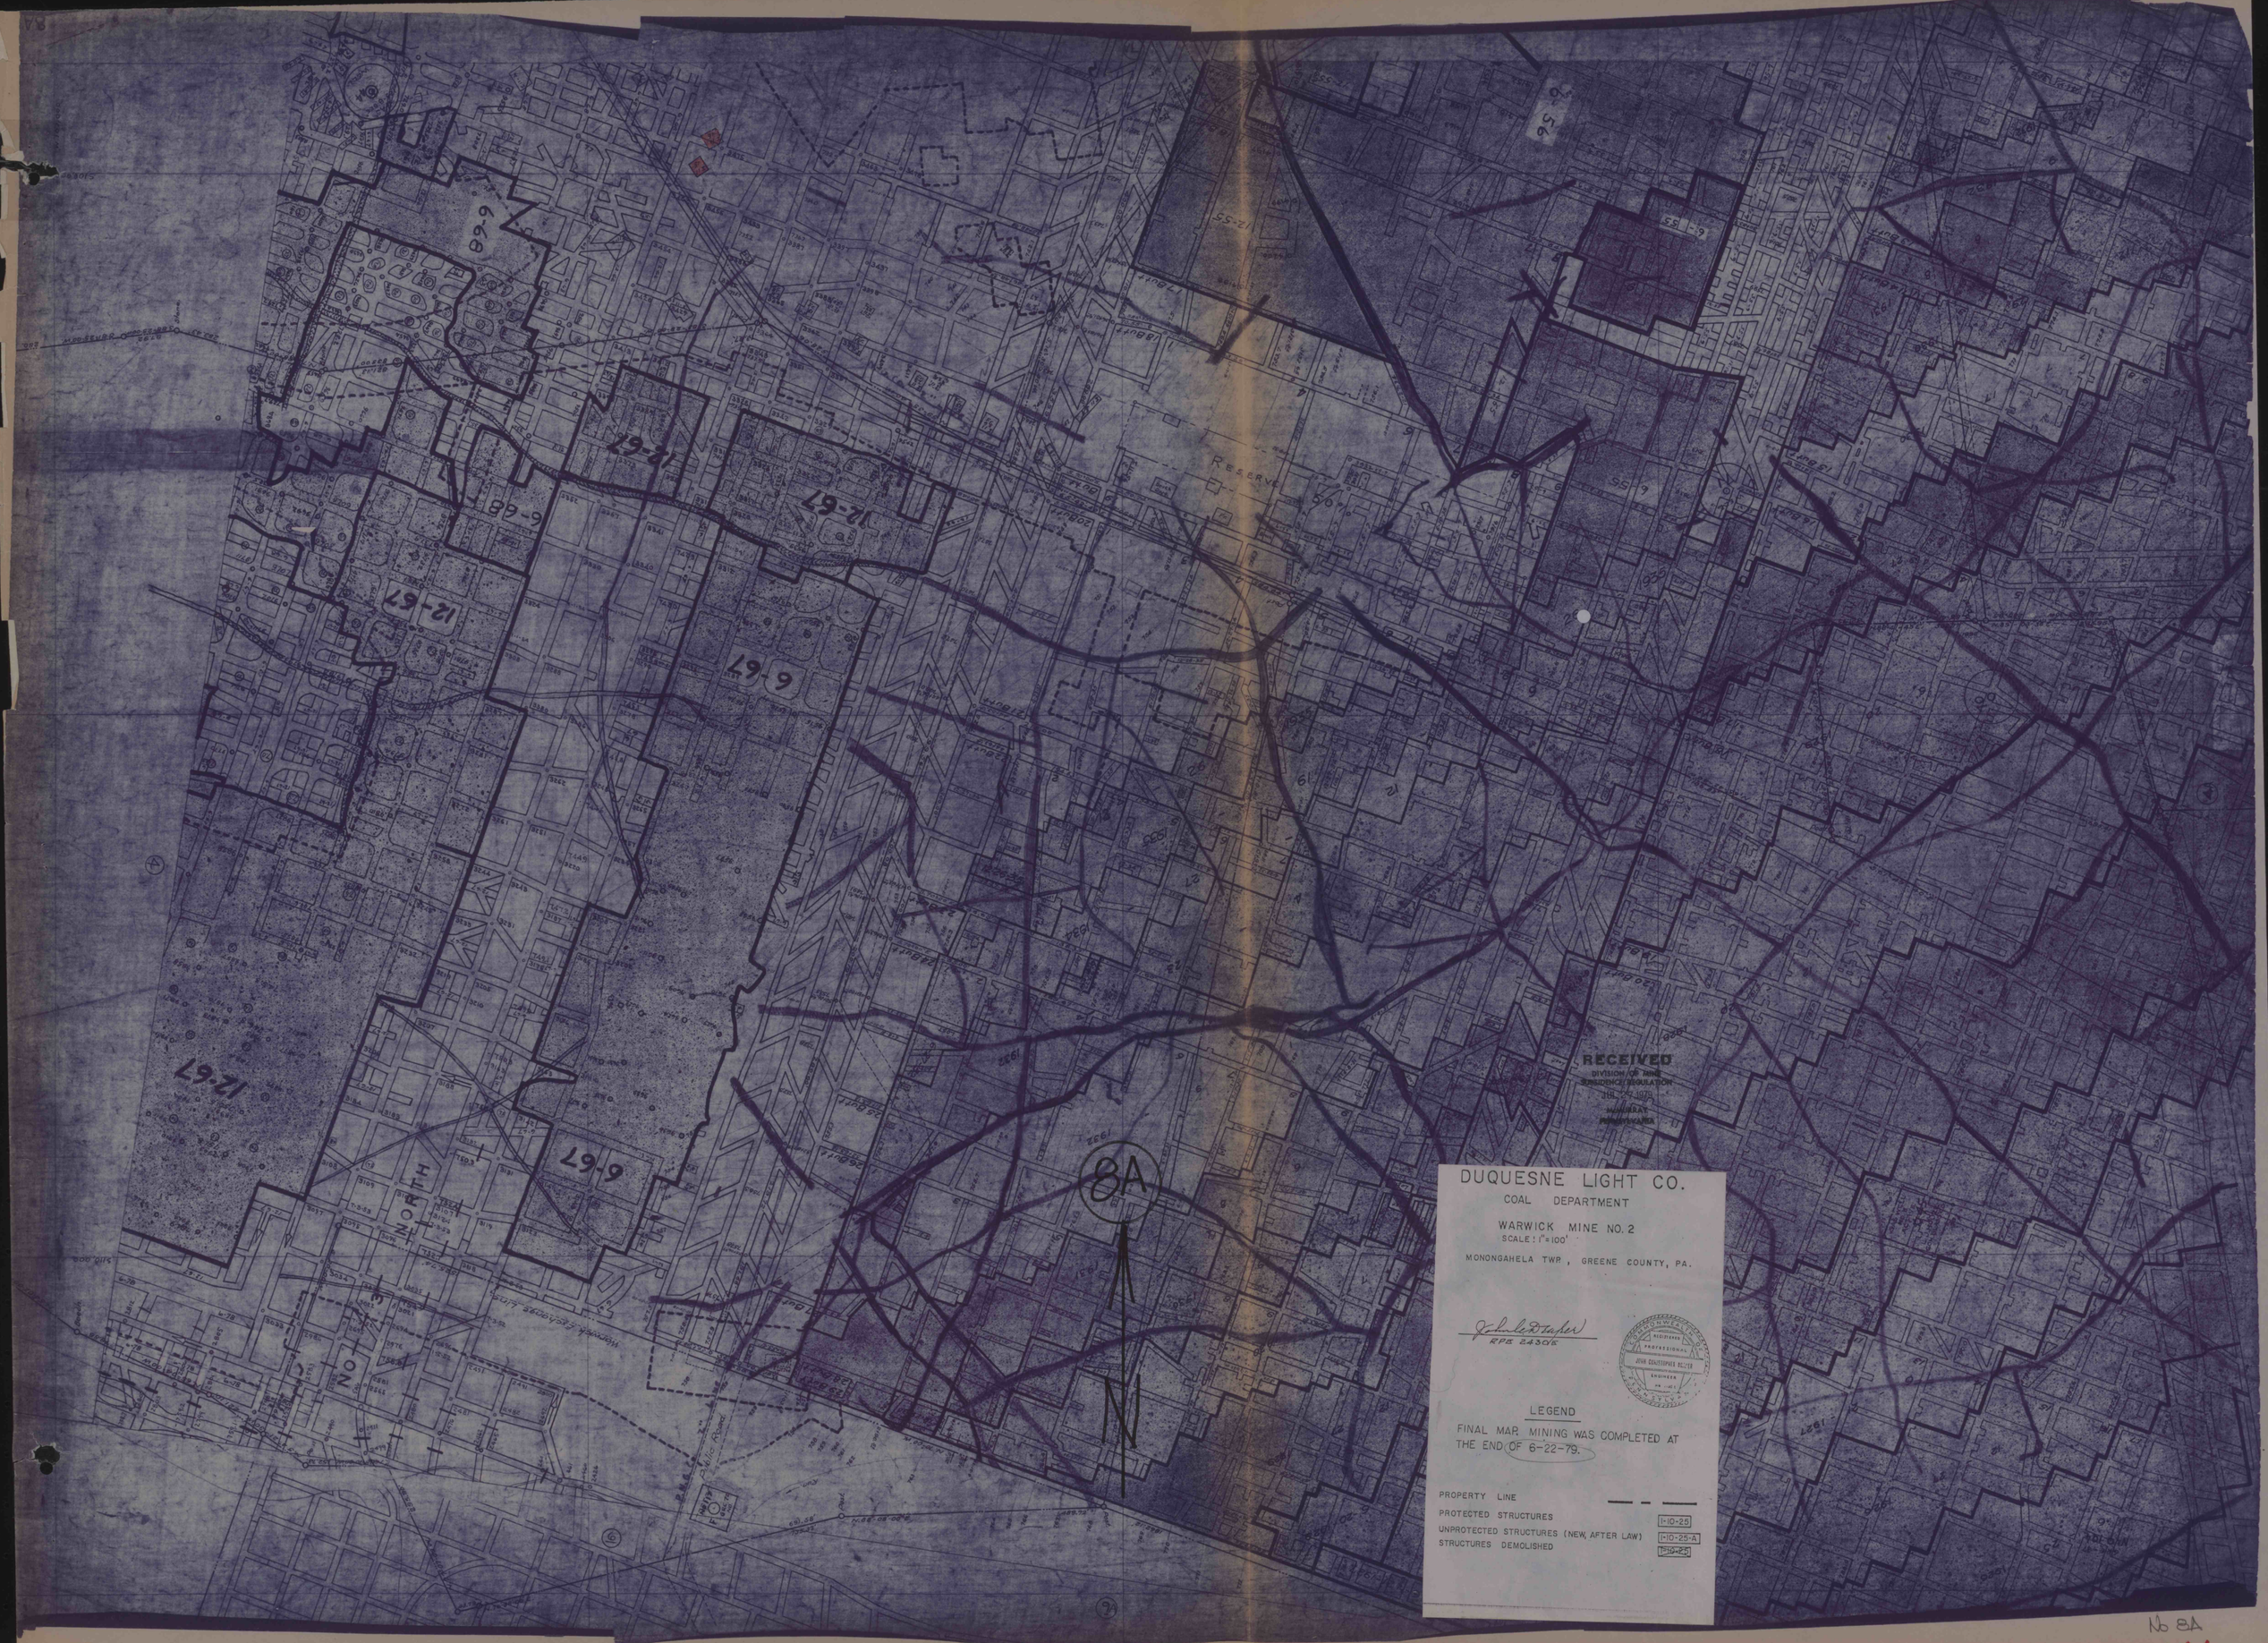
DUQUESNE LIGHT CO.
COAL DEPARTMENT
WARWICK MINE NO. 2
SCALE: 1"=100'
MONONGAHELA TWP., GREENE COUNTY, PA.
RPE 24306
LEGEND
FINAL MAP. MINING WAS COMPLETED AT THE END OF 6-22-79.
PROPERTY LINE
PROTECTED STRUCTURES
UNPROTECTED STRUCTURES (NEW, AFTER LAW)
STRUCTURES DEMOLISHED
RECEIVED
DIVISION OF MINE SUBSIDENCE REGULATION
MONONGAHELA
PENNSYLVANIA
8A
N
6-68
12-67
6-67
6-56
6-55
12-55
RESERVE
NORTH
SOUTH
Public Road
No 8A
FINAL