


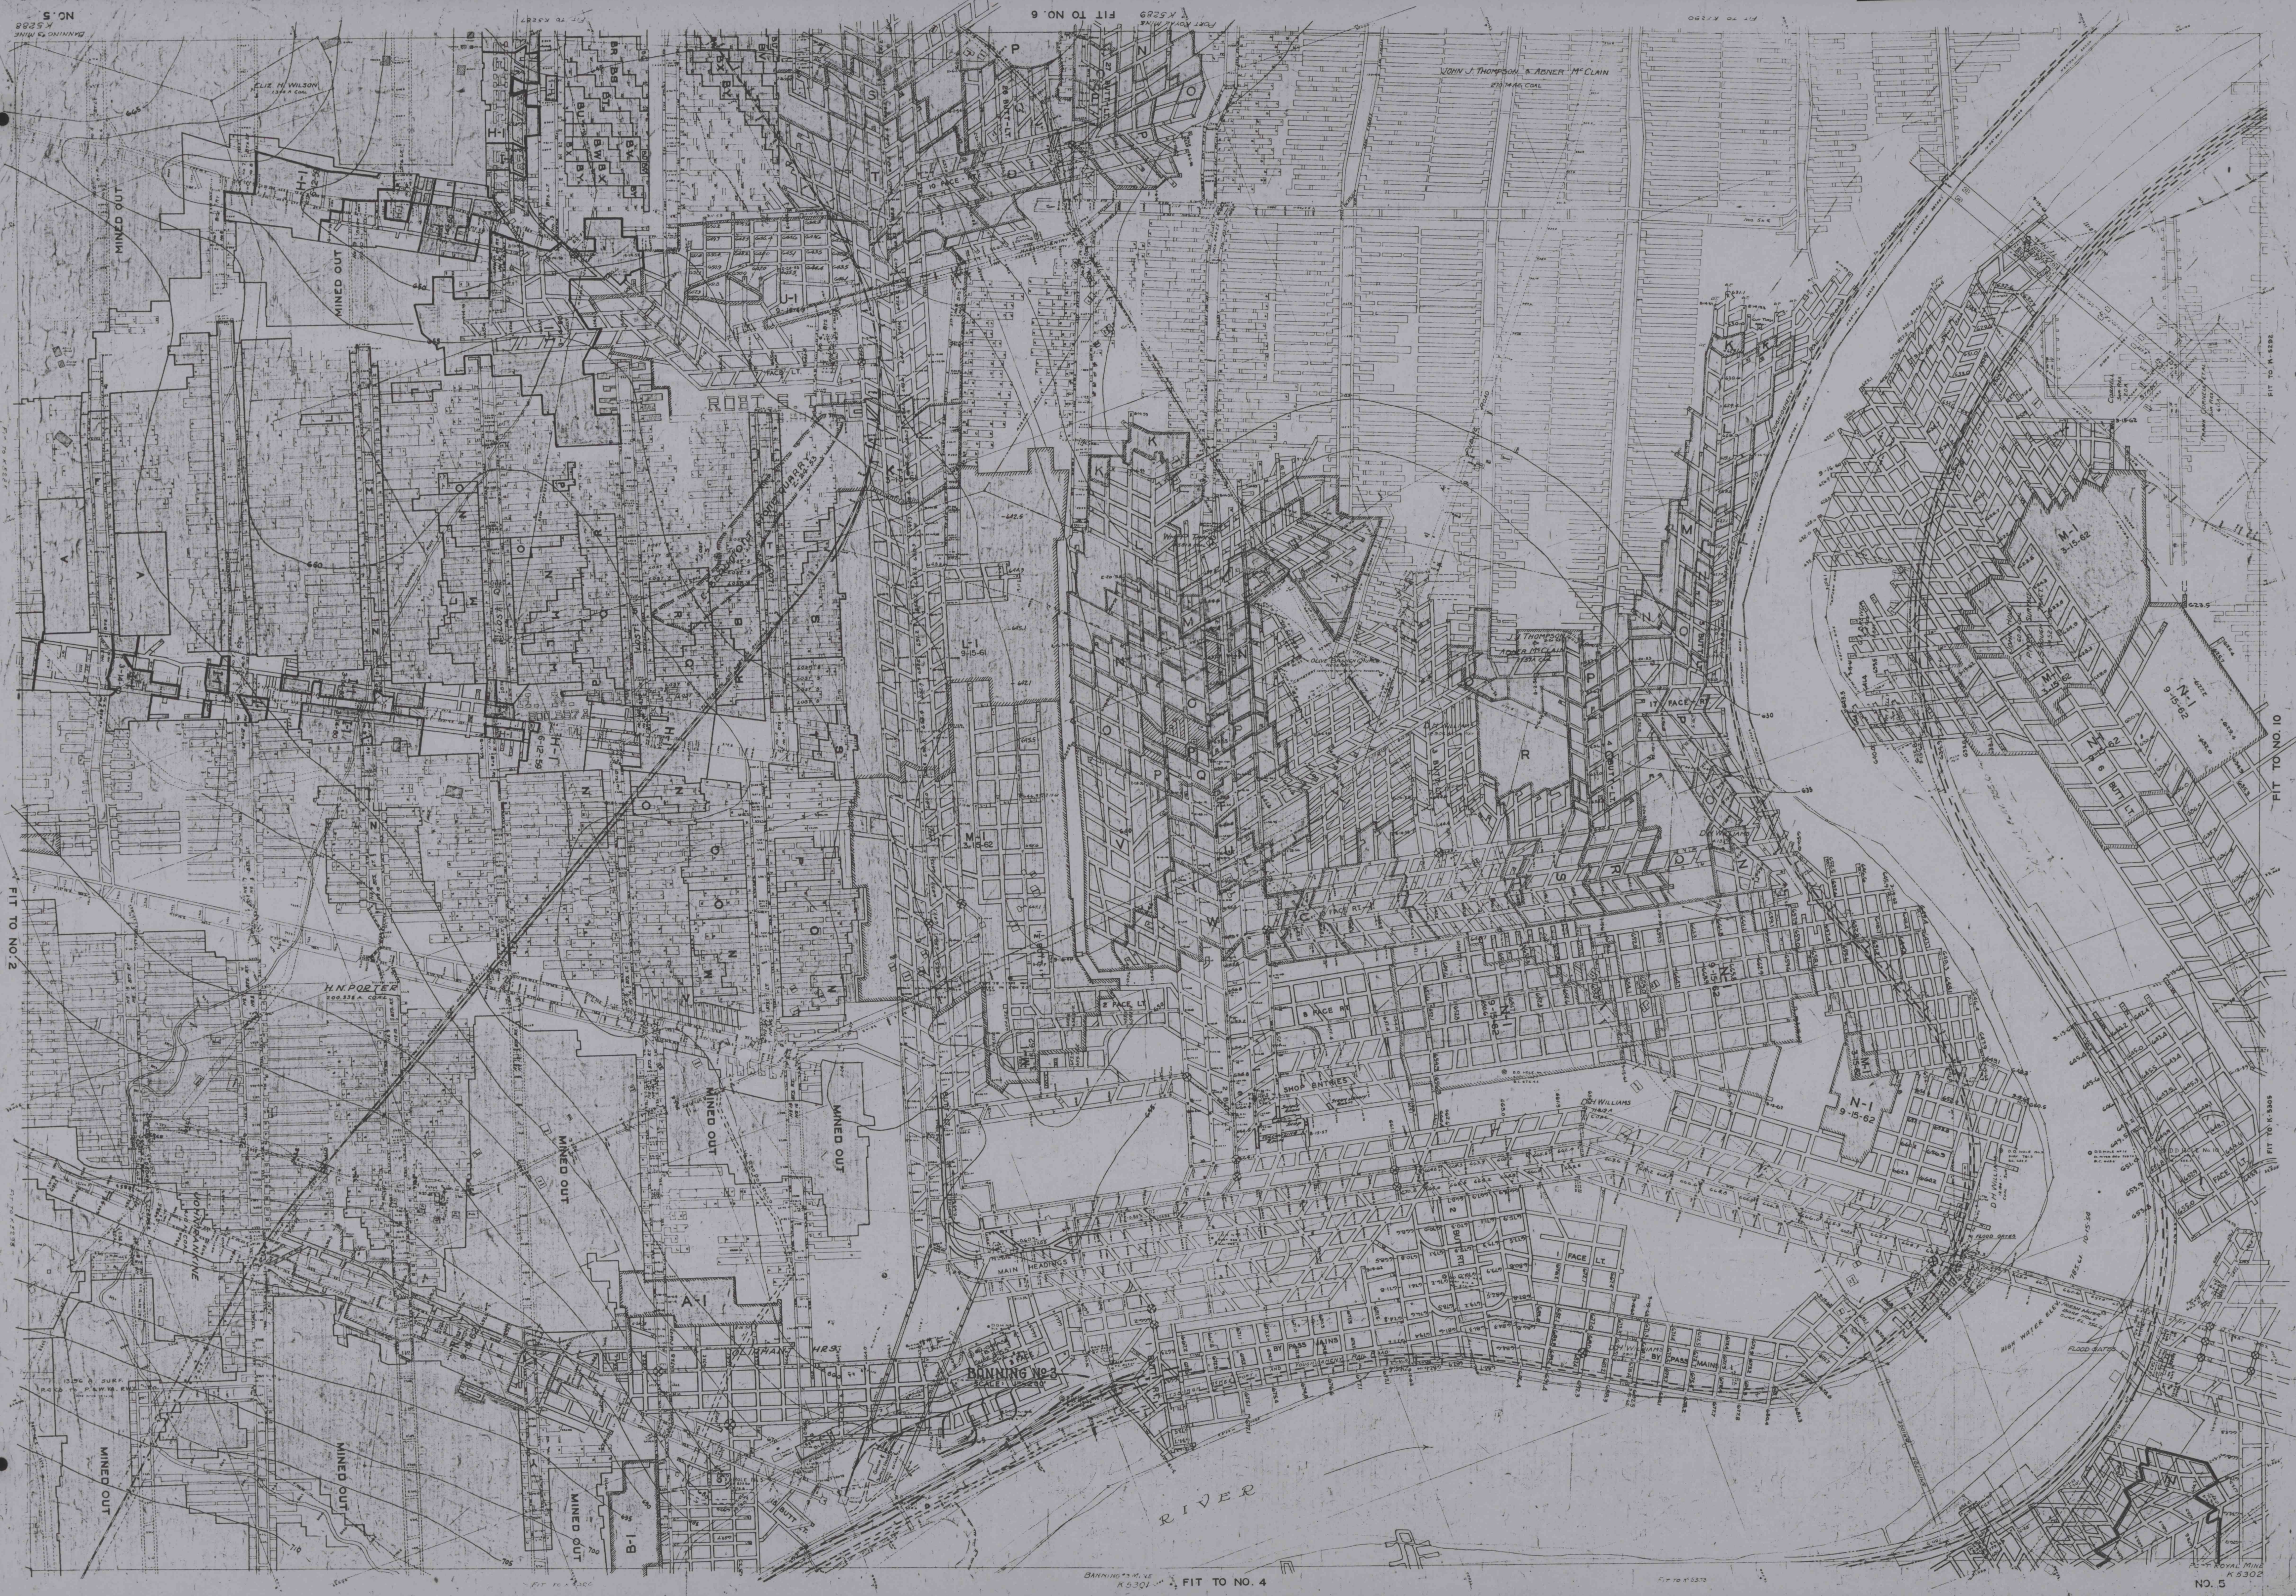

NO. 5
FIT TO NO. 2

NO. 5
FIT TO NO. 4

NO. 5
FIT TO NO. 10