


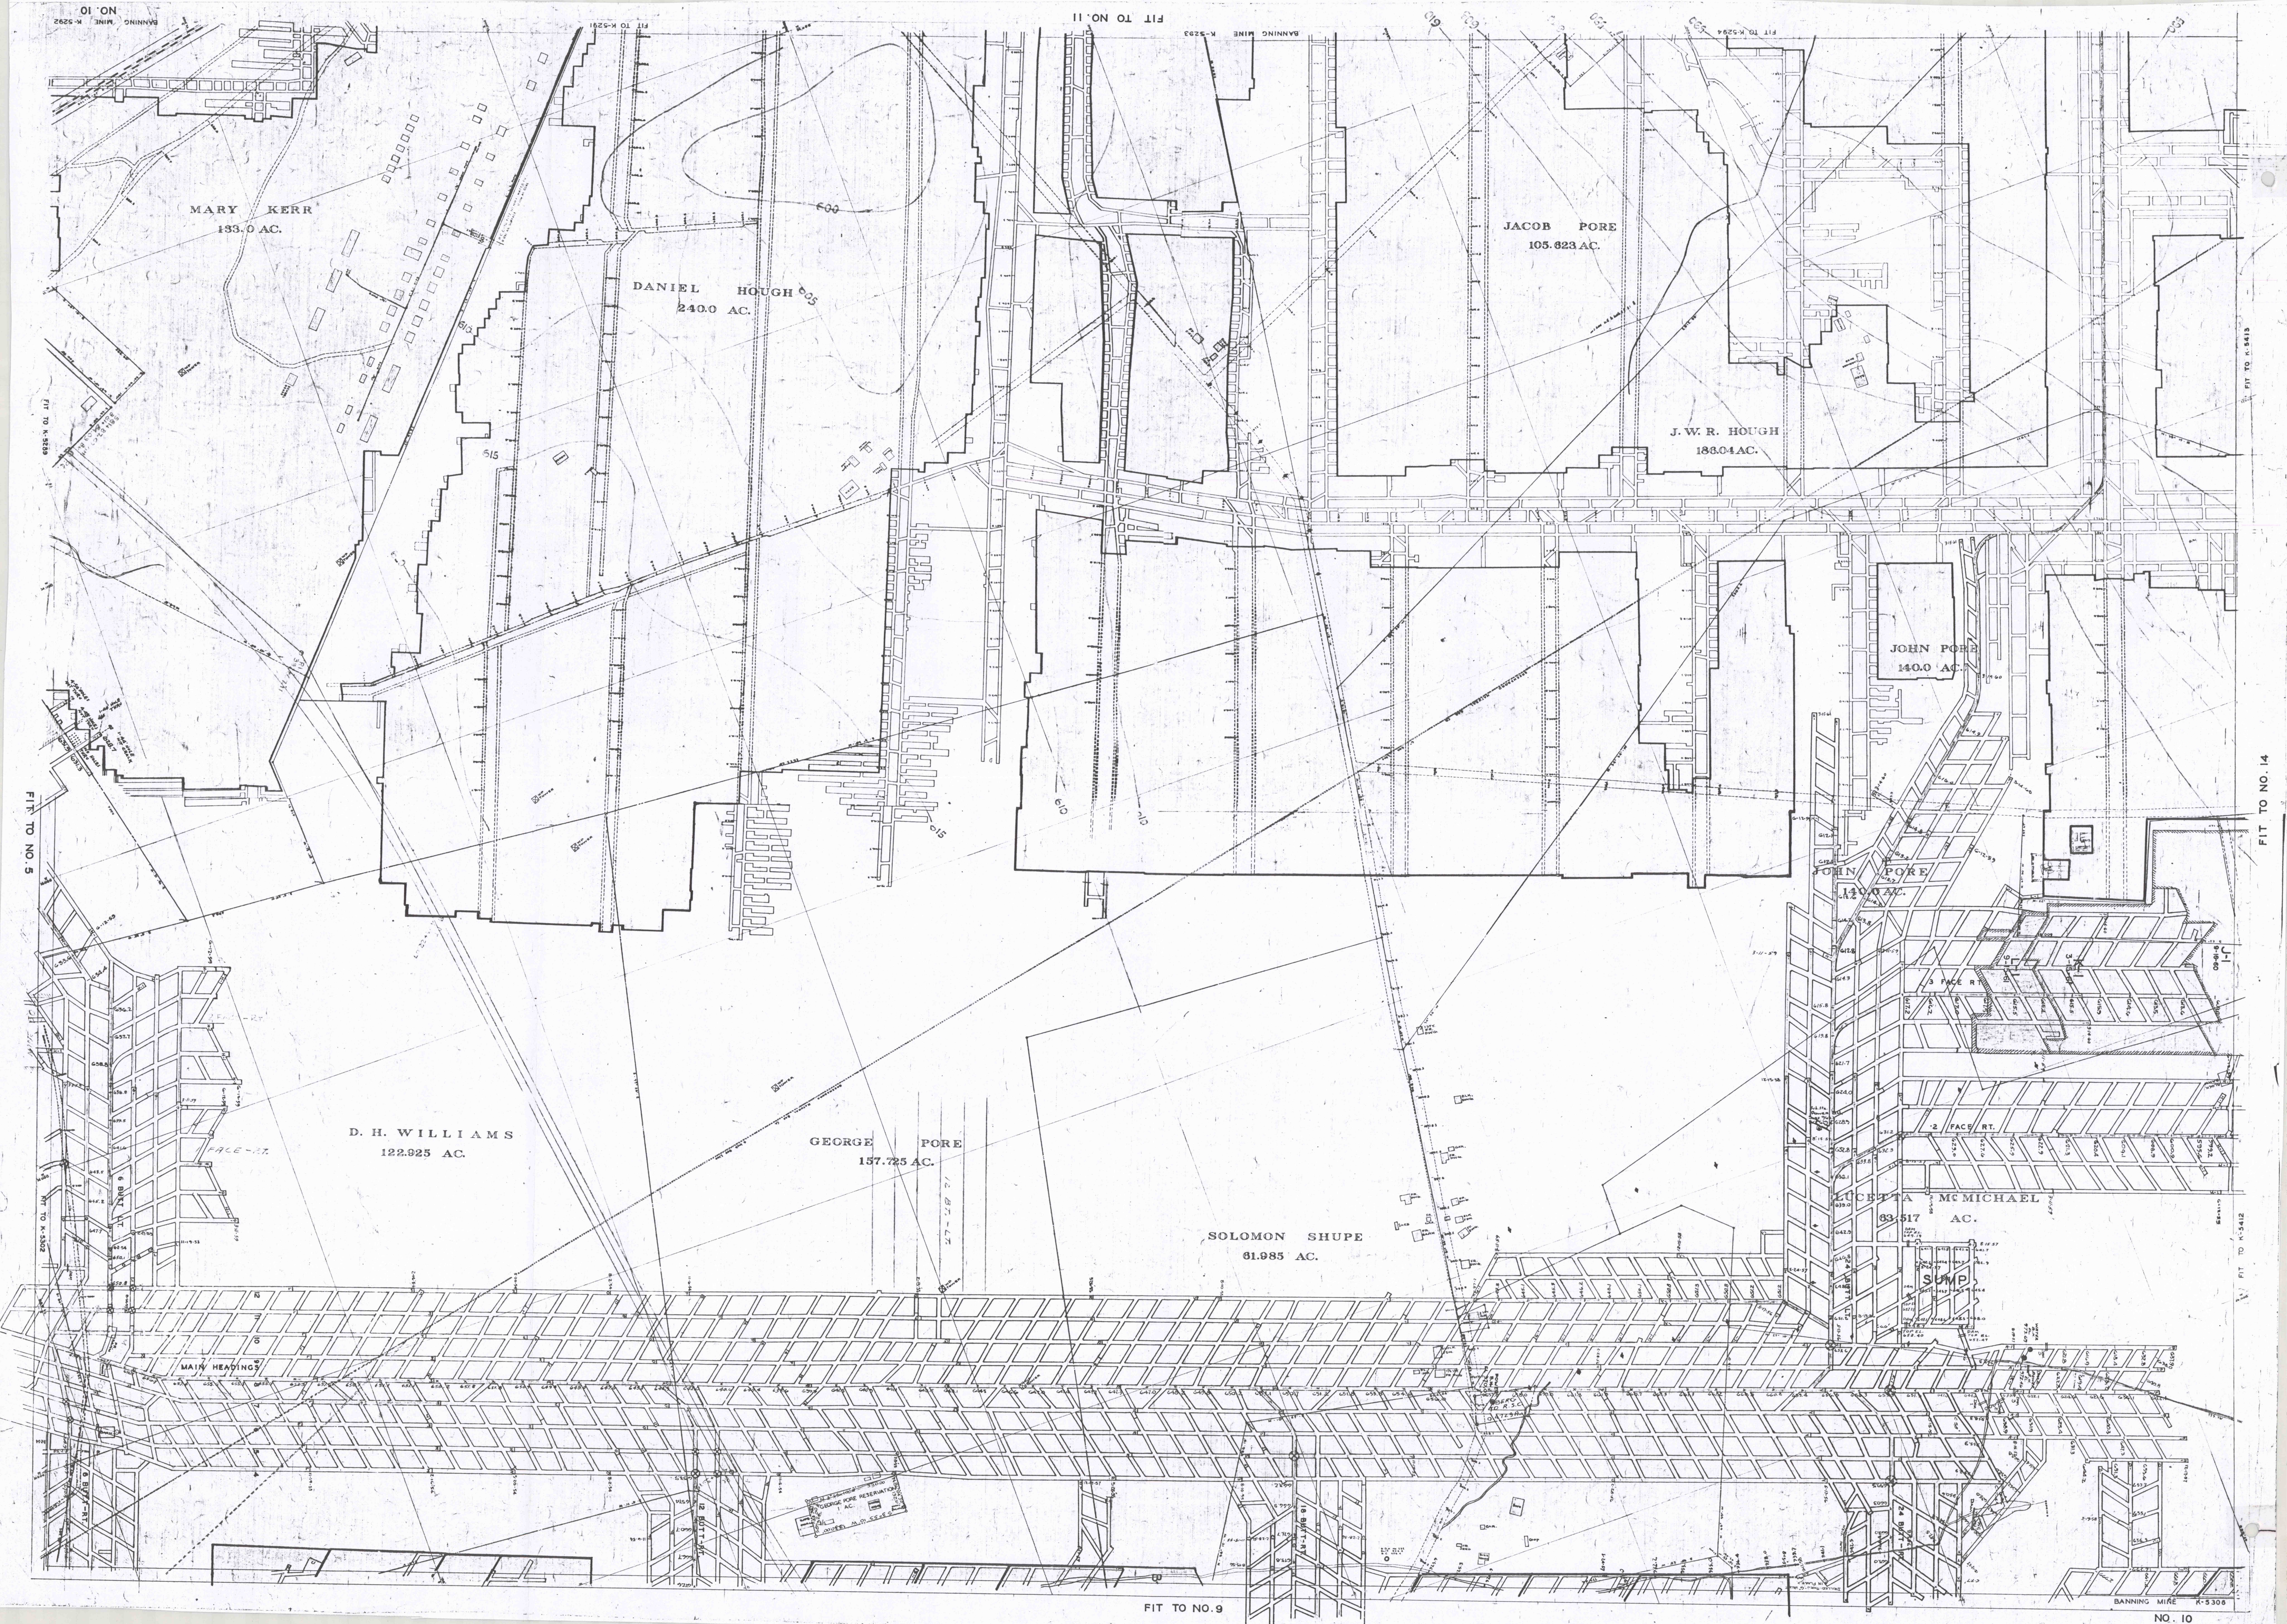

MARY KERR
193.0 AC.

DANIEL HOUGH
240.0 AC.

JACOB PORE
105.823 AC.

J.W.R. HOUGH
183.04 AC.

JOHN PORE
140.0 AC.

D.H. WILLIAMS
122.925 AC.

GEORGE PORE
157.725 AC.

SOLOMON SHUPE
81.985 AC.

LUCETTA MCMICHAEL
83.517 AC.

SMP

FIT TO NO. 9

NO. 10