


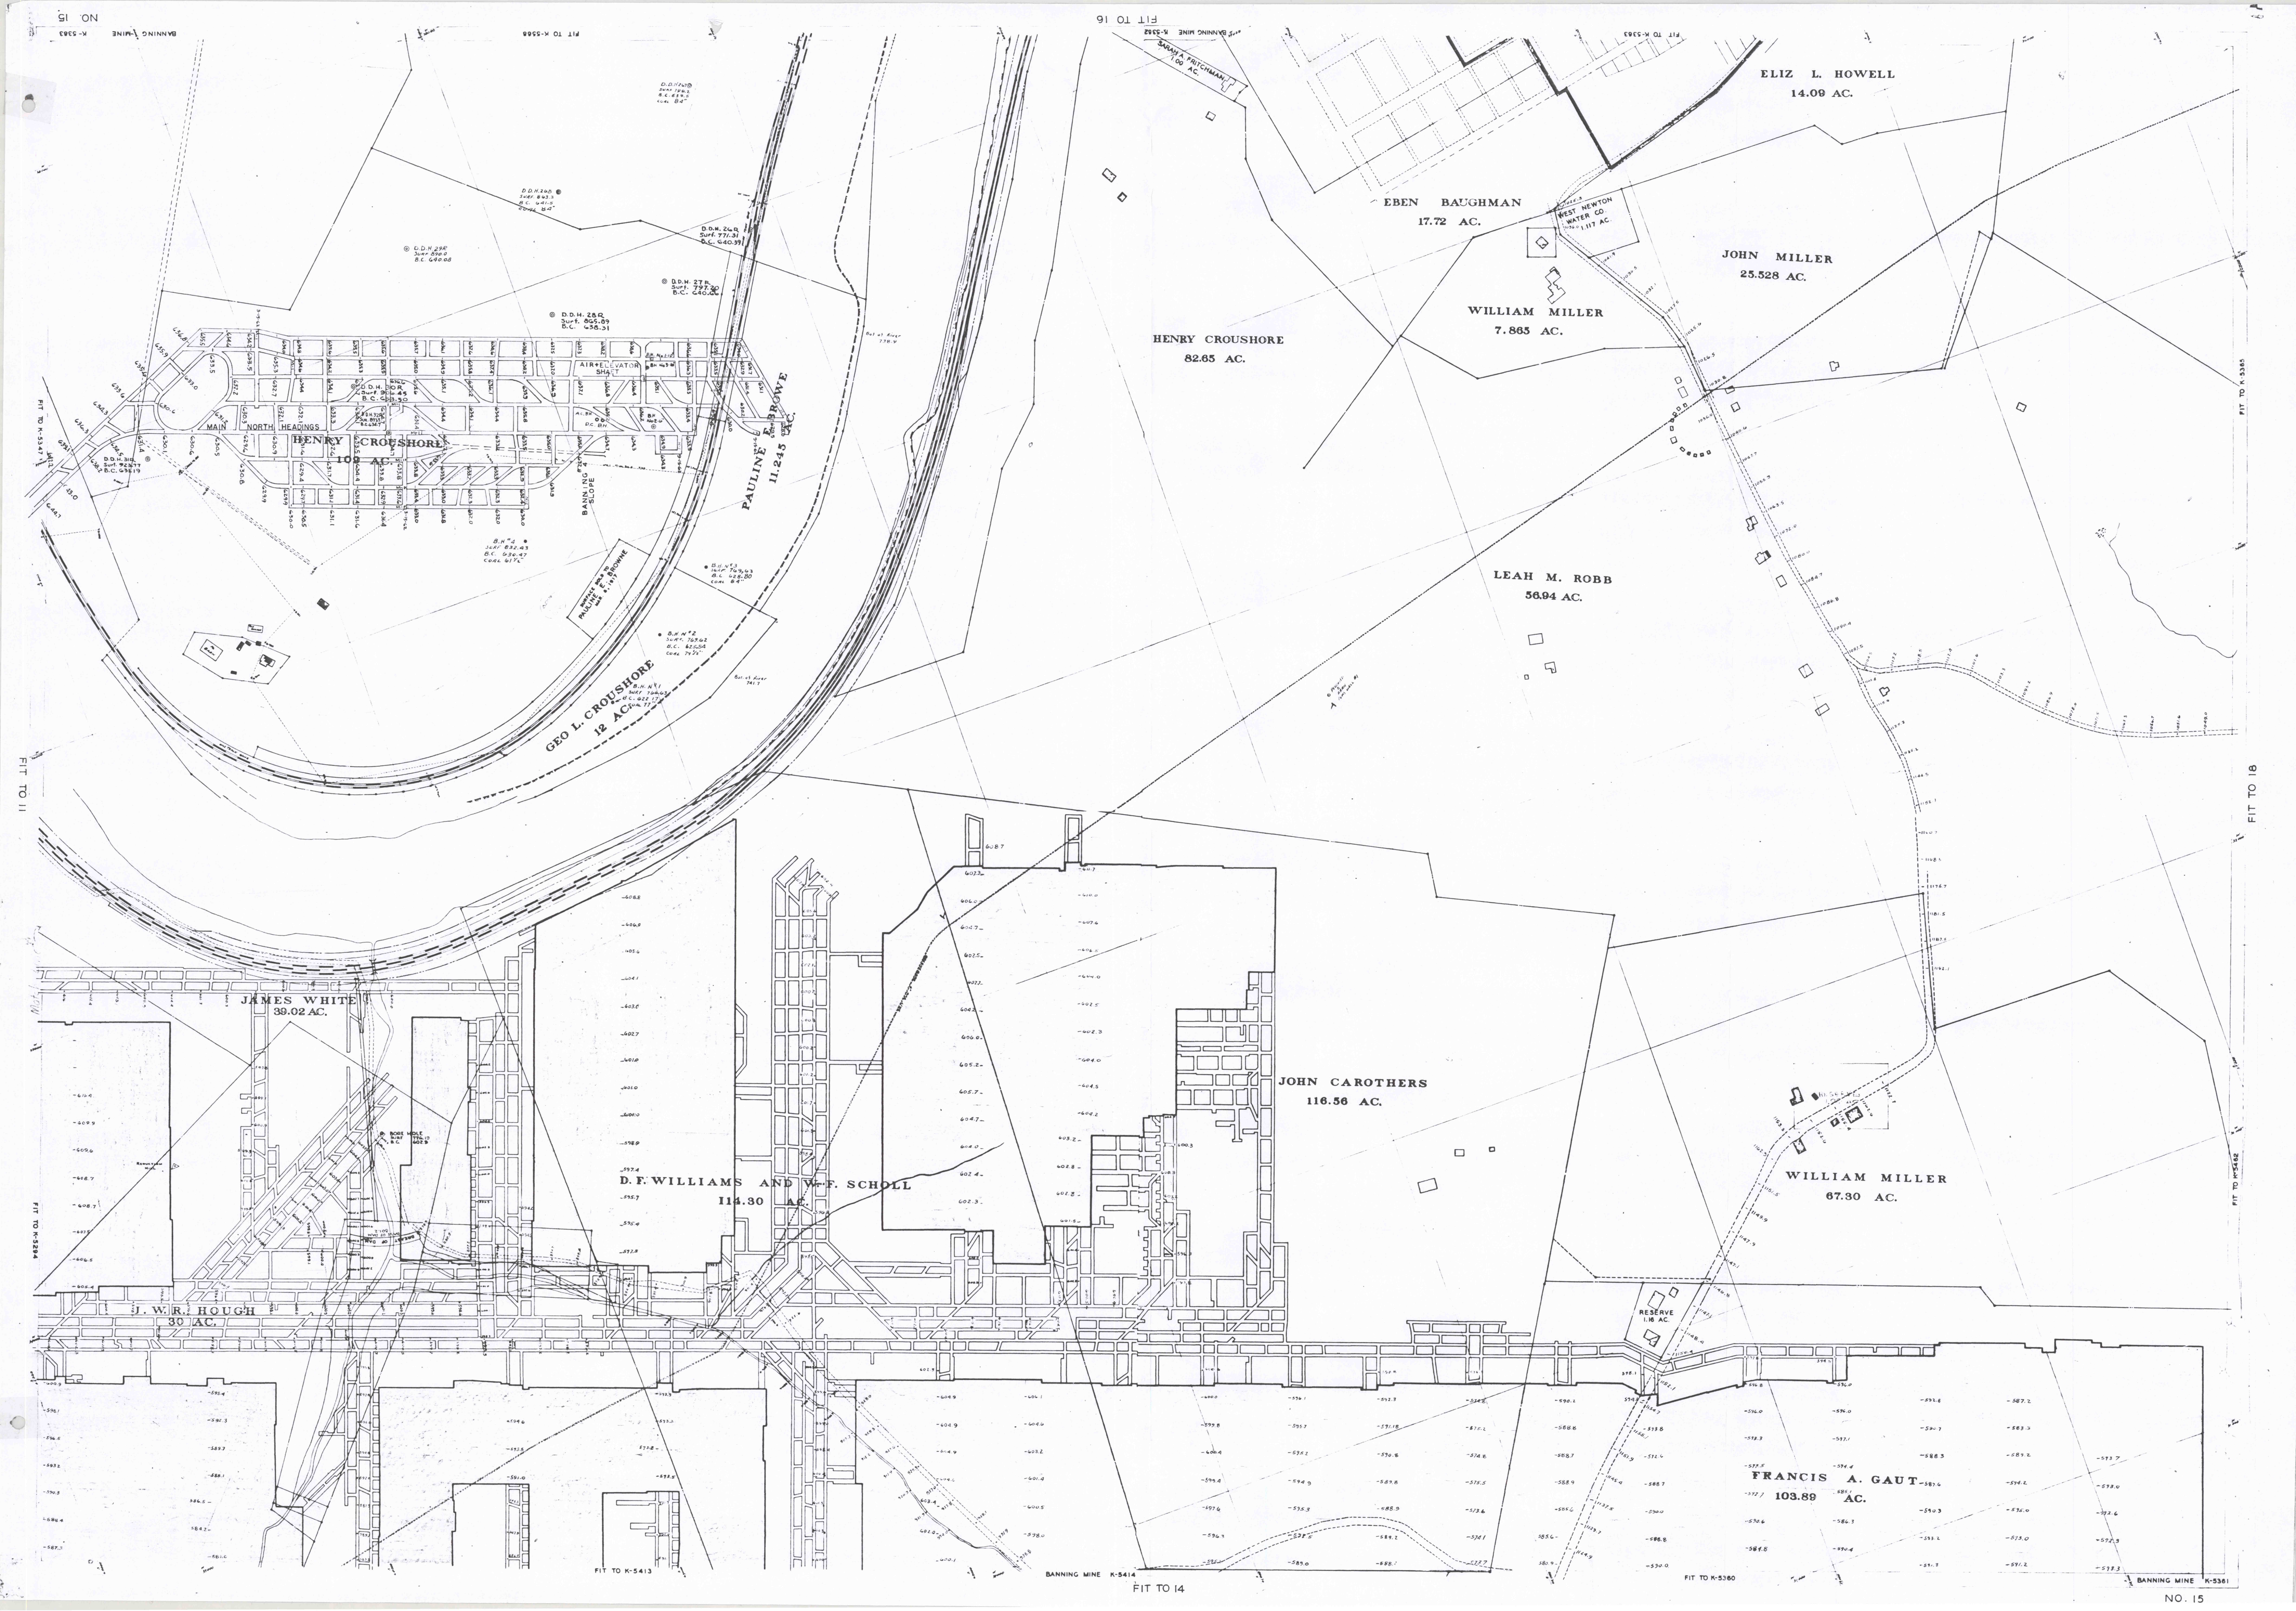

BANNING MINE
K-5385

ELIZ L. HOWELL
14.09 AC.

EBEN BAUGHMAN
17.72 AC.

JOHN MILLER
25.528 AC.

WILLIAM MILLER
7.865 AC.

HENRY CROUSHORE
82.65 AC.

LEAH M. ROBB
56.94 AC.

11.245 AC.

GEO L. CROUSHORE
12 AC.

JAMES WHITE
39.02 AC.

D.F. WILLIAMS AND W.F. SCHOLL
114.30 AC.

JOHN CAROTHERS
116.56 AC.

WILLIAM MILLER
67.30 AC.

J. W.R. HOUGH
30 AC.

FRANCIS A. GAUT
103.89 AC.

RESERVE
1.18 AC.

BANNING MINE
K-5414

BANNING MINE
K-5381

NO. 15