




RECEIVED
DIVISION OF MINE
SUBSISTENCE REGULATION
FEB 08 1979
McMURRAY
PENNSYLVANIA

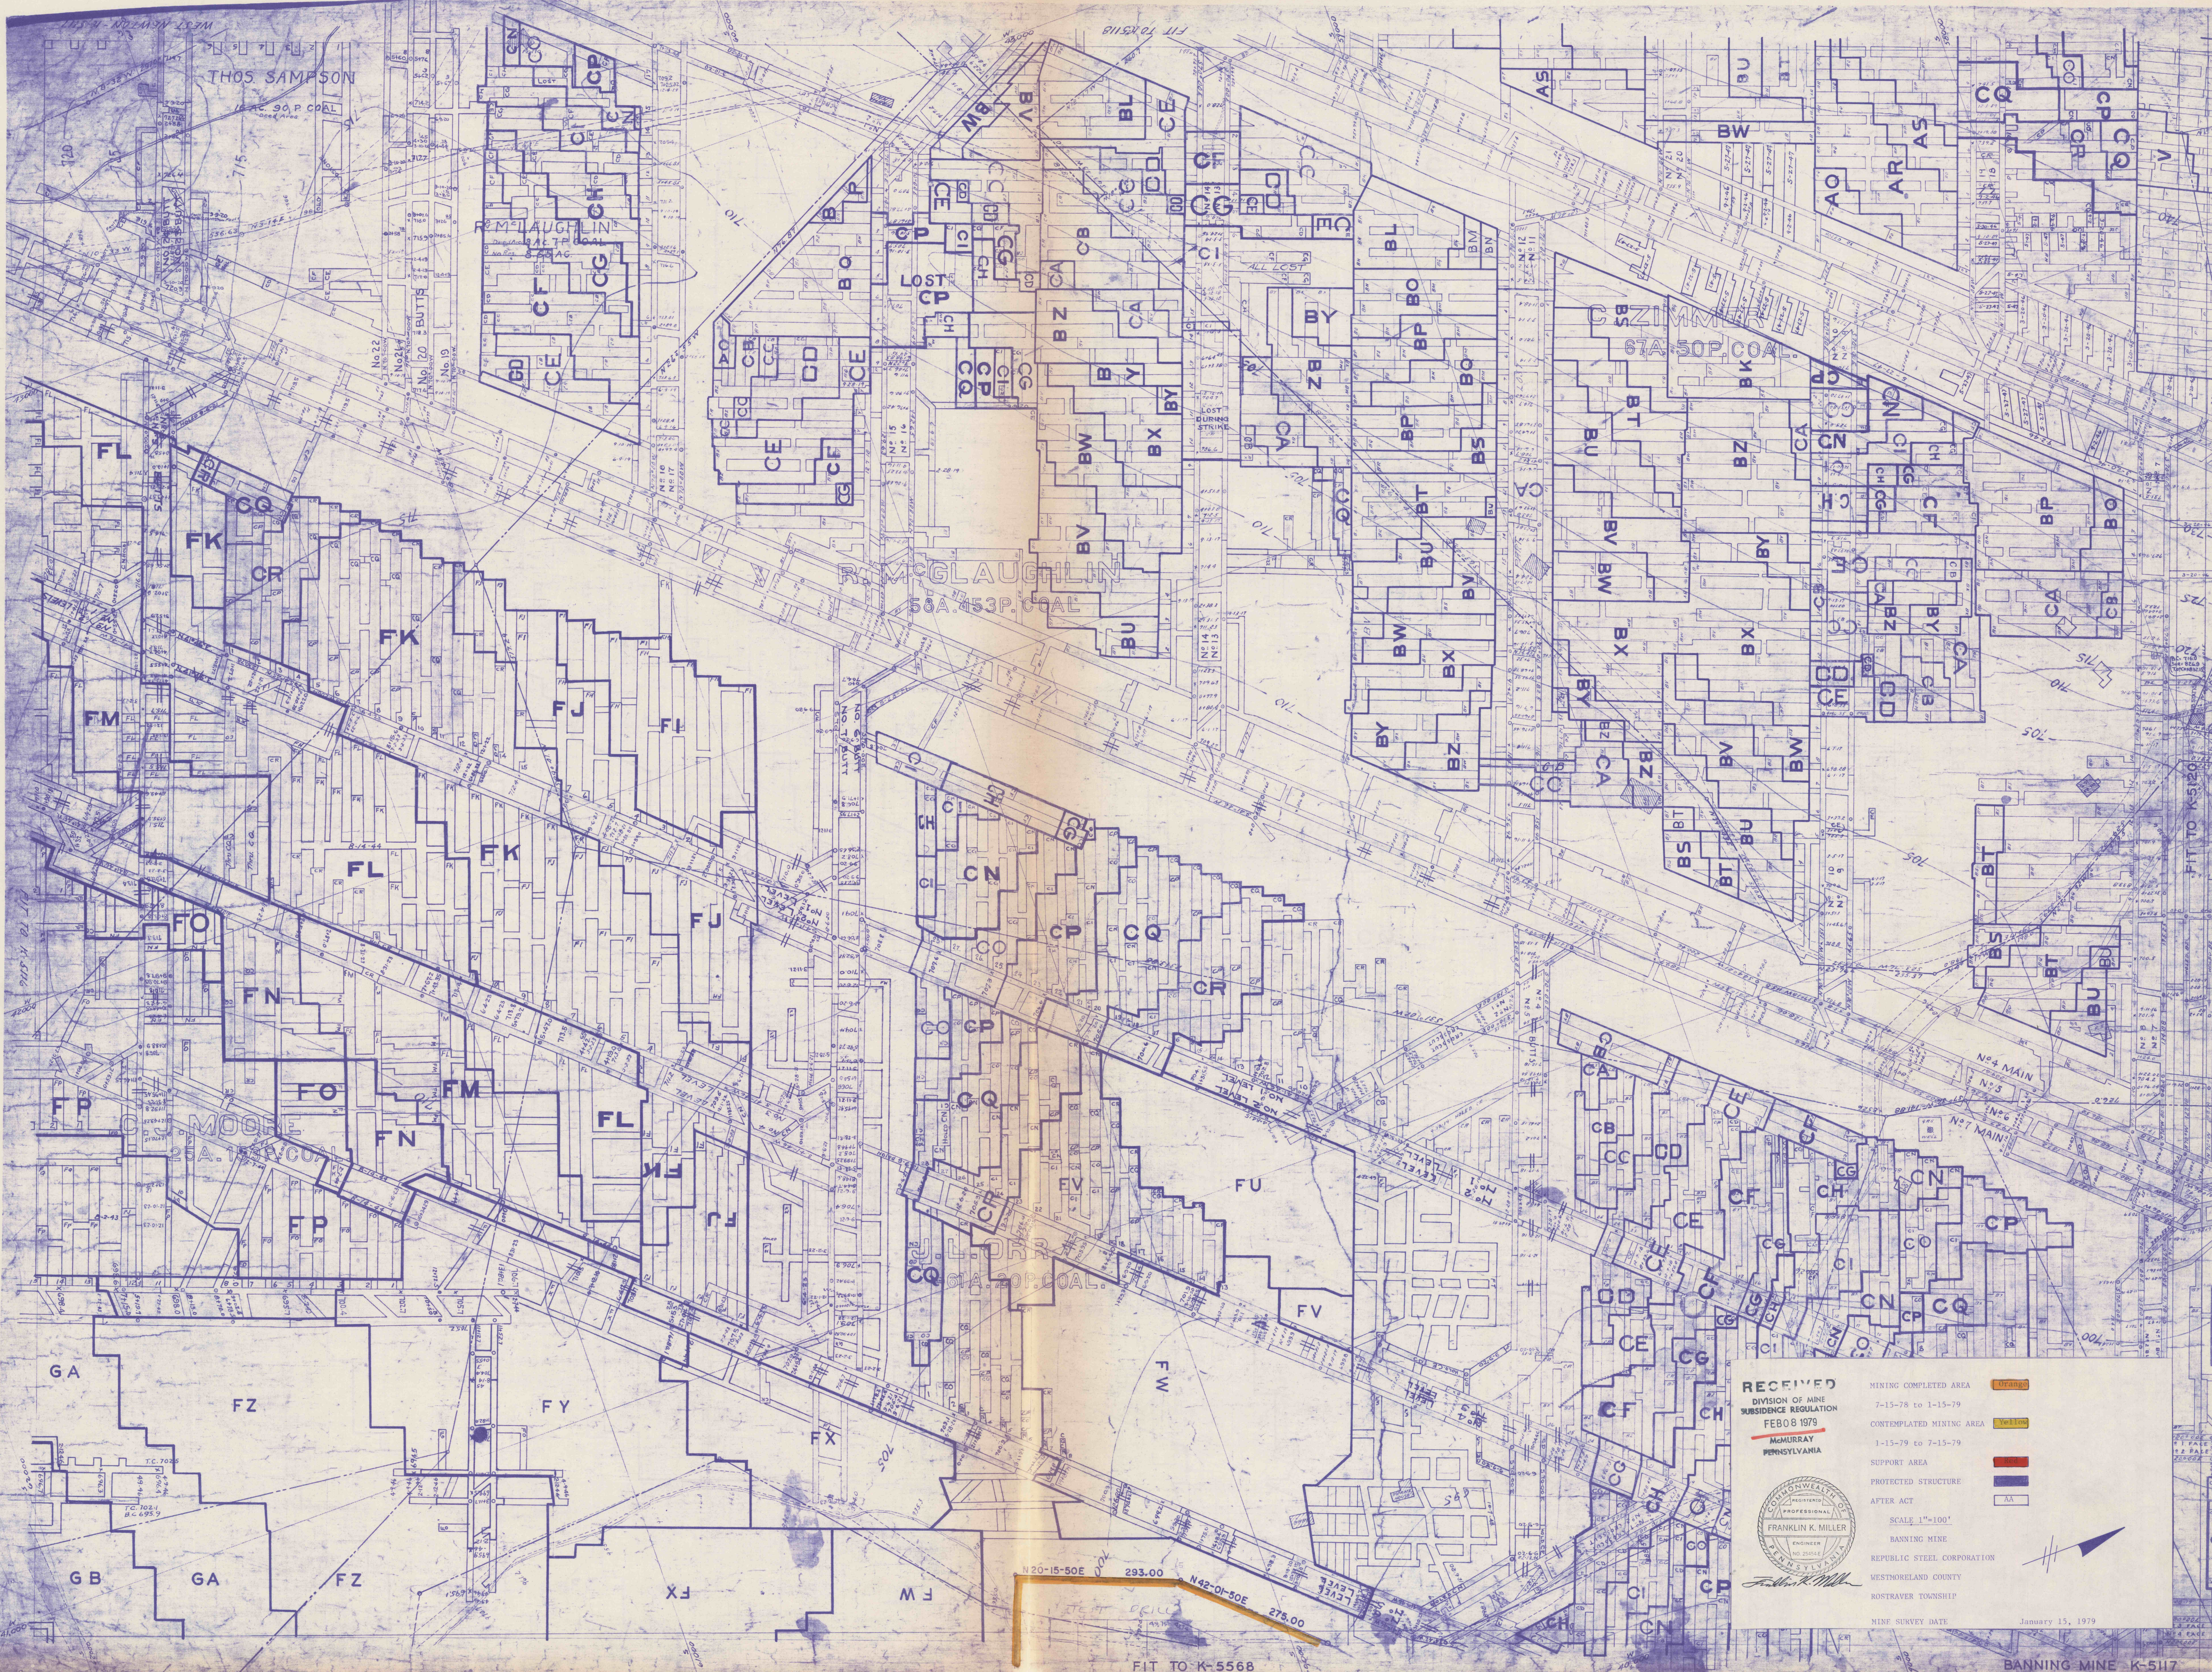

MINING COMPLETED AREA
7-15-78 to 1-15-79
CONTEMPLATED MINING AREA
1-15-79 to 7-15-79
SUPPORT AREA
PROTECTED STRUCTURE
AFTER ACT
SCALE 1"=100'
BANNING MINE
REPUBLIC STEEL CORPORATION
WESTMORELAND COUNTY
ROSTRAVER TOWNSHIP
MINE SURVEY DATE
January 15, 1979

FIT TO K-5568

BANNING MINE K-5117