


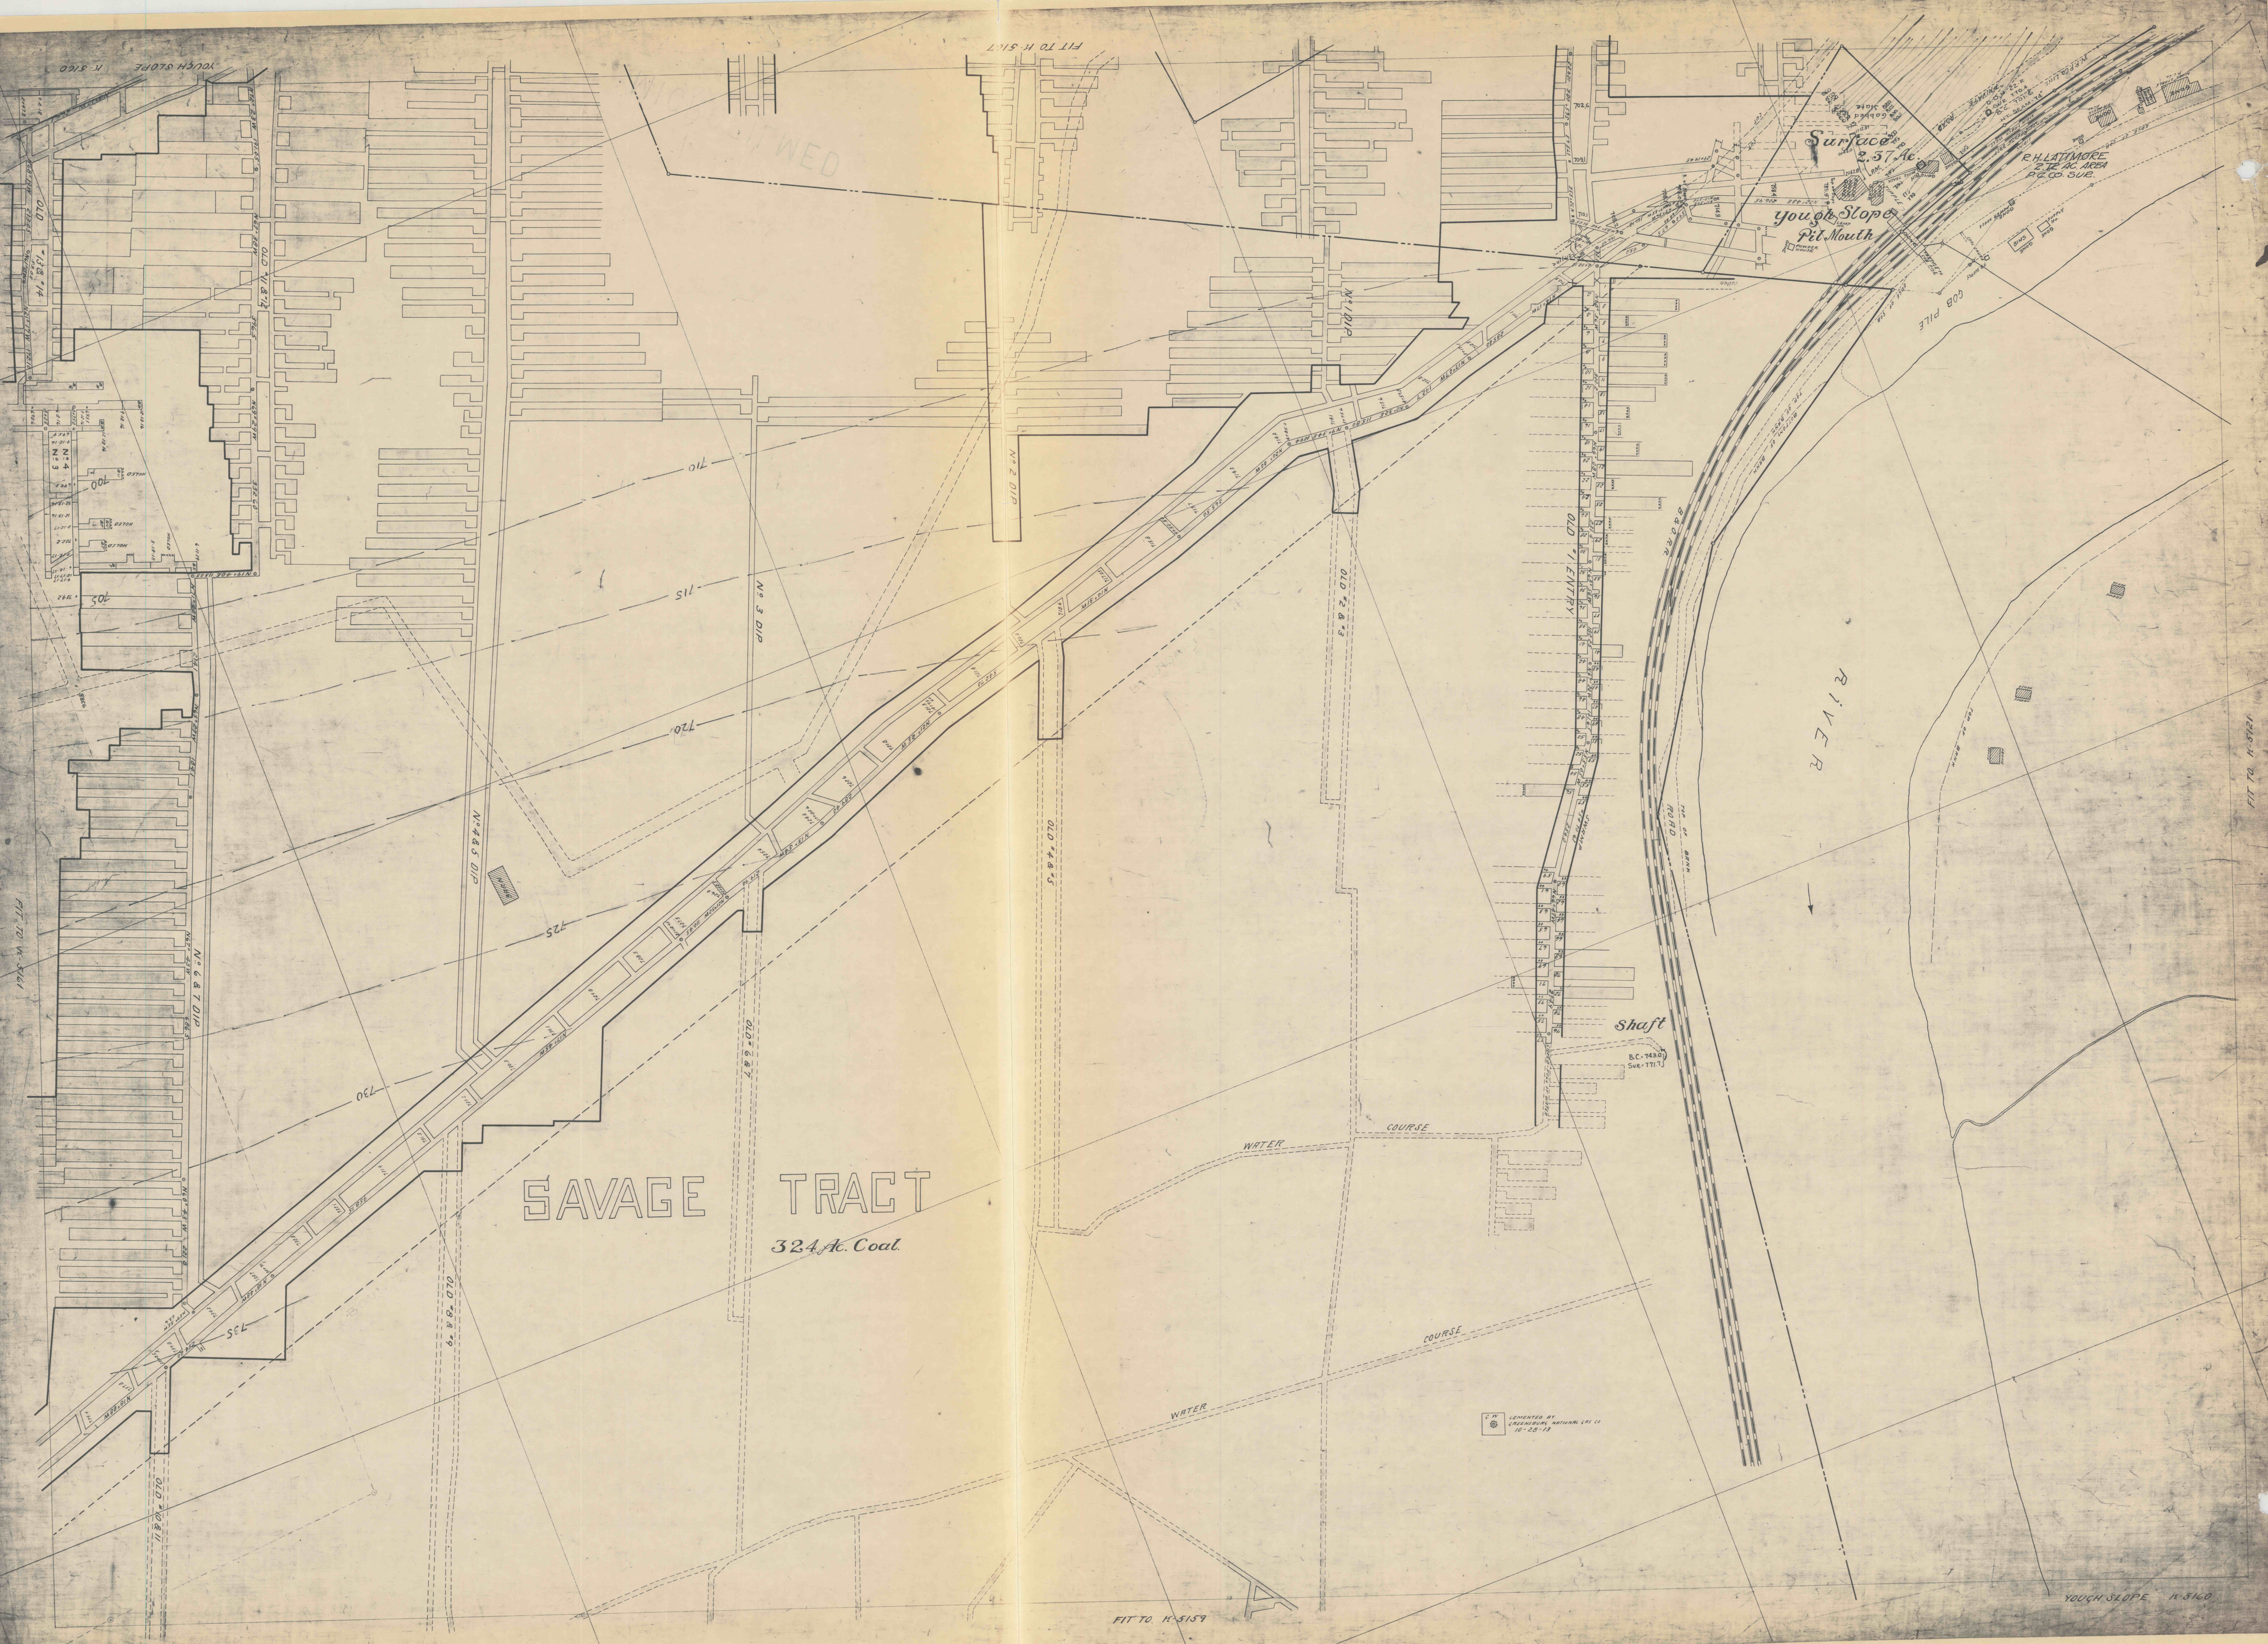

SAVAGE TRACT
324 A. Coal.

RIVER

Shaft

COURSE

WATER

COURSE

WATER

Surface 2.57.16

yough Slope
Pit Mouth

R. H. LATMORE
P. C. CO. SUP.

COB PILE

TOP OF BRICK
ROAD

B.C. 1430
SURV. 1711


FIT TO H-5159

FIT TO H-5161

YOUGH SLOPE H-5160