



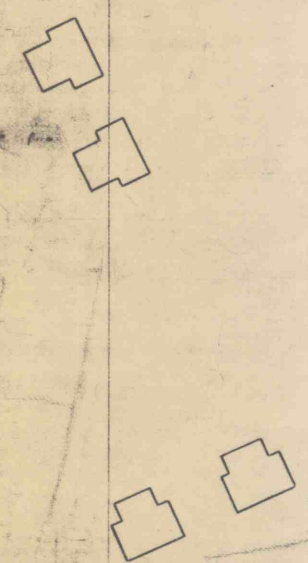

FIT TO R-5165

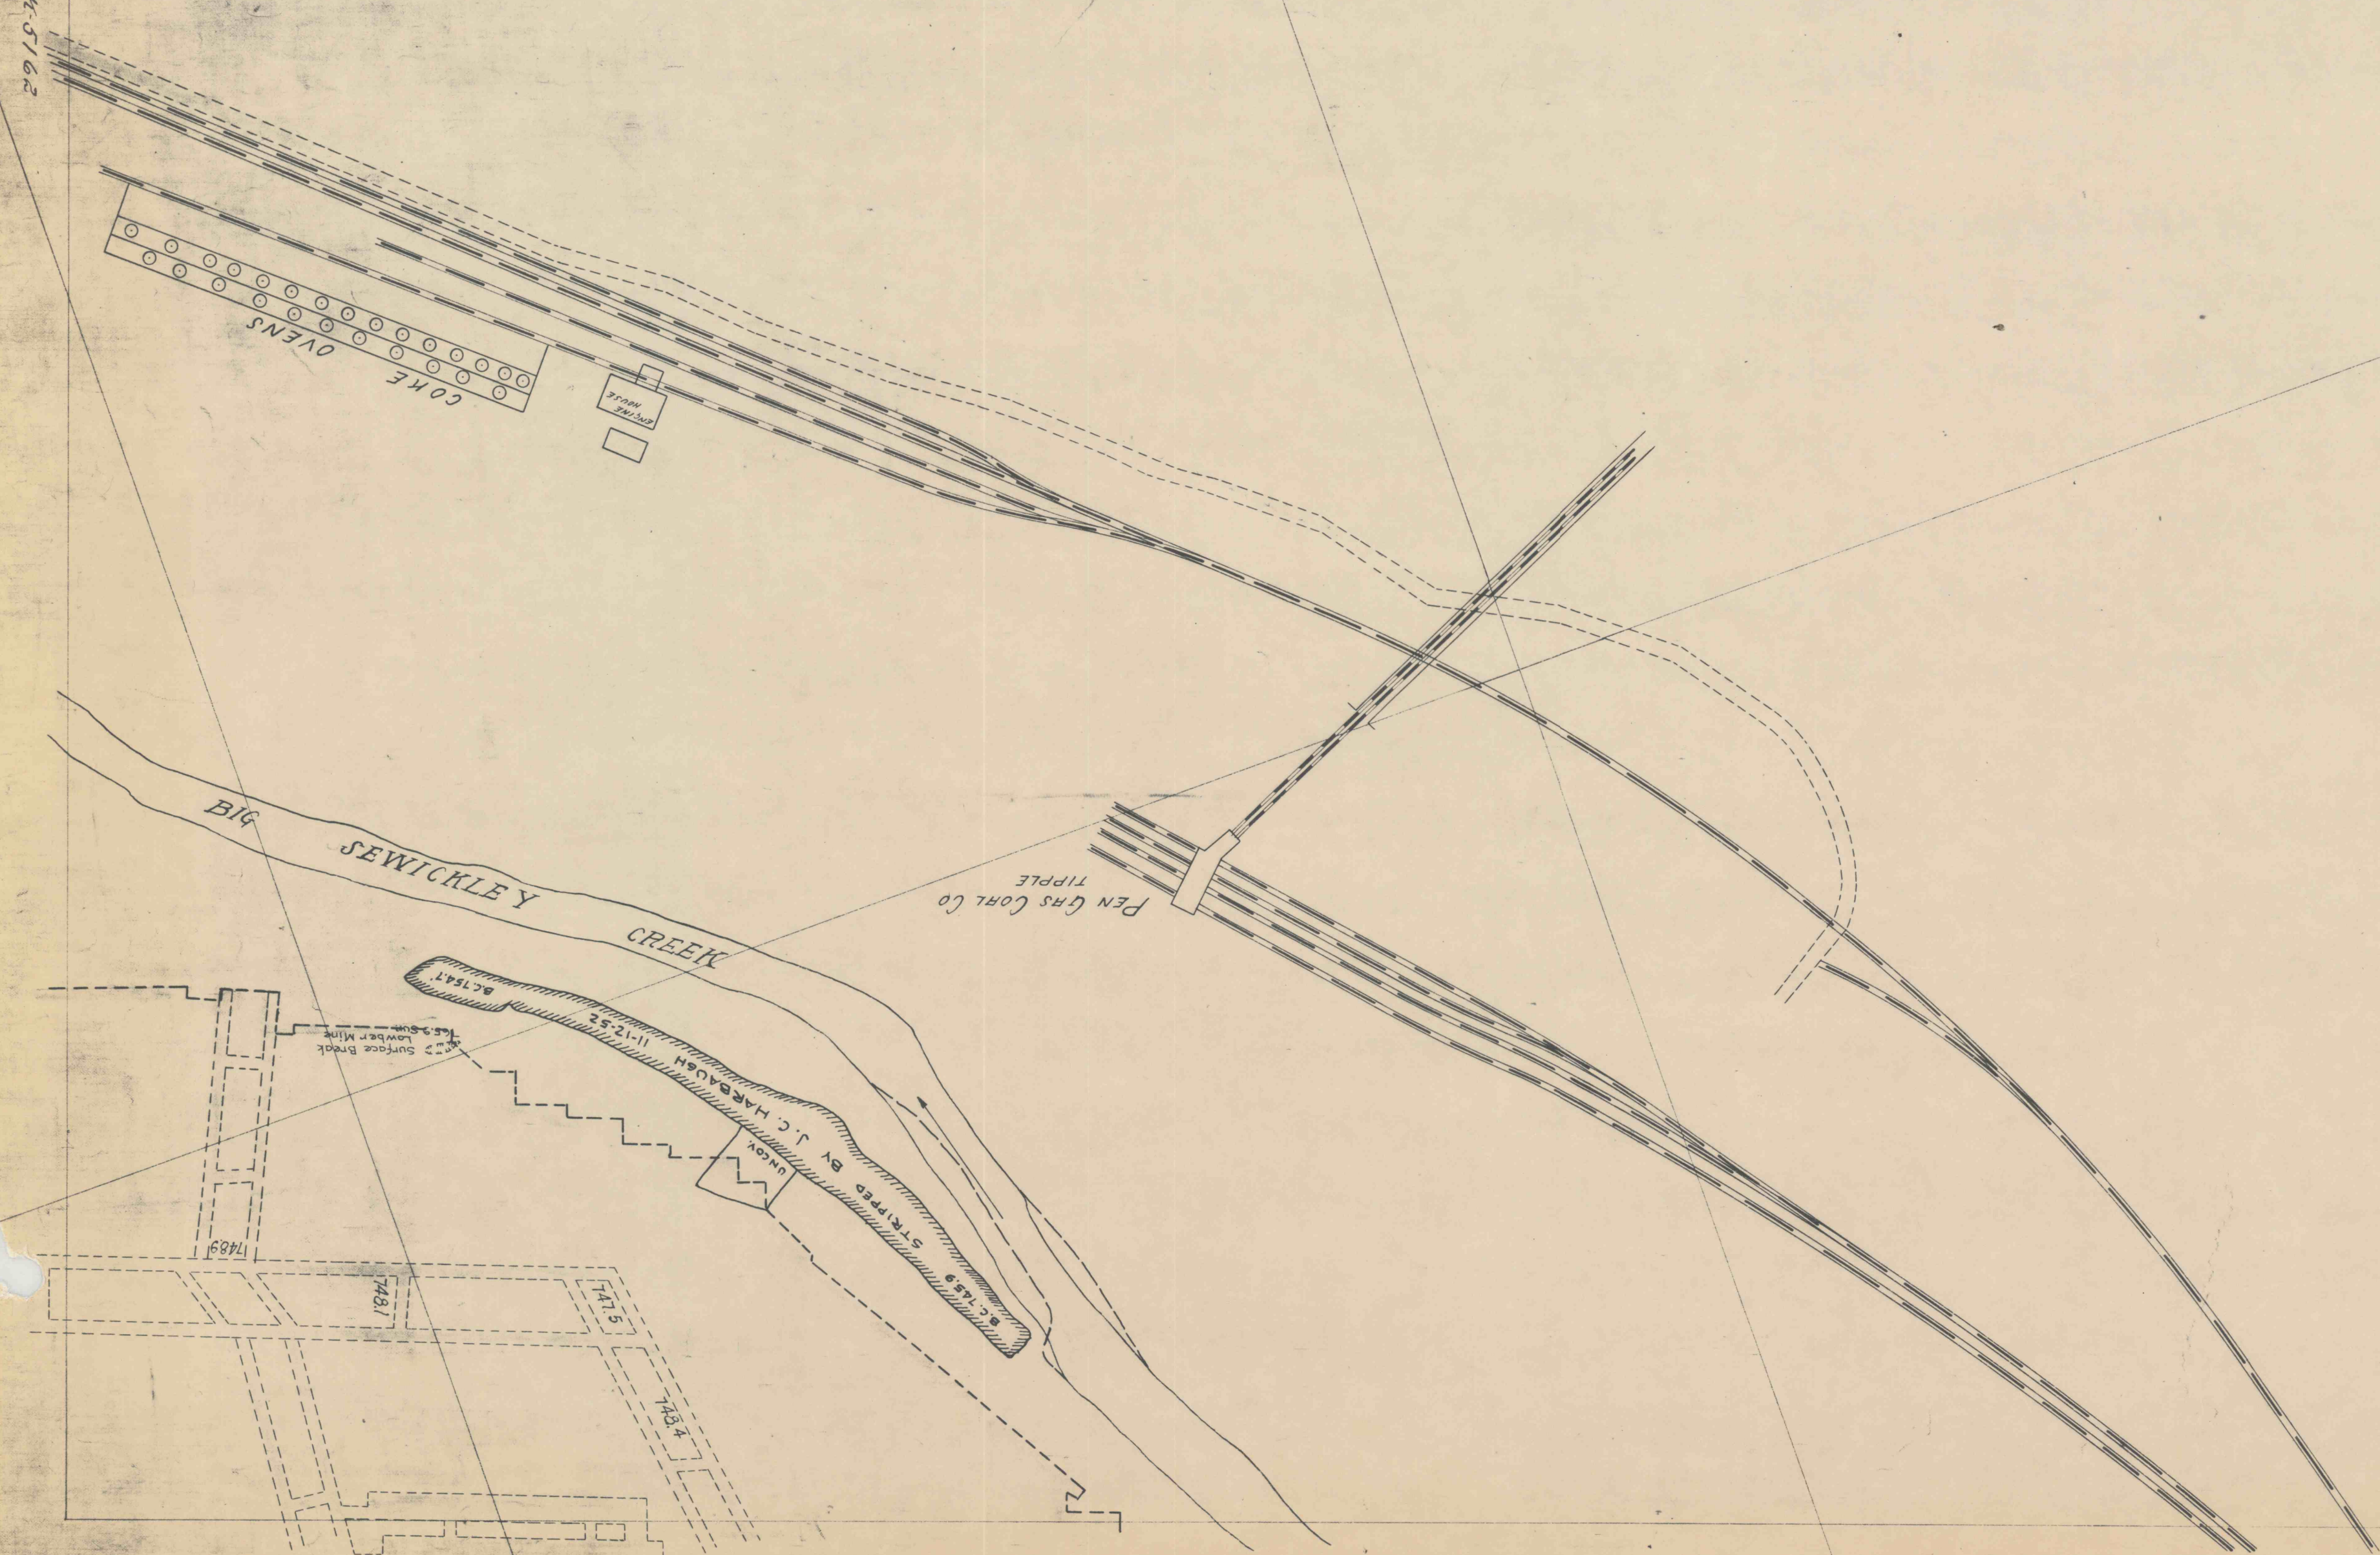

FIT TO R-5164

LOWED