


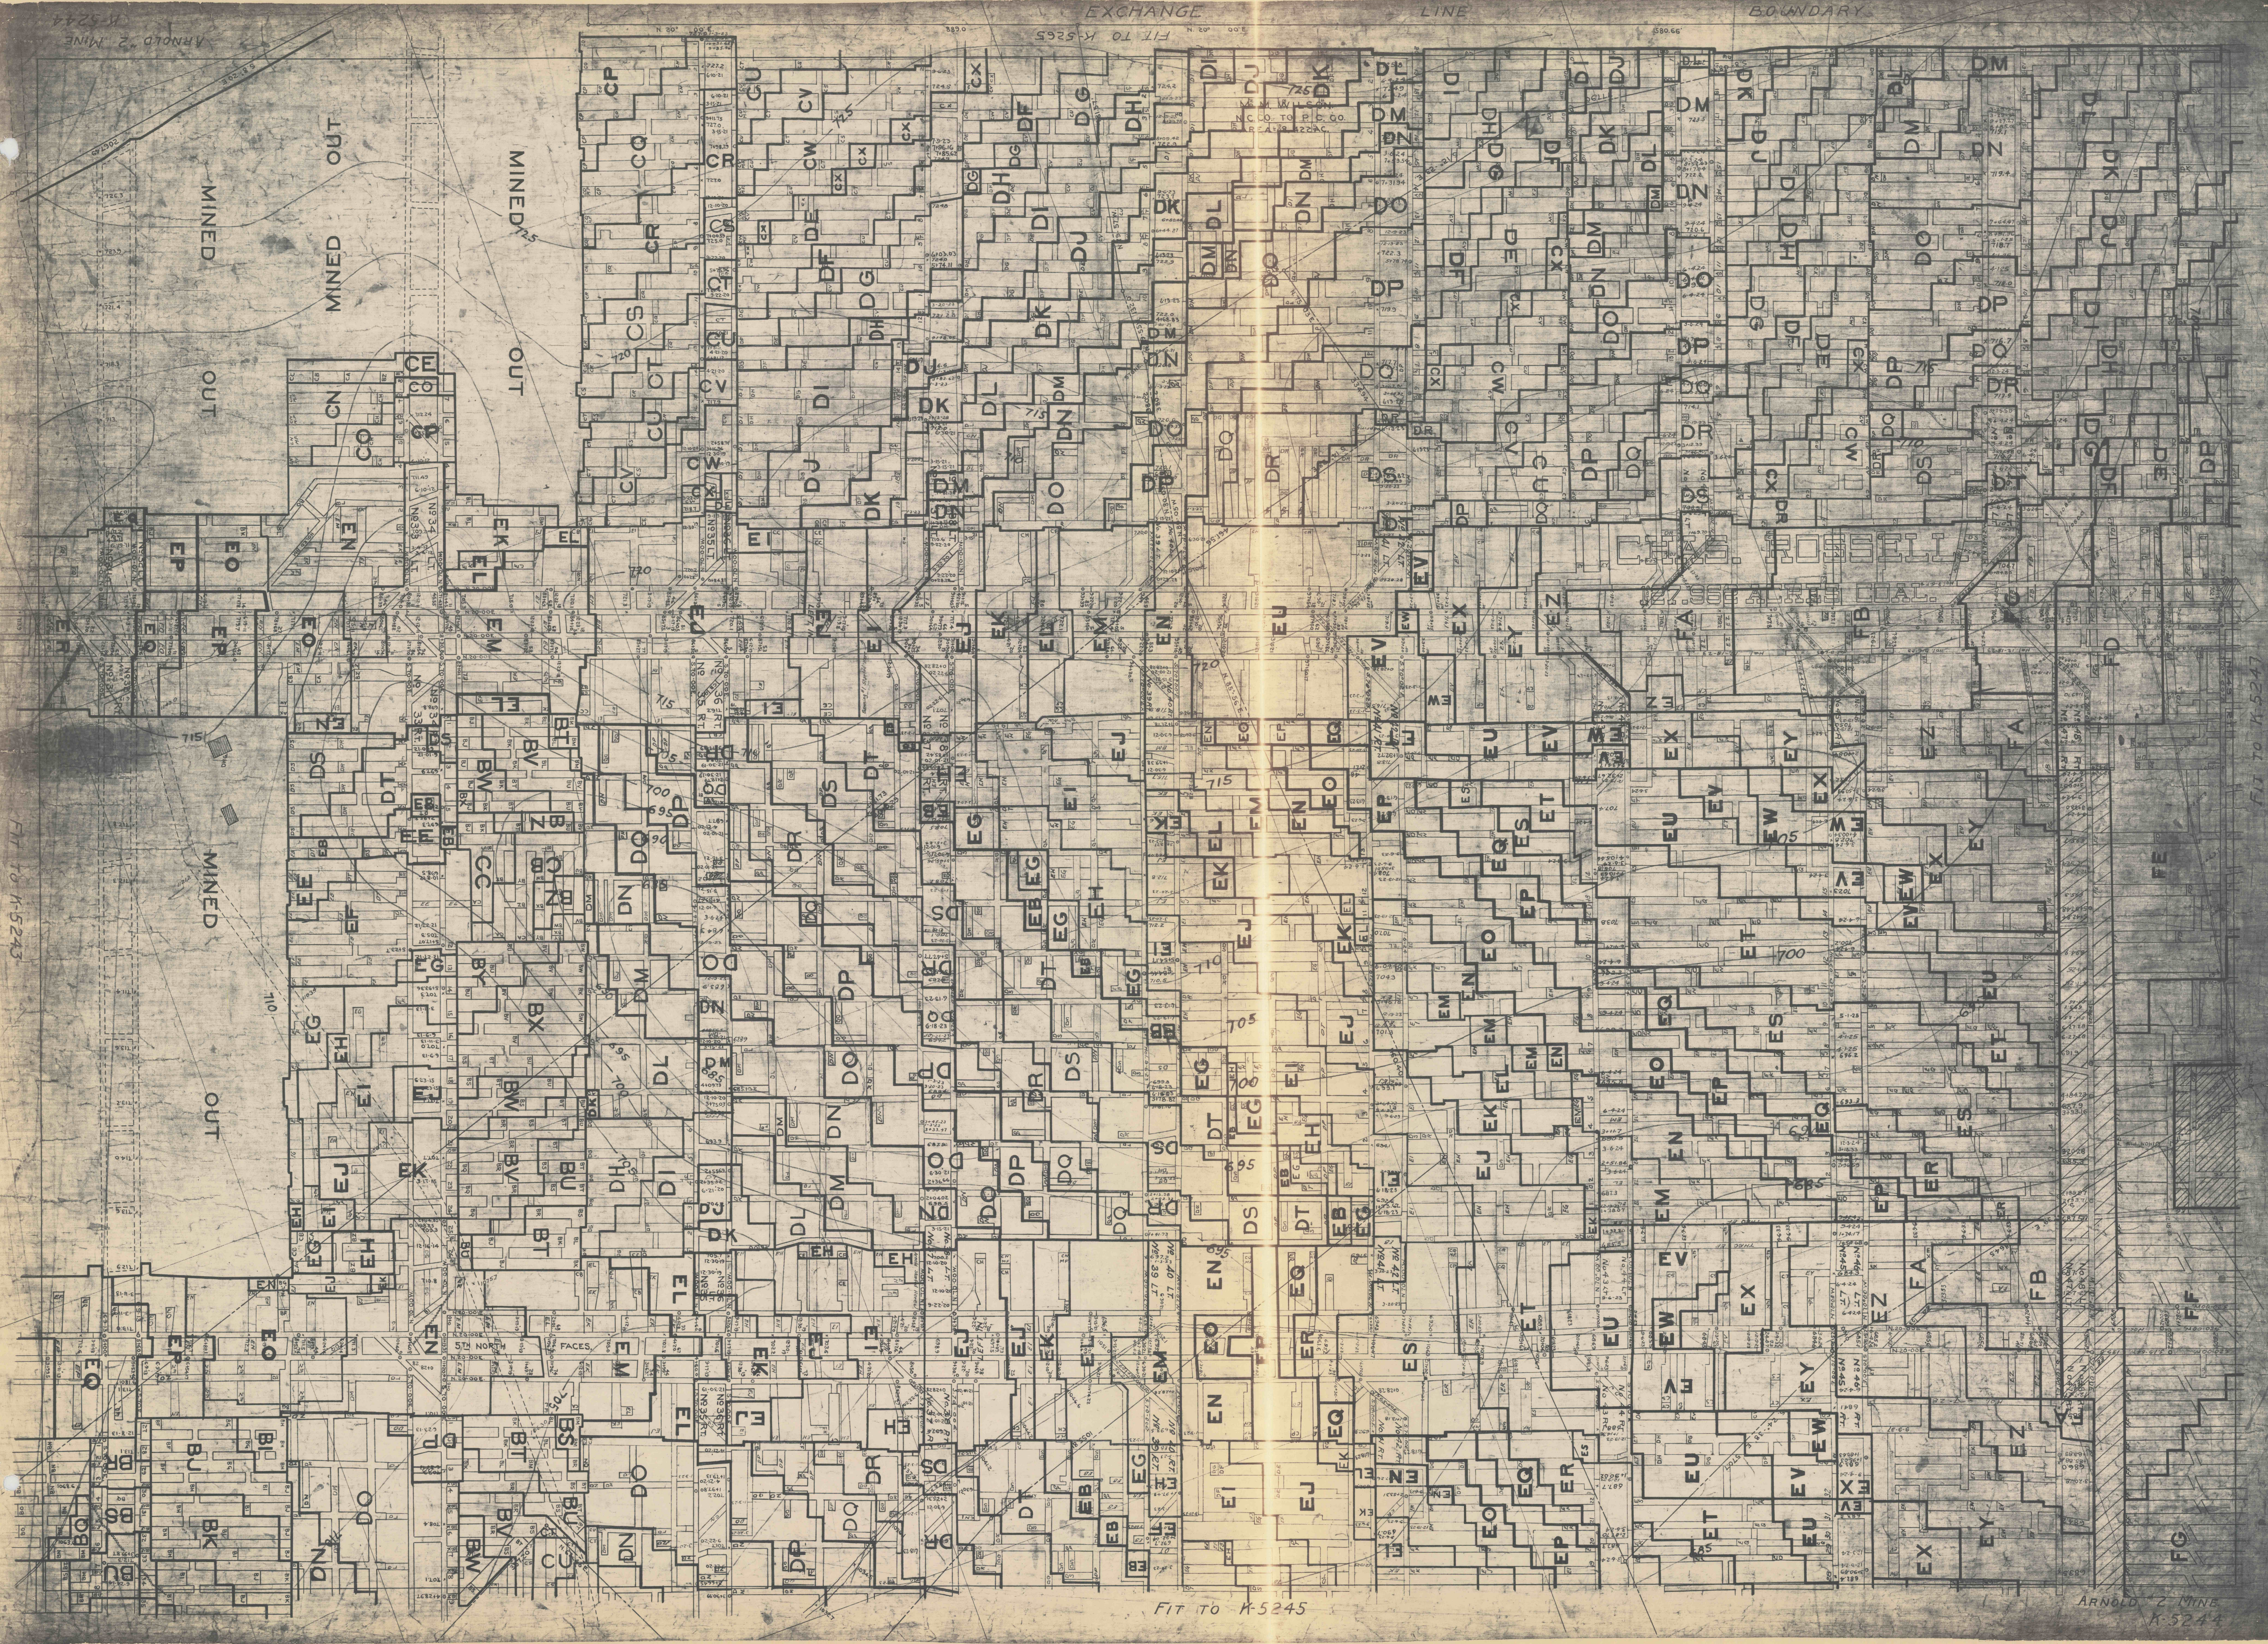

FT TO K-5243

ARNOLD 2 MINE
K-5244

EXCHANGE
FIT TO K-5265

BOUNDARY
580.66

FIT TO K-5245

ARNOLD 2 MINE
K-5244