


524C

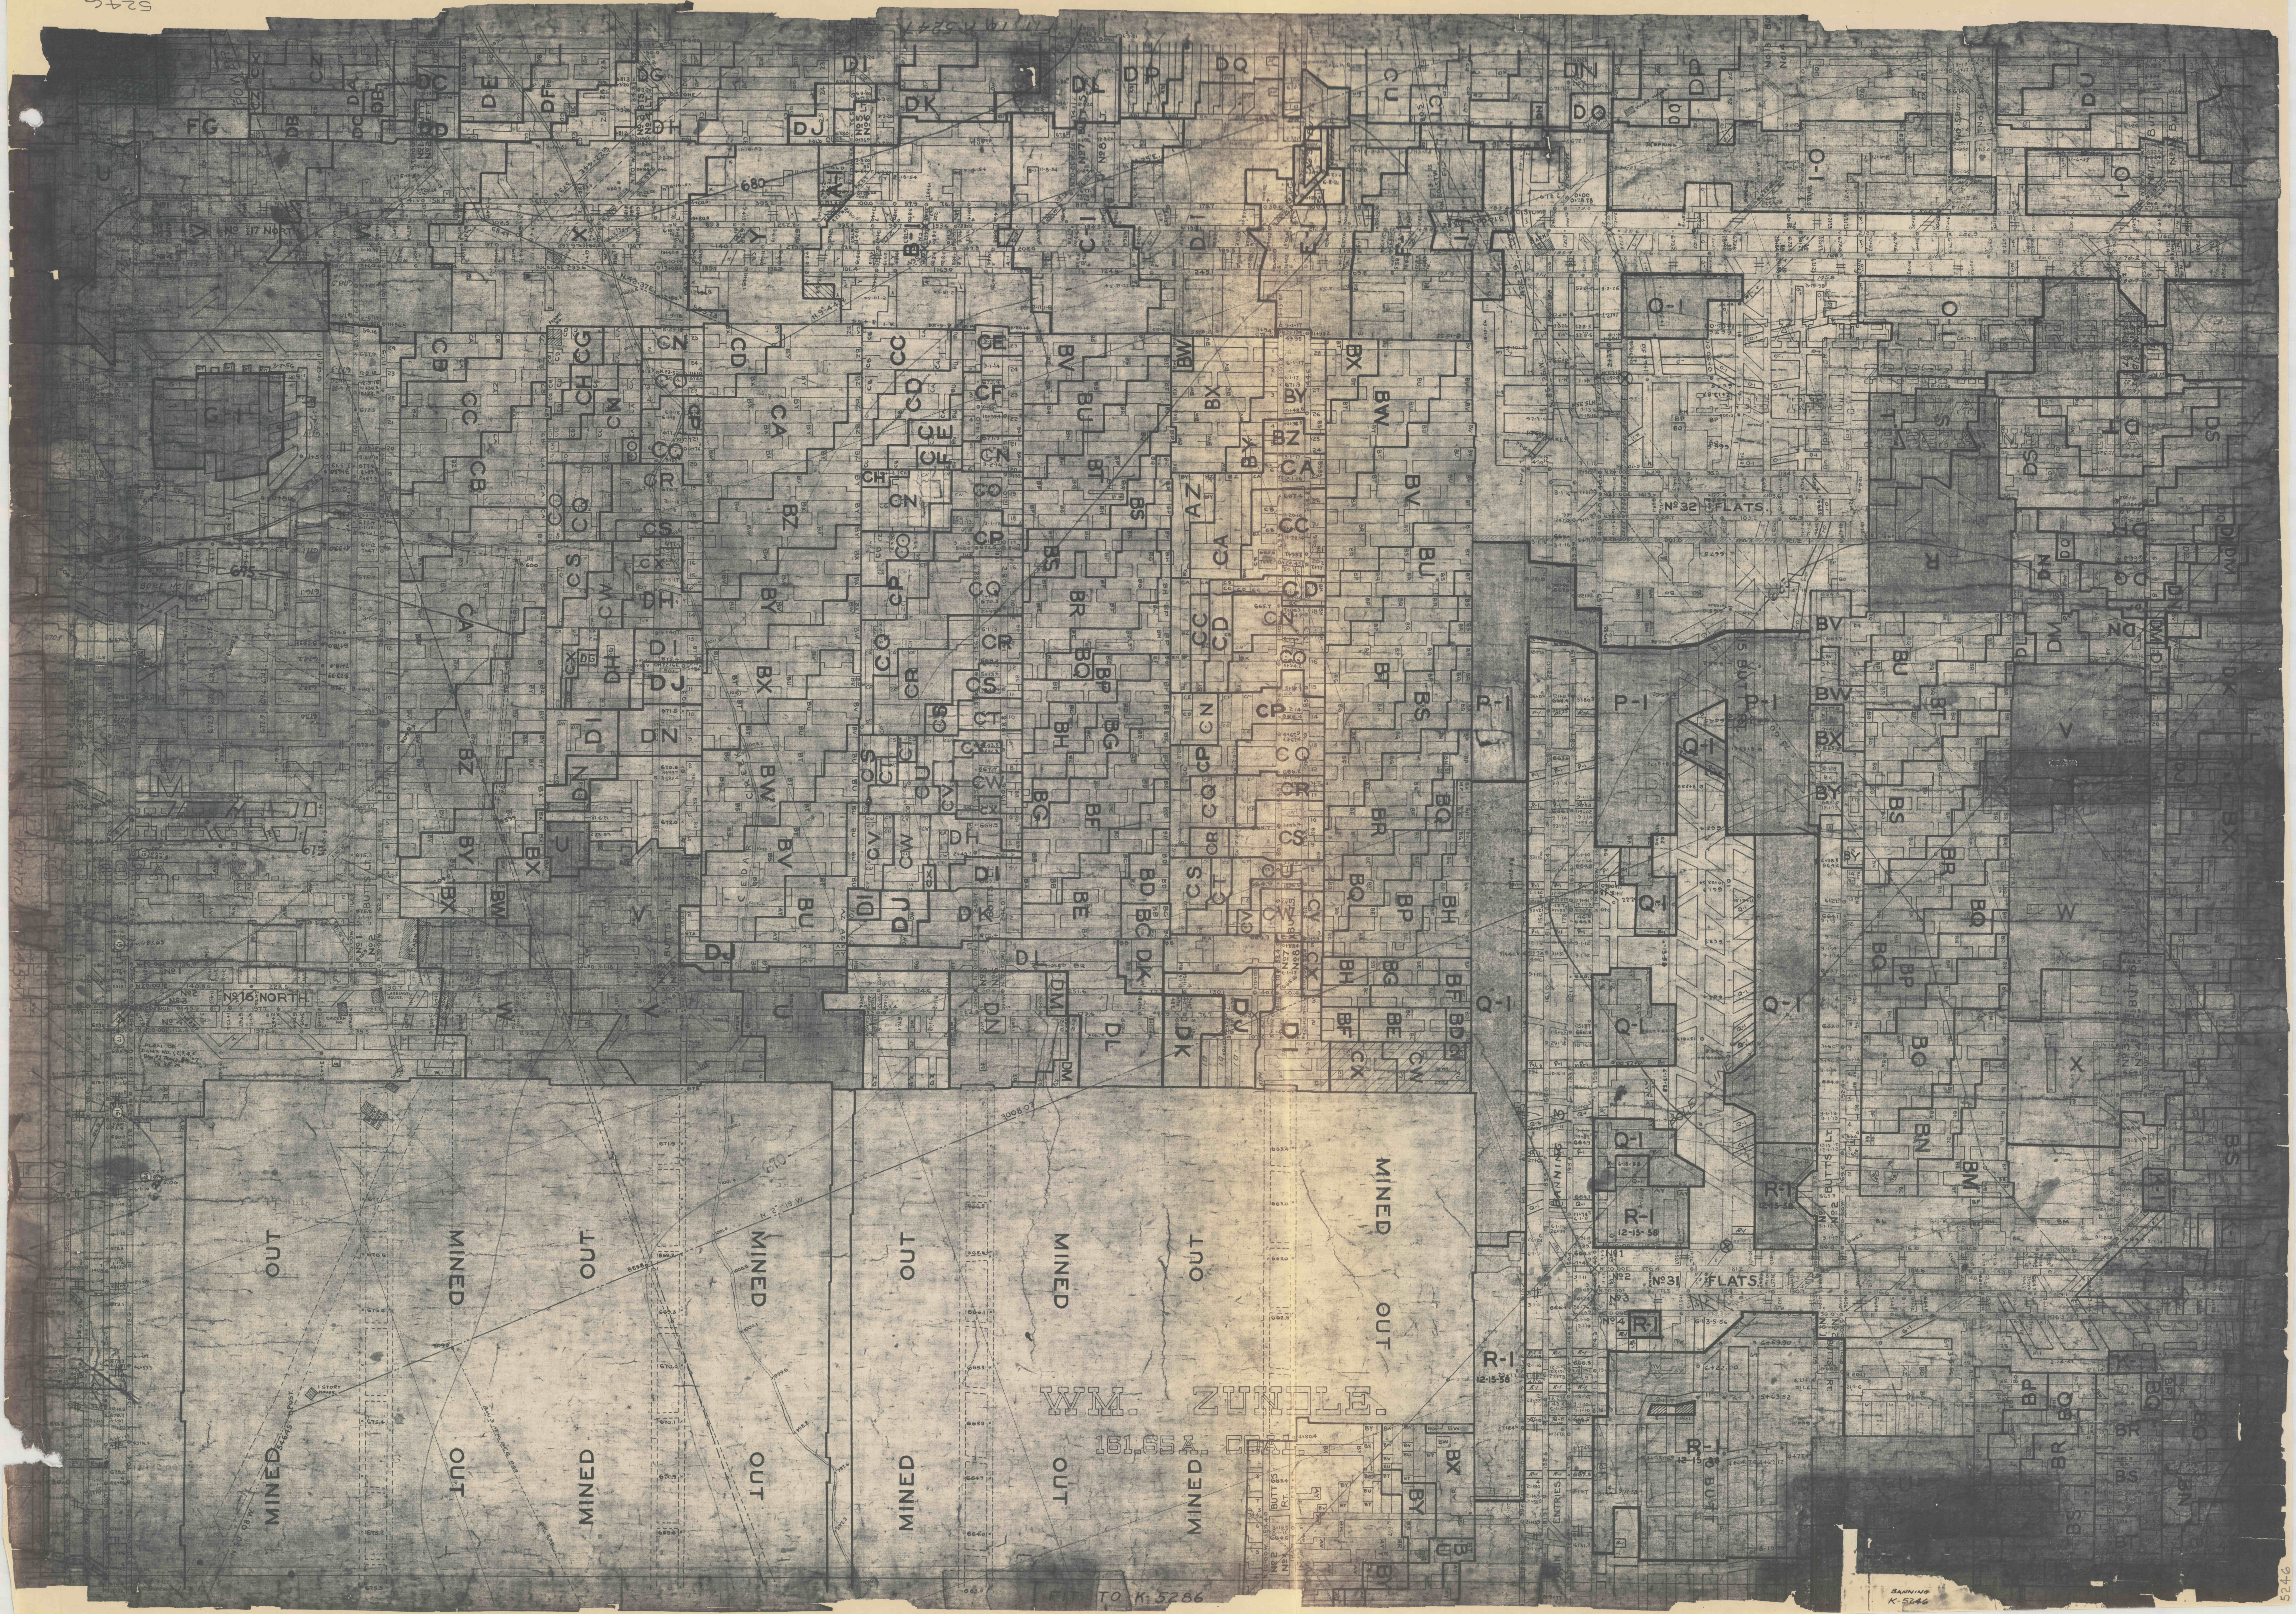

TO K-5286

BANNING
K-5246

524C