


BANNING No 1 & No 2 K-5285

FIT TO K-5254

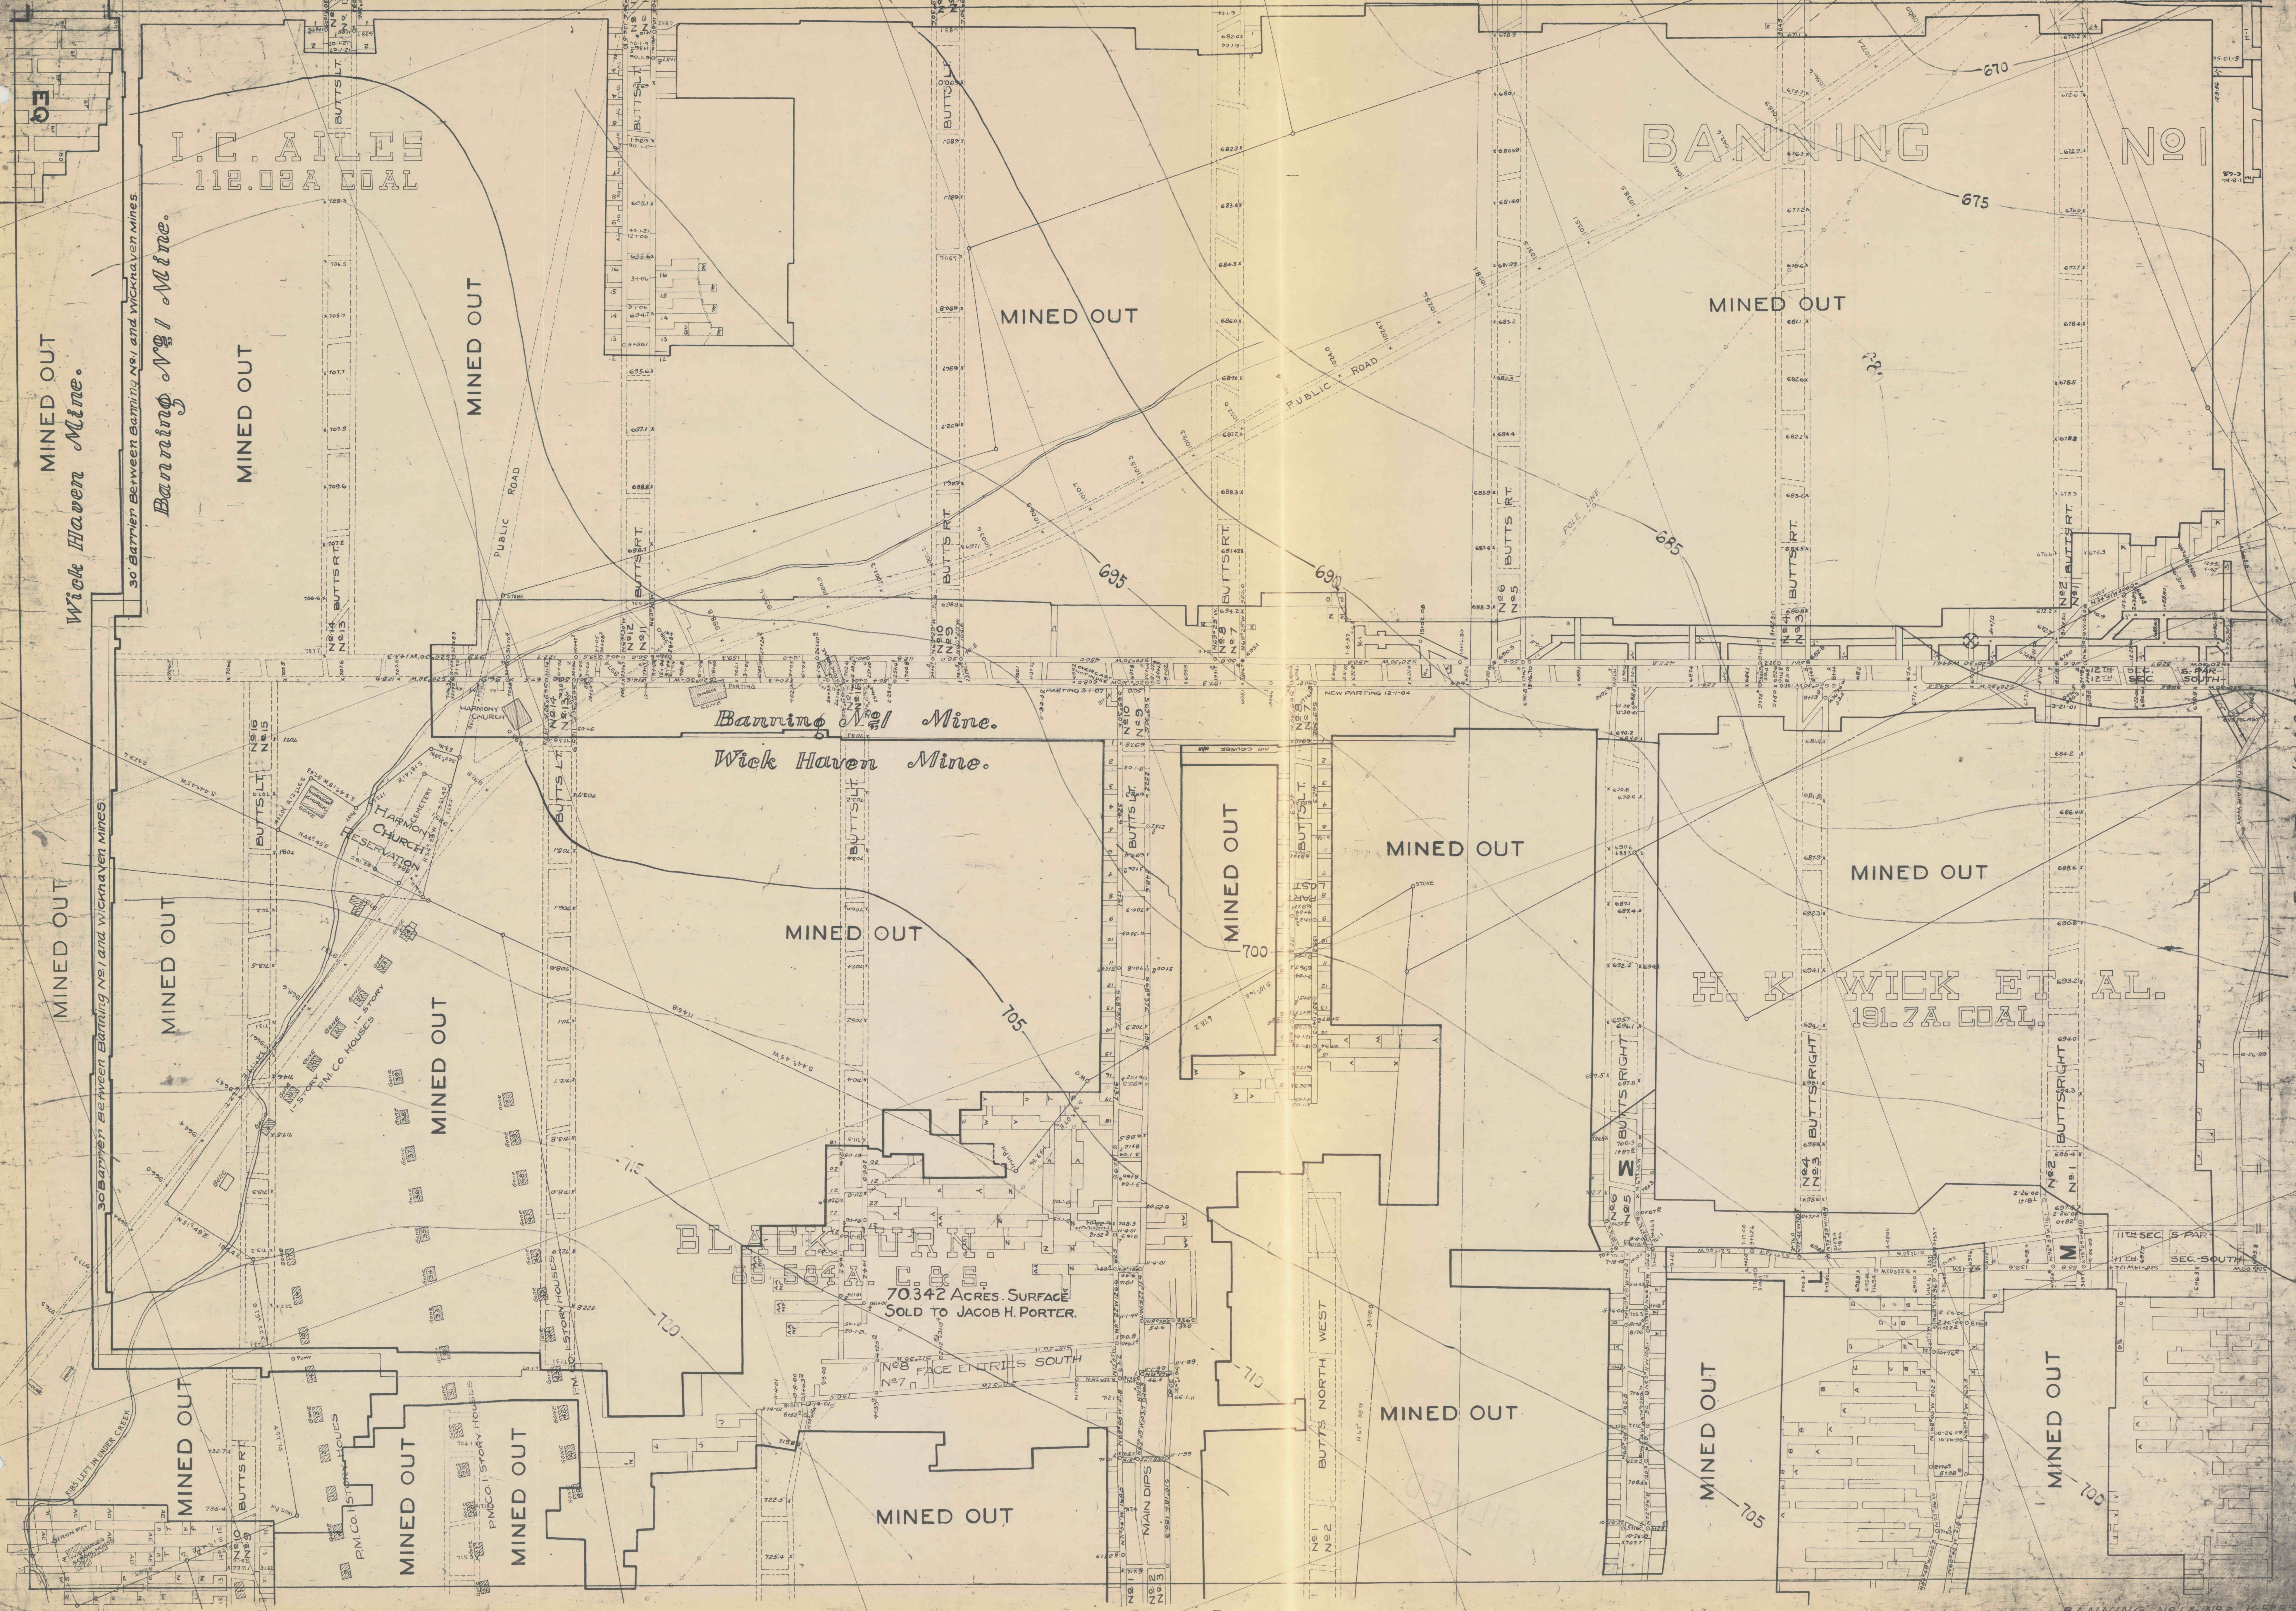

FIT TO K-5252

FIT TO K-5285

FIT TO K-5297

BANNING No 1 & No 2 K-5285