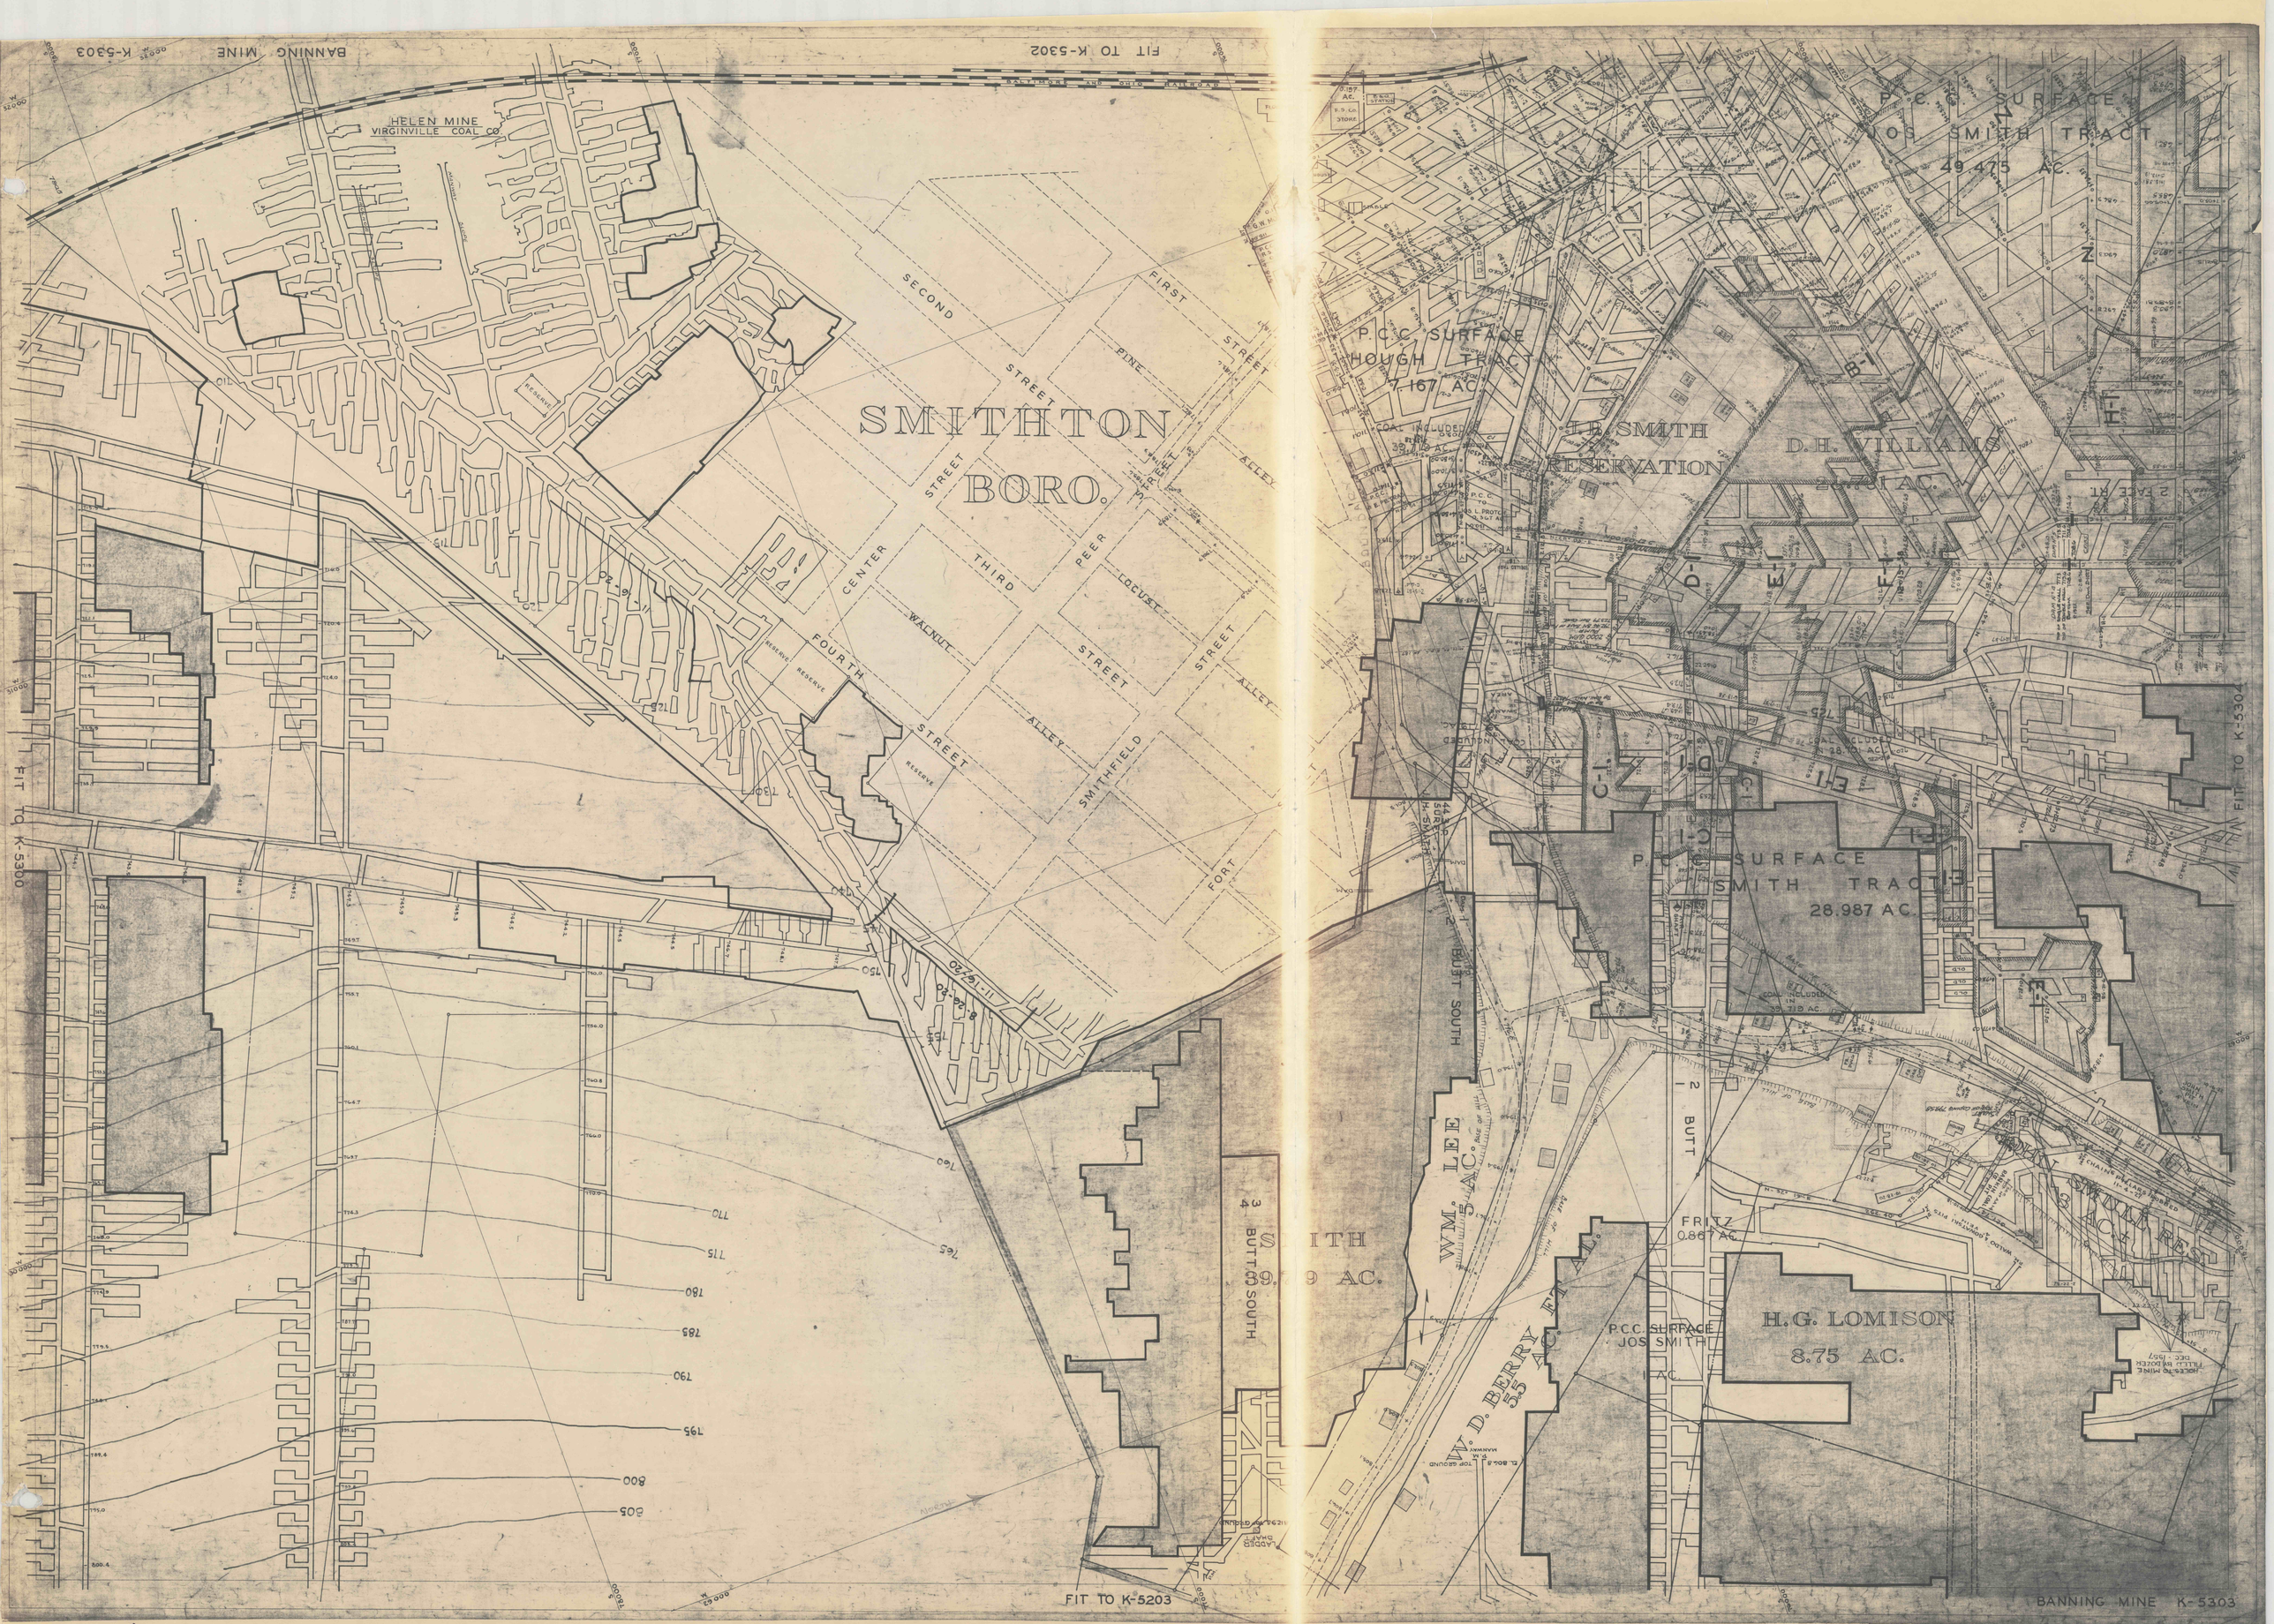
FIT TO K-5302
BANNING MINE K-5303
HELEN MINE
VIRGINVILLE COAL CO.
SMITHTON
BORO.
SECOND STREET
FIRST STREET
PINE STREET
CENTER STREET
THIRD STREET
PEER STREET
LOCUST STREET
WALNUT STREET
FOURTH STREET
SMITHFIELD STREET
FORT ALLEY
RESERVE
FIT TO K-5300
FIT TO K-5203
P.C.C. SURFACE
JOS. SMITH TRACT
49.475 AC.
P.C.C. SURFACE
HOUGH TRACT
7.167 AC.
J.B. SMITH
RESERVATION
D.H. WILLIAMS
P.C.C. SURFACE
JOS. SMITH TRACT
28.987 AC.
WM. LEE
5.5 AC.
W.D. BERRY
5.5 AC.
P.C.C. SURFACE
JOS. SMITH
1 AC.
FRITZ
0.867 AC.
H.G. LOMISON
8.75 AC.
2 BUTT
1 BUTT
3 BUTTS SOUTH
4 BUTTS SOUTH
FIT TO K-5304
BANNING MINE K-5303

IMAPS19604