


BANNING MINE K-5306

FIG TO K-5293

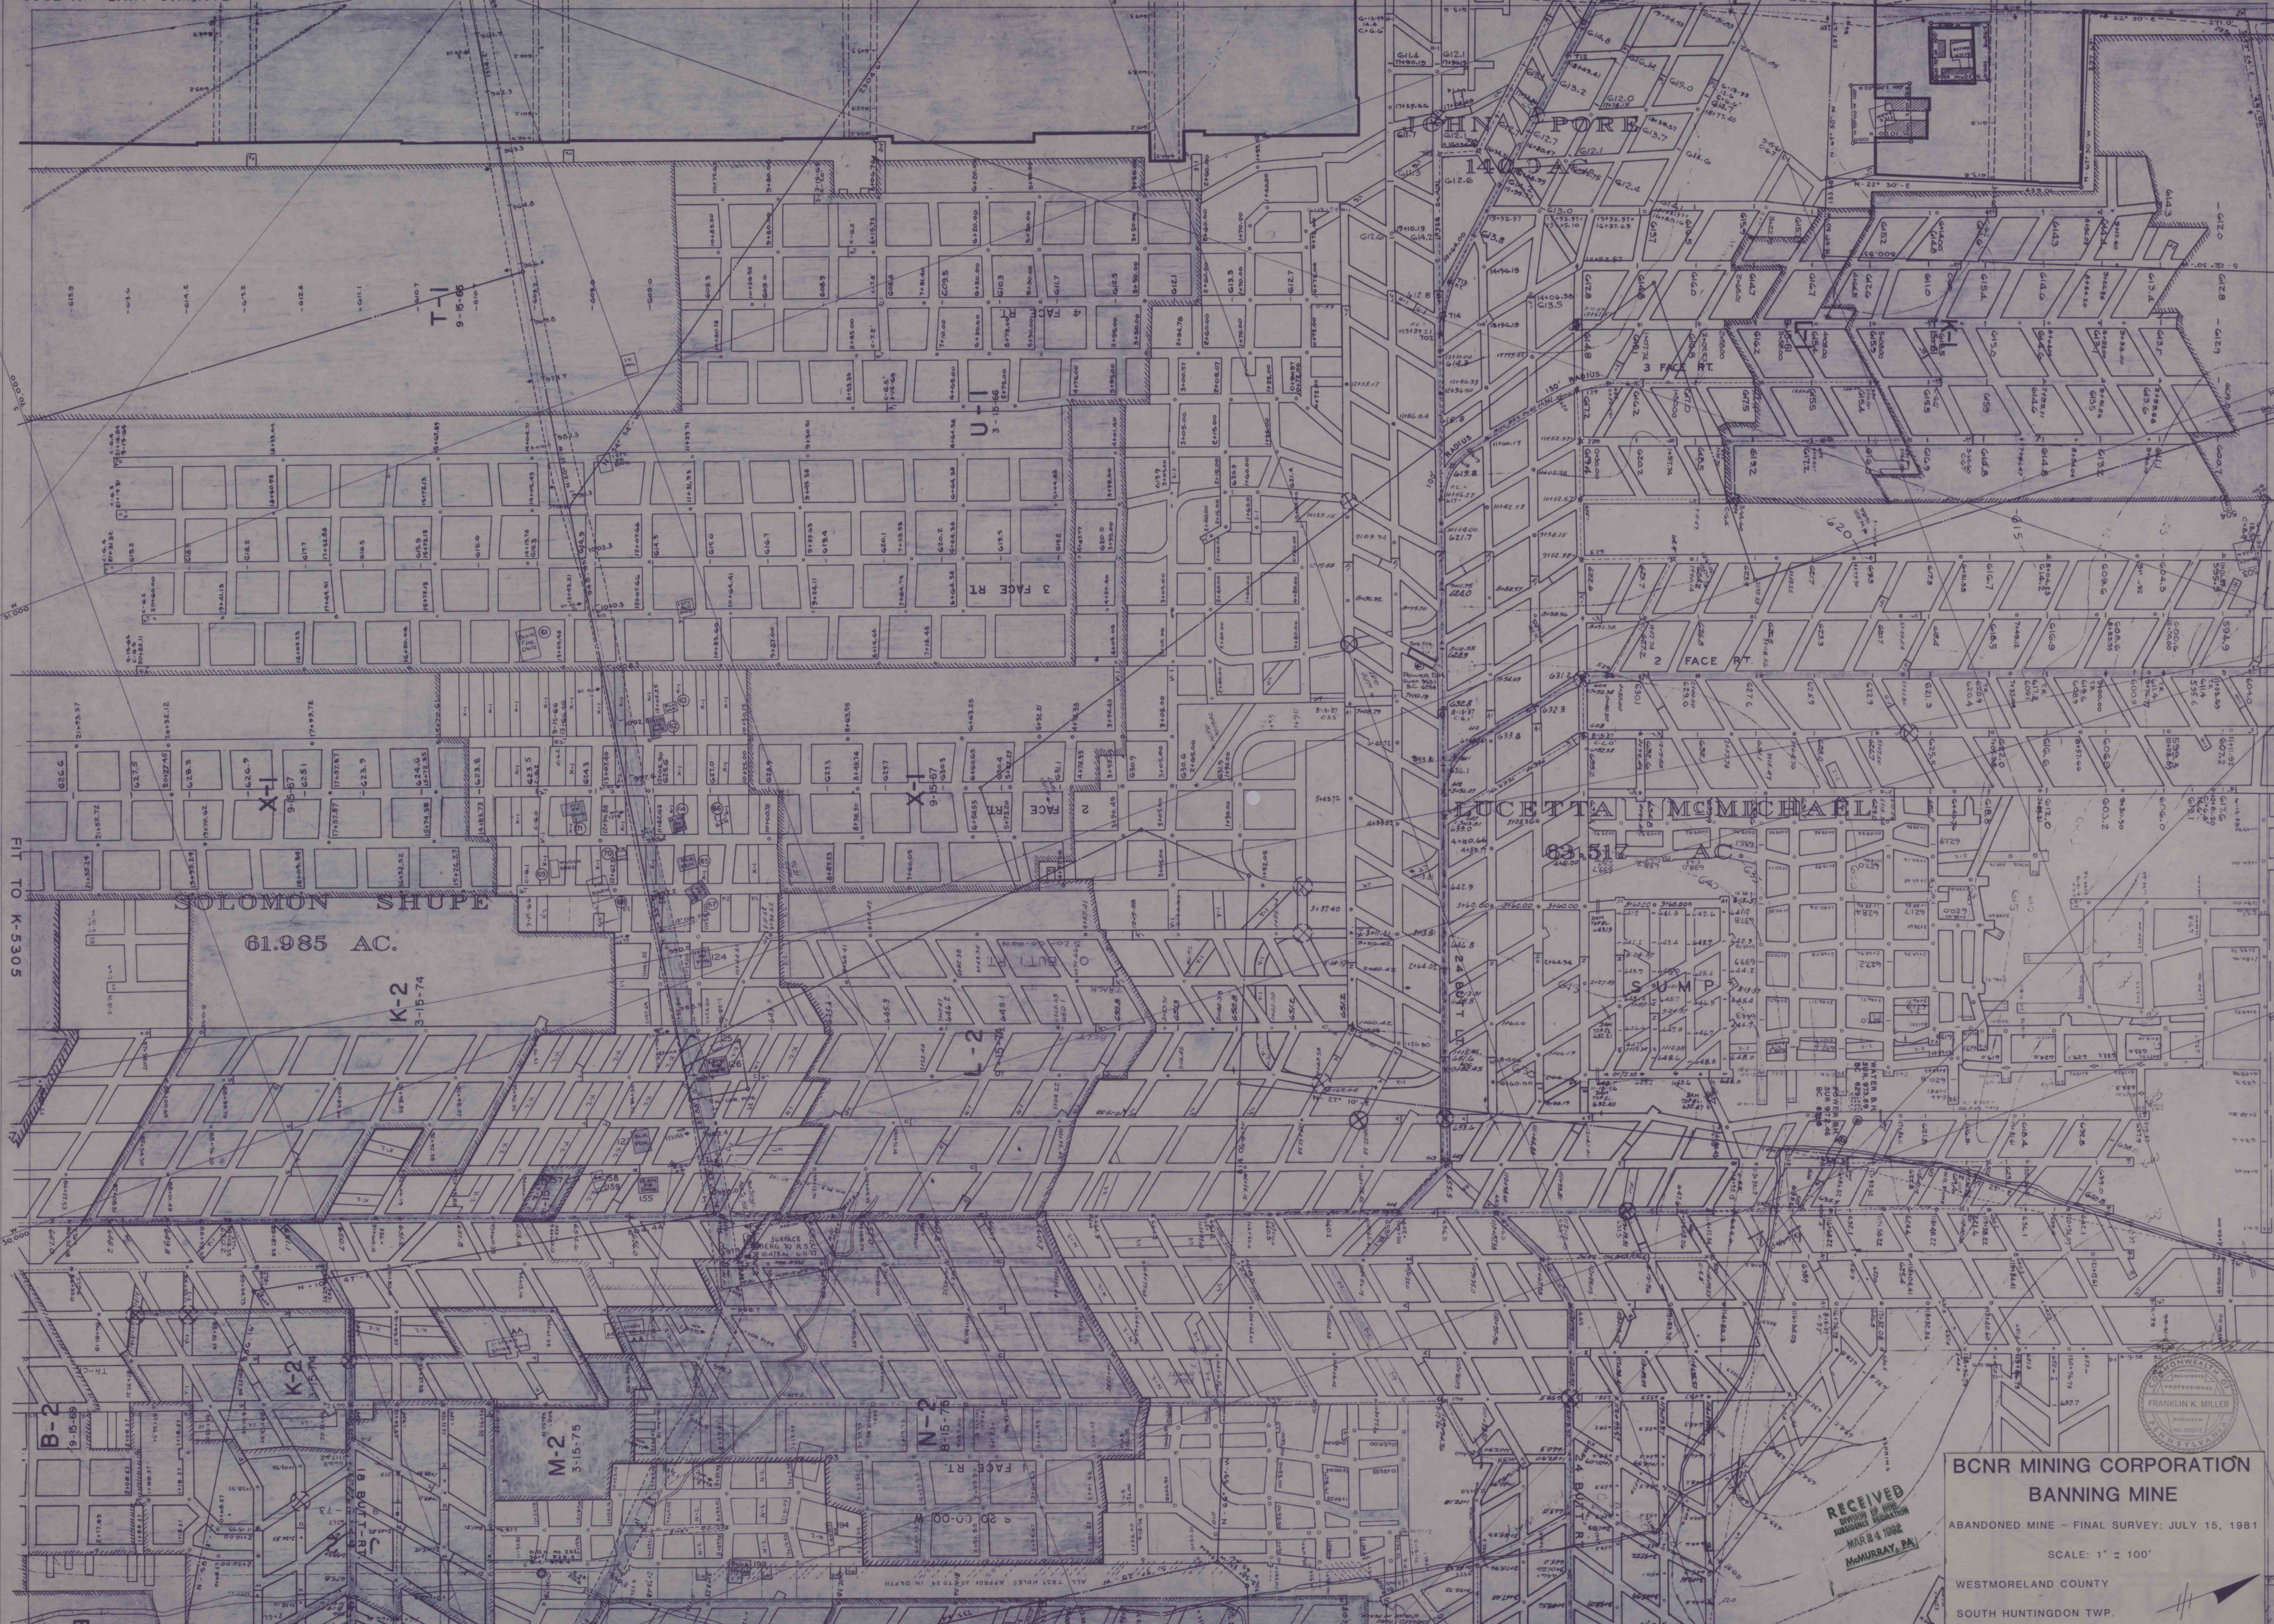

BCNR MINING CORPORATION
BANNING MINE

ABANDONED MINE - FINAL SURVEY: JULY 15, 1981

SCALE: 1" = 100'

WESTMORELAND COUNTY

SOUTH HUNTINGDON TWP.

BANNING MINE K-5306

RECEIVED
DIVISION OF MINES
AND GEOLOGY
MAR 24 1982
MCMURRAY, PA

IMAPS 19607