


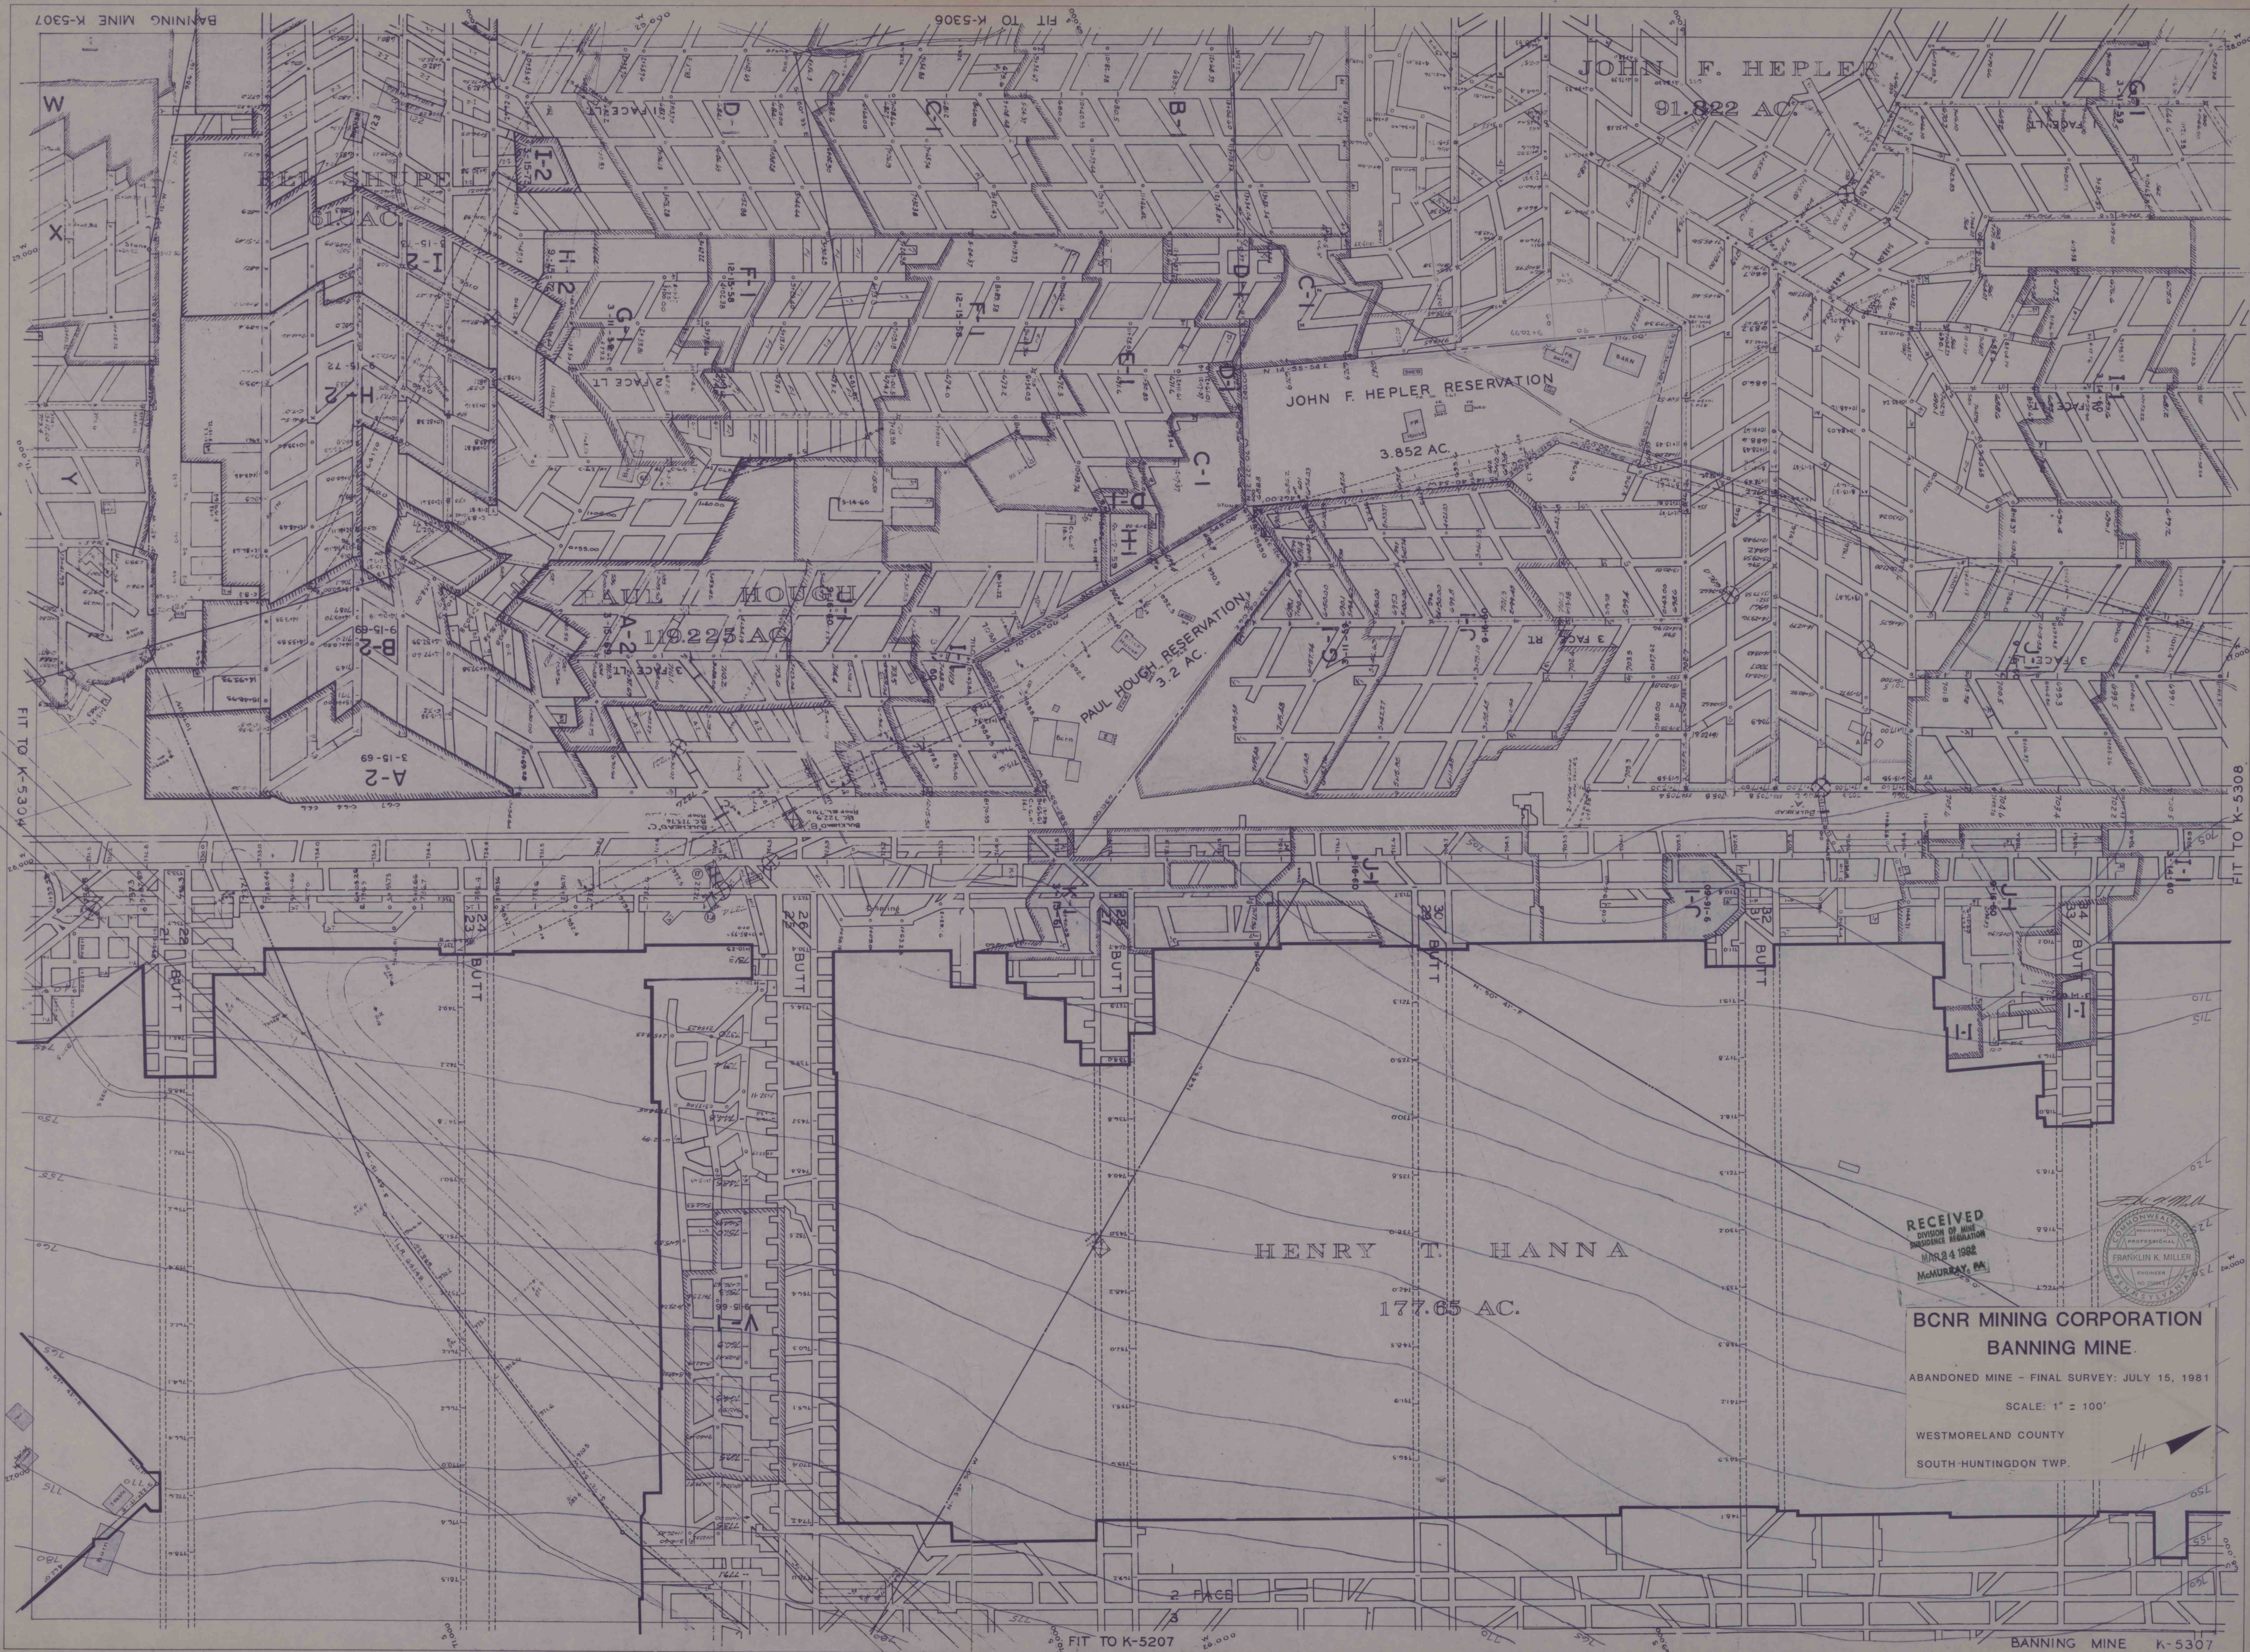

RECEIVED
DIVISION OF MINE
REGULATION
MAR 24 1982
McMURRAY, PA.



BCNR MINING CORPORATION
BANNING MINE.
ABANDONED MINE - FINAL SURVEY: JULY 15, 1981
SCALE: 1" = 100'
WESTMORELAND COUNTY
SOUTH HUNTINGDON TWP.

BANNING MINE K-5307