


FIT TO K-5412

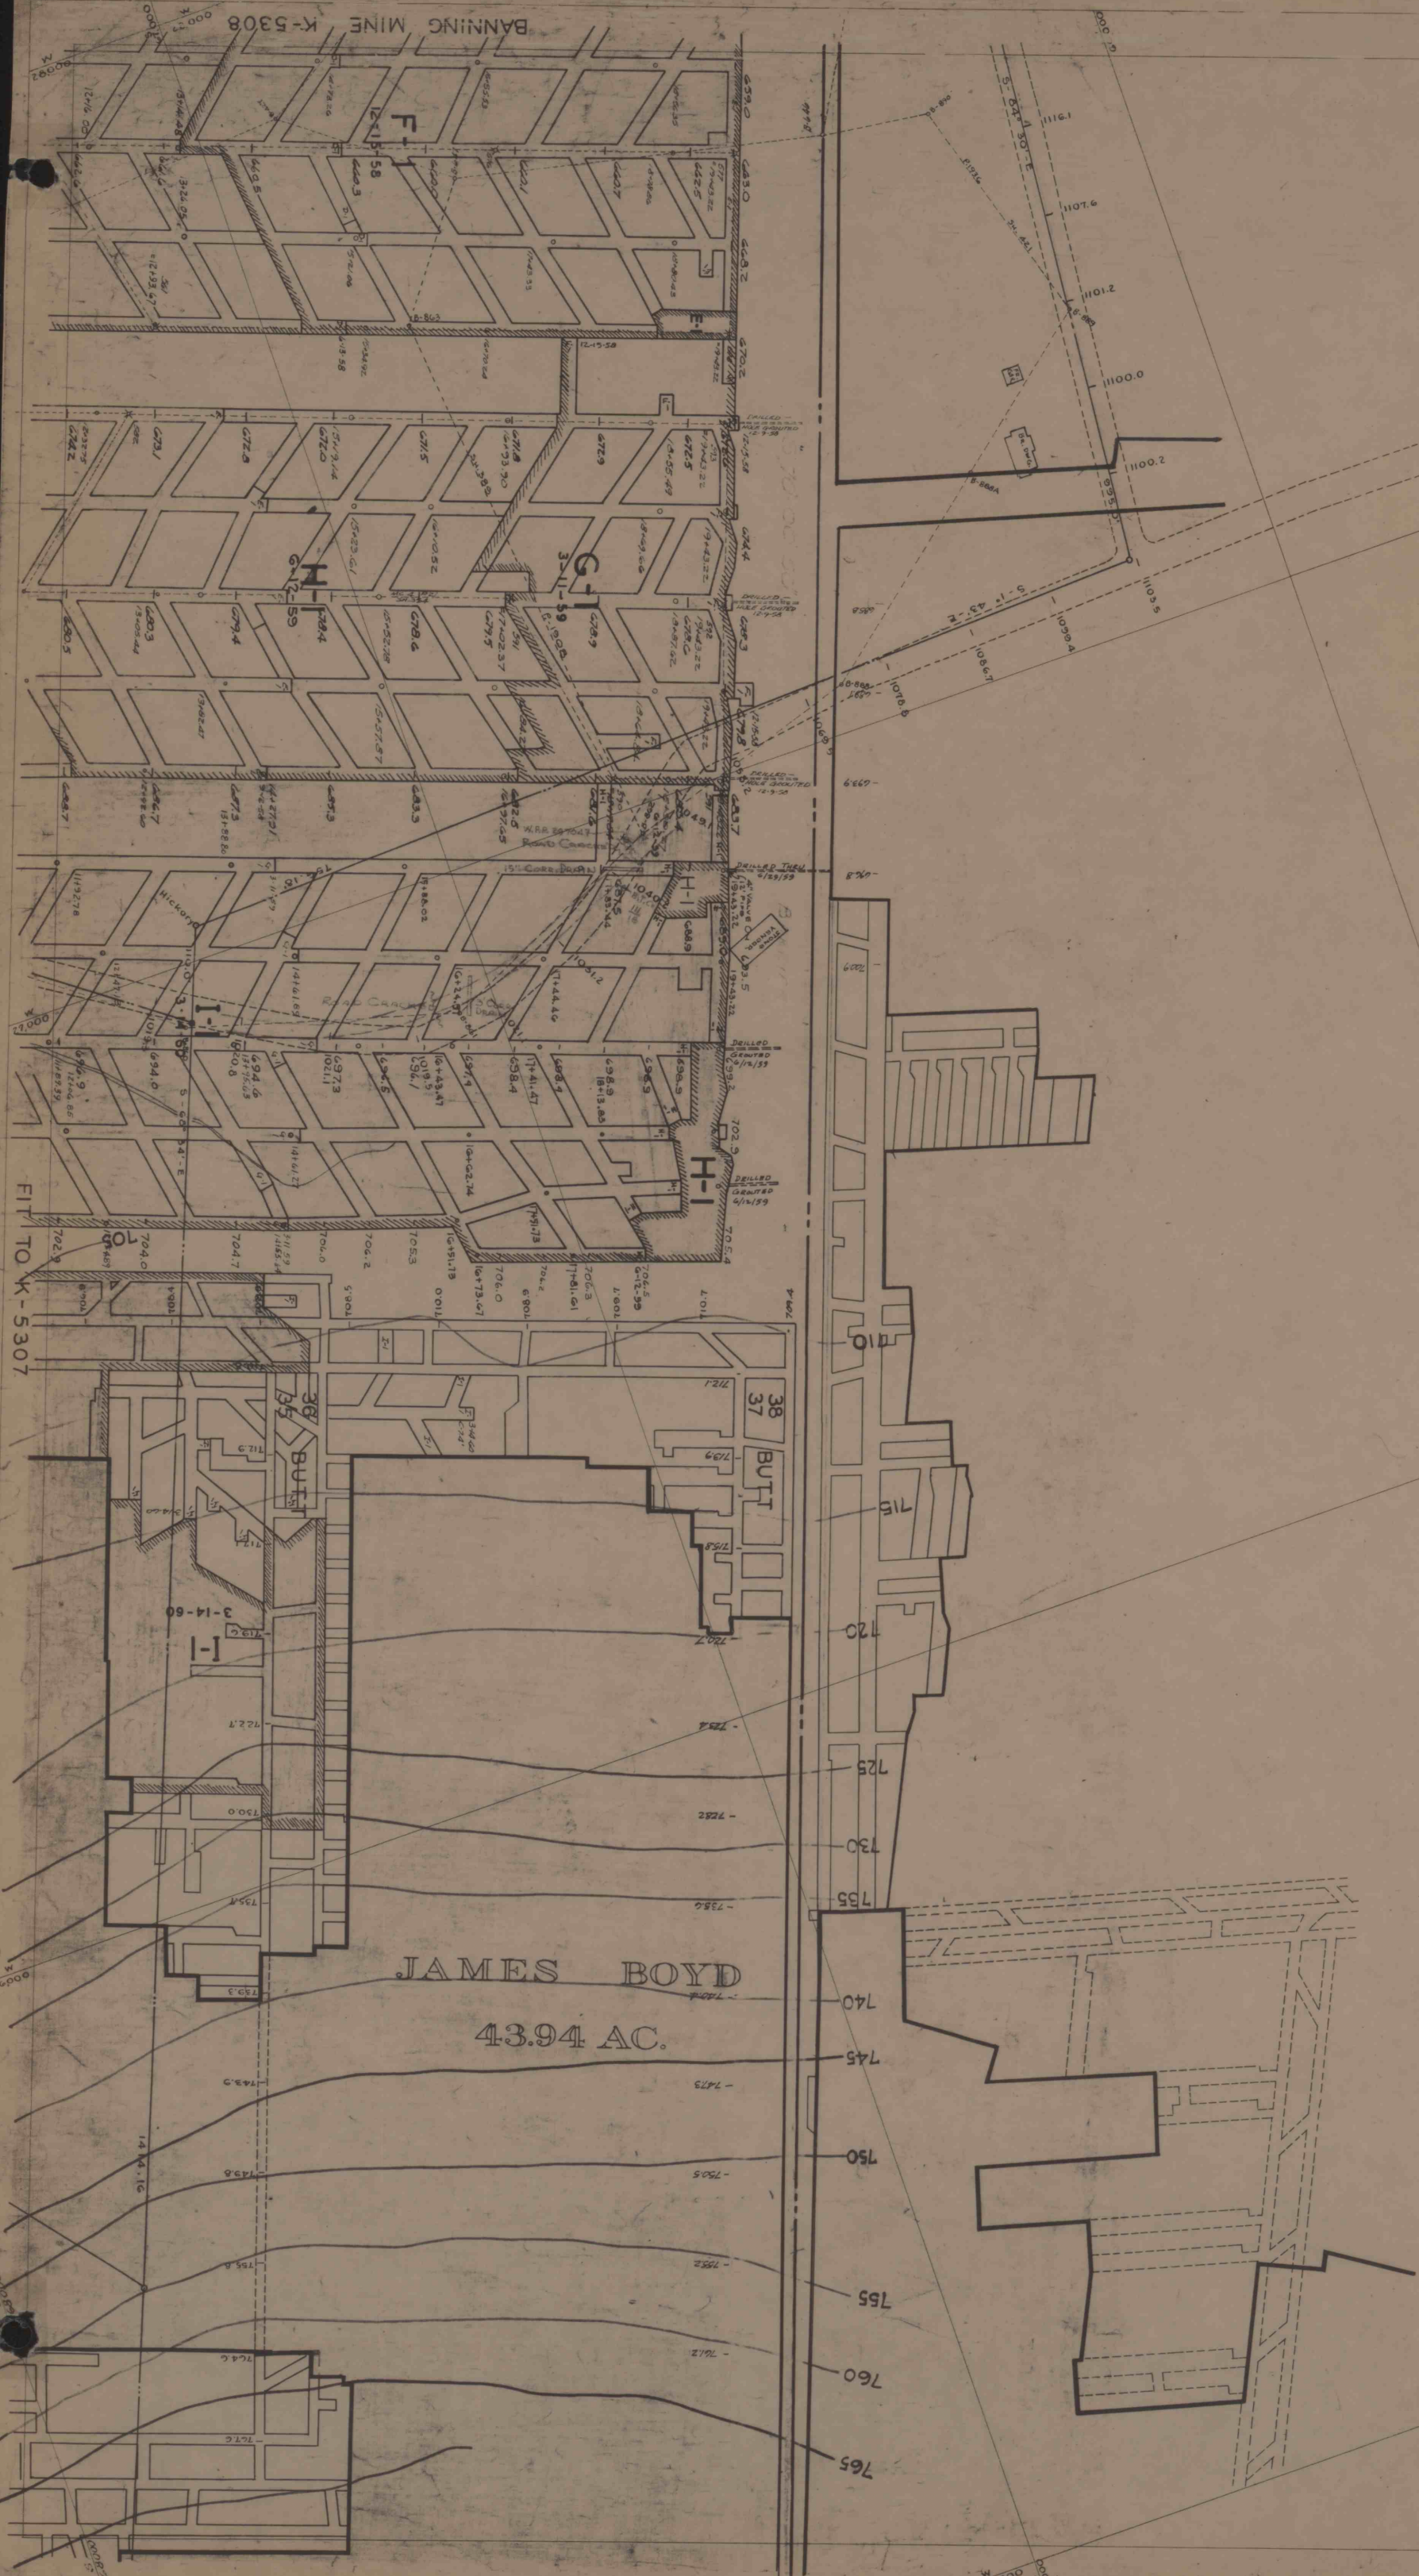

FIT TO K-5208

BANNING MINE K-5308