


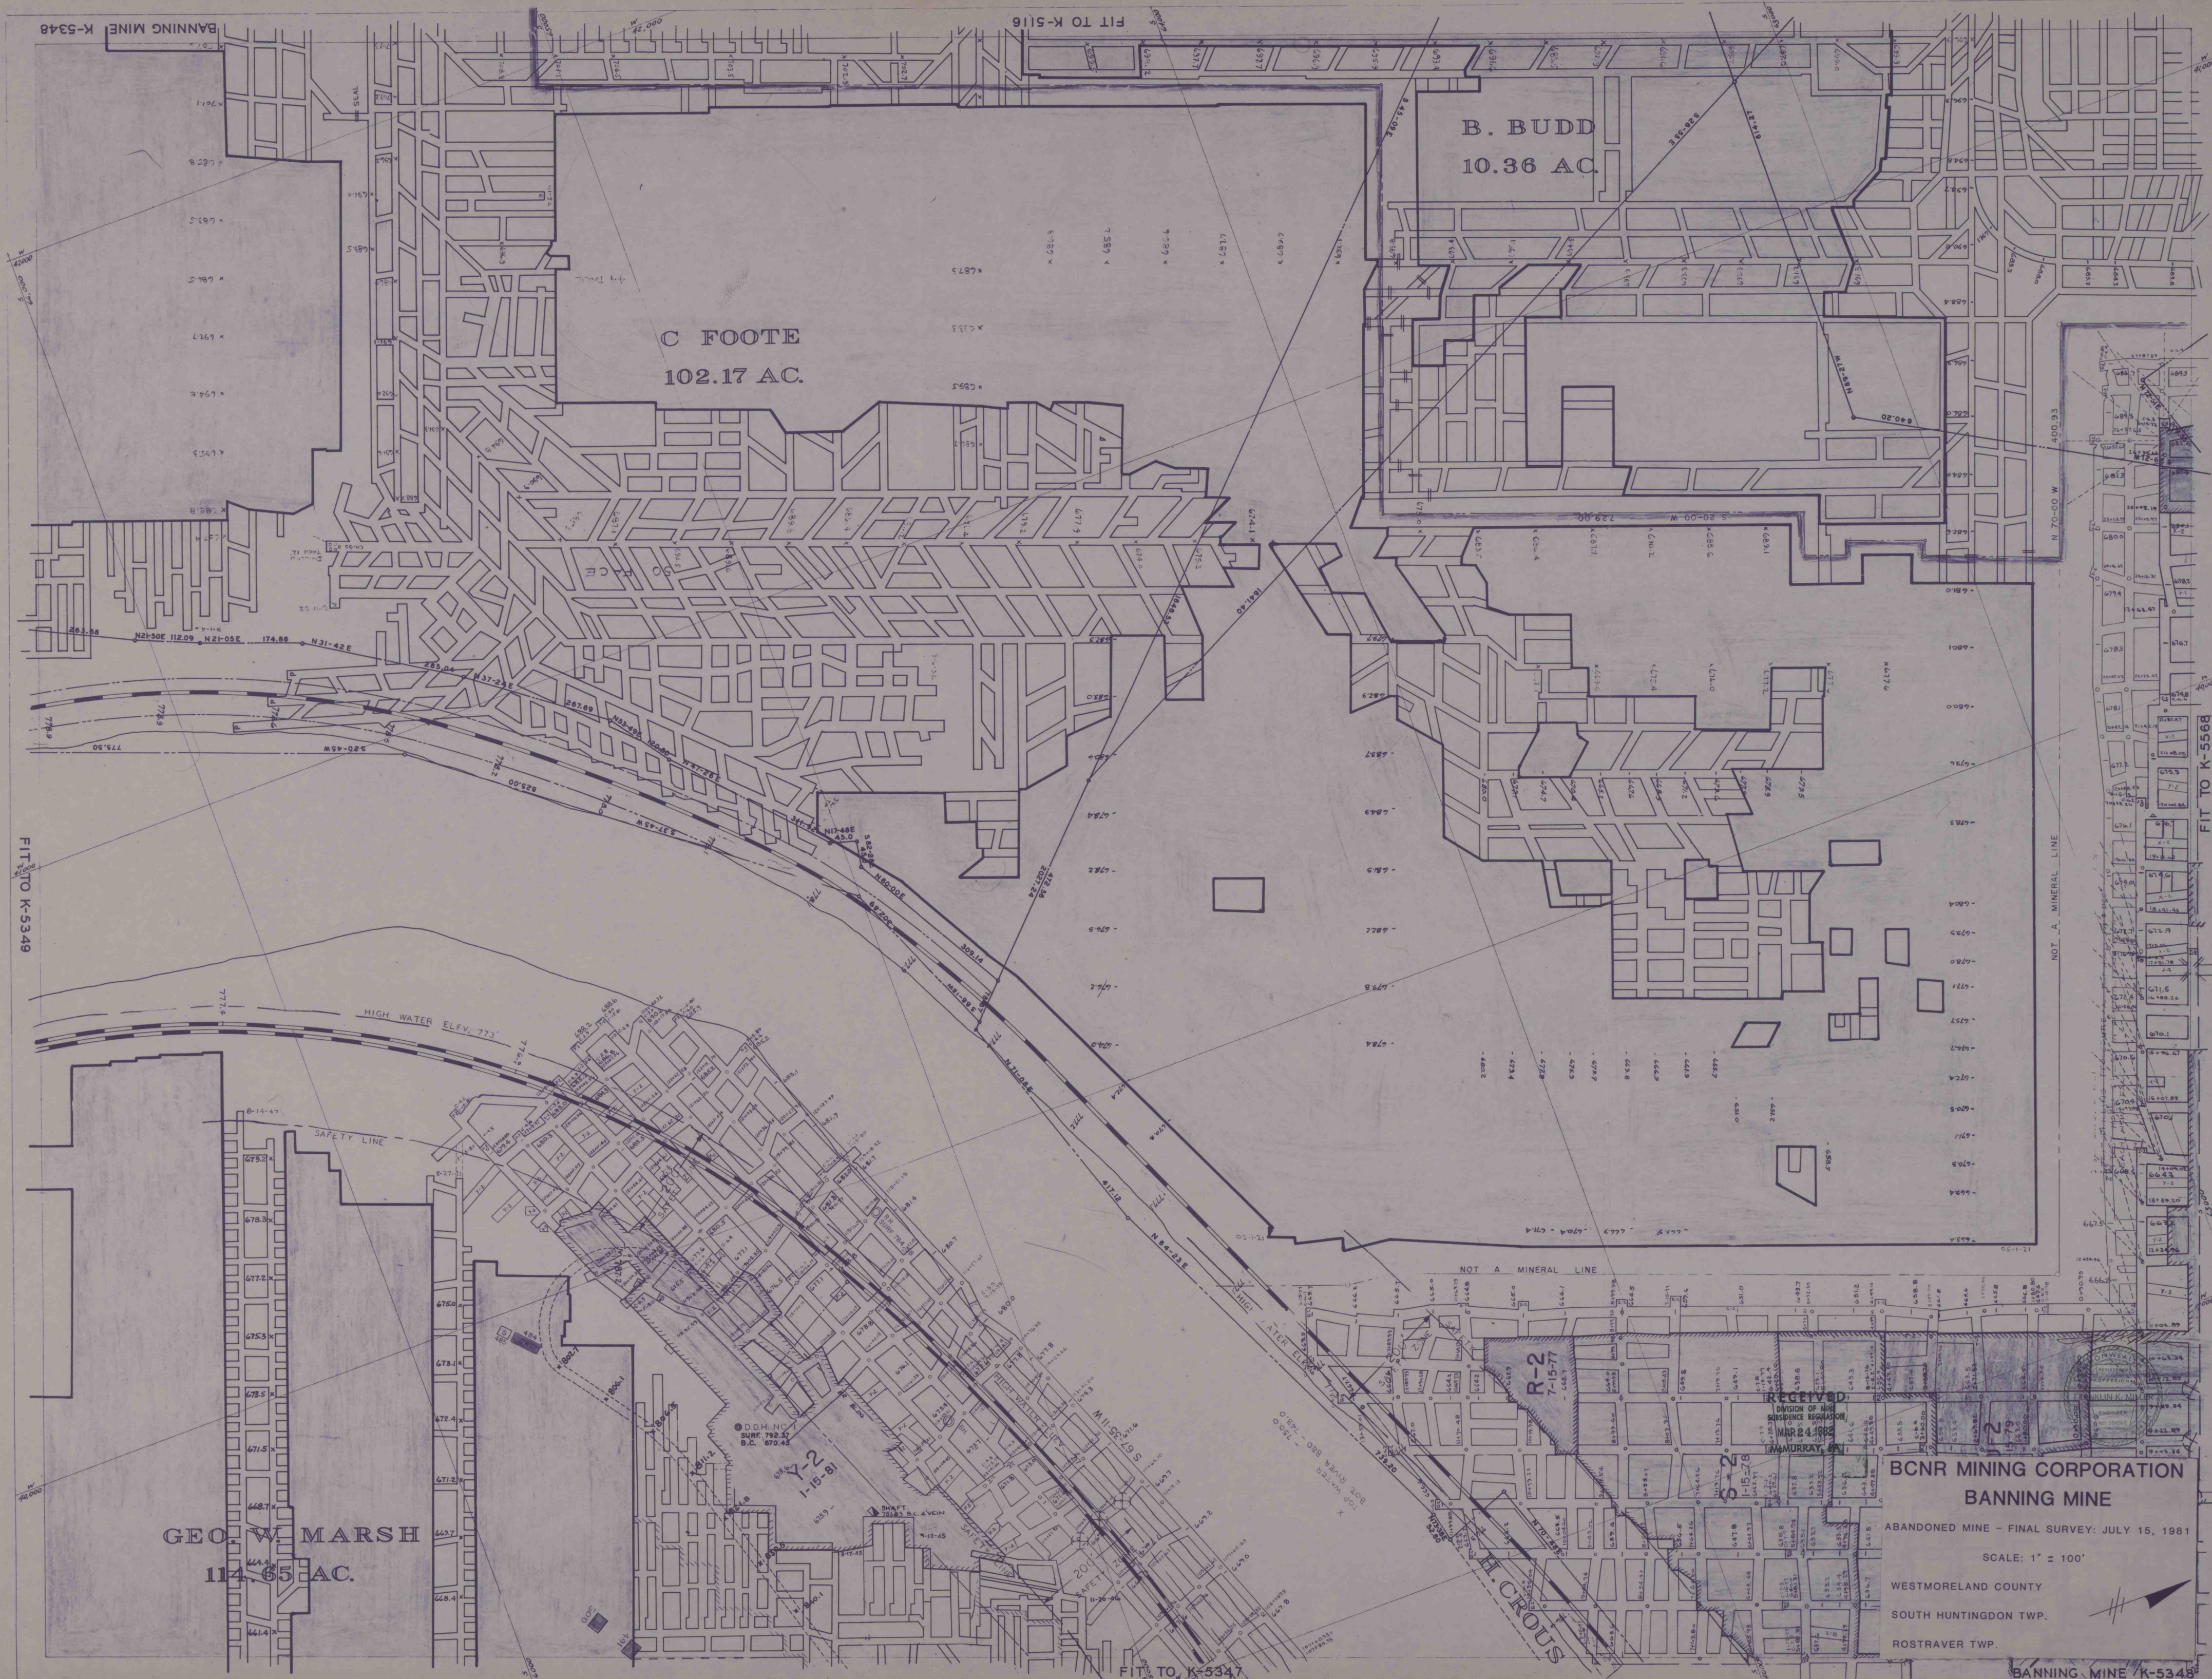

BANNING MINE K-5348

FIT TO K-5116

FIT TO K-5349

FIT TO K-5568

GEO. W. MARSH
114.65 AC.

C FOOTE
102.17 AC.

B. BUDD
10.36 AC.

BCNR MINING CORPORATION
BANNING MINE
ABANDONED MINE - FINAL SURVEY: JULY 15, 1981
SCALE: 1" = 100'
WESTMORELAND COUNTY
SOUTH HUNTINGDON TWP.
ROSTRAVER TWP.
BANNING MINE K-5348