




RECEIVED
DIVISION OF MINE
SUPERVISOR REGULATION
MAR 24 1982
McMURRAY, PA.

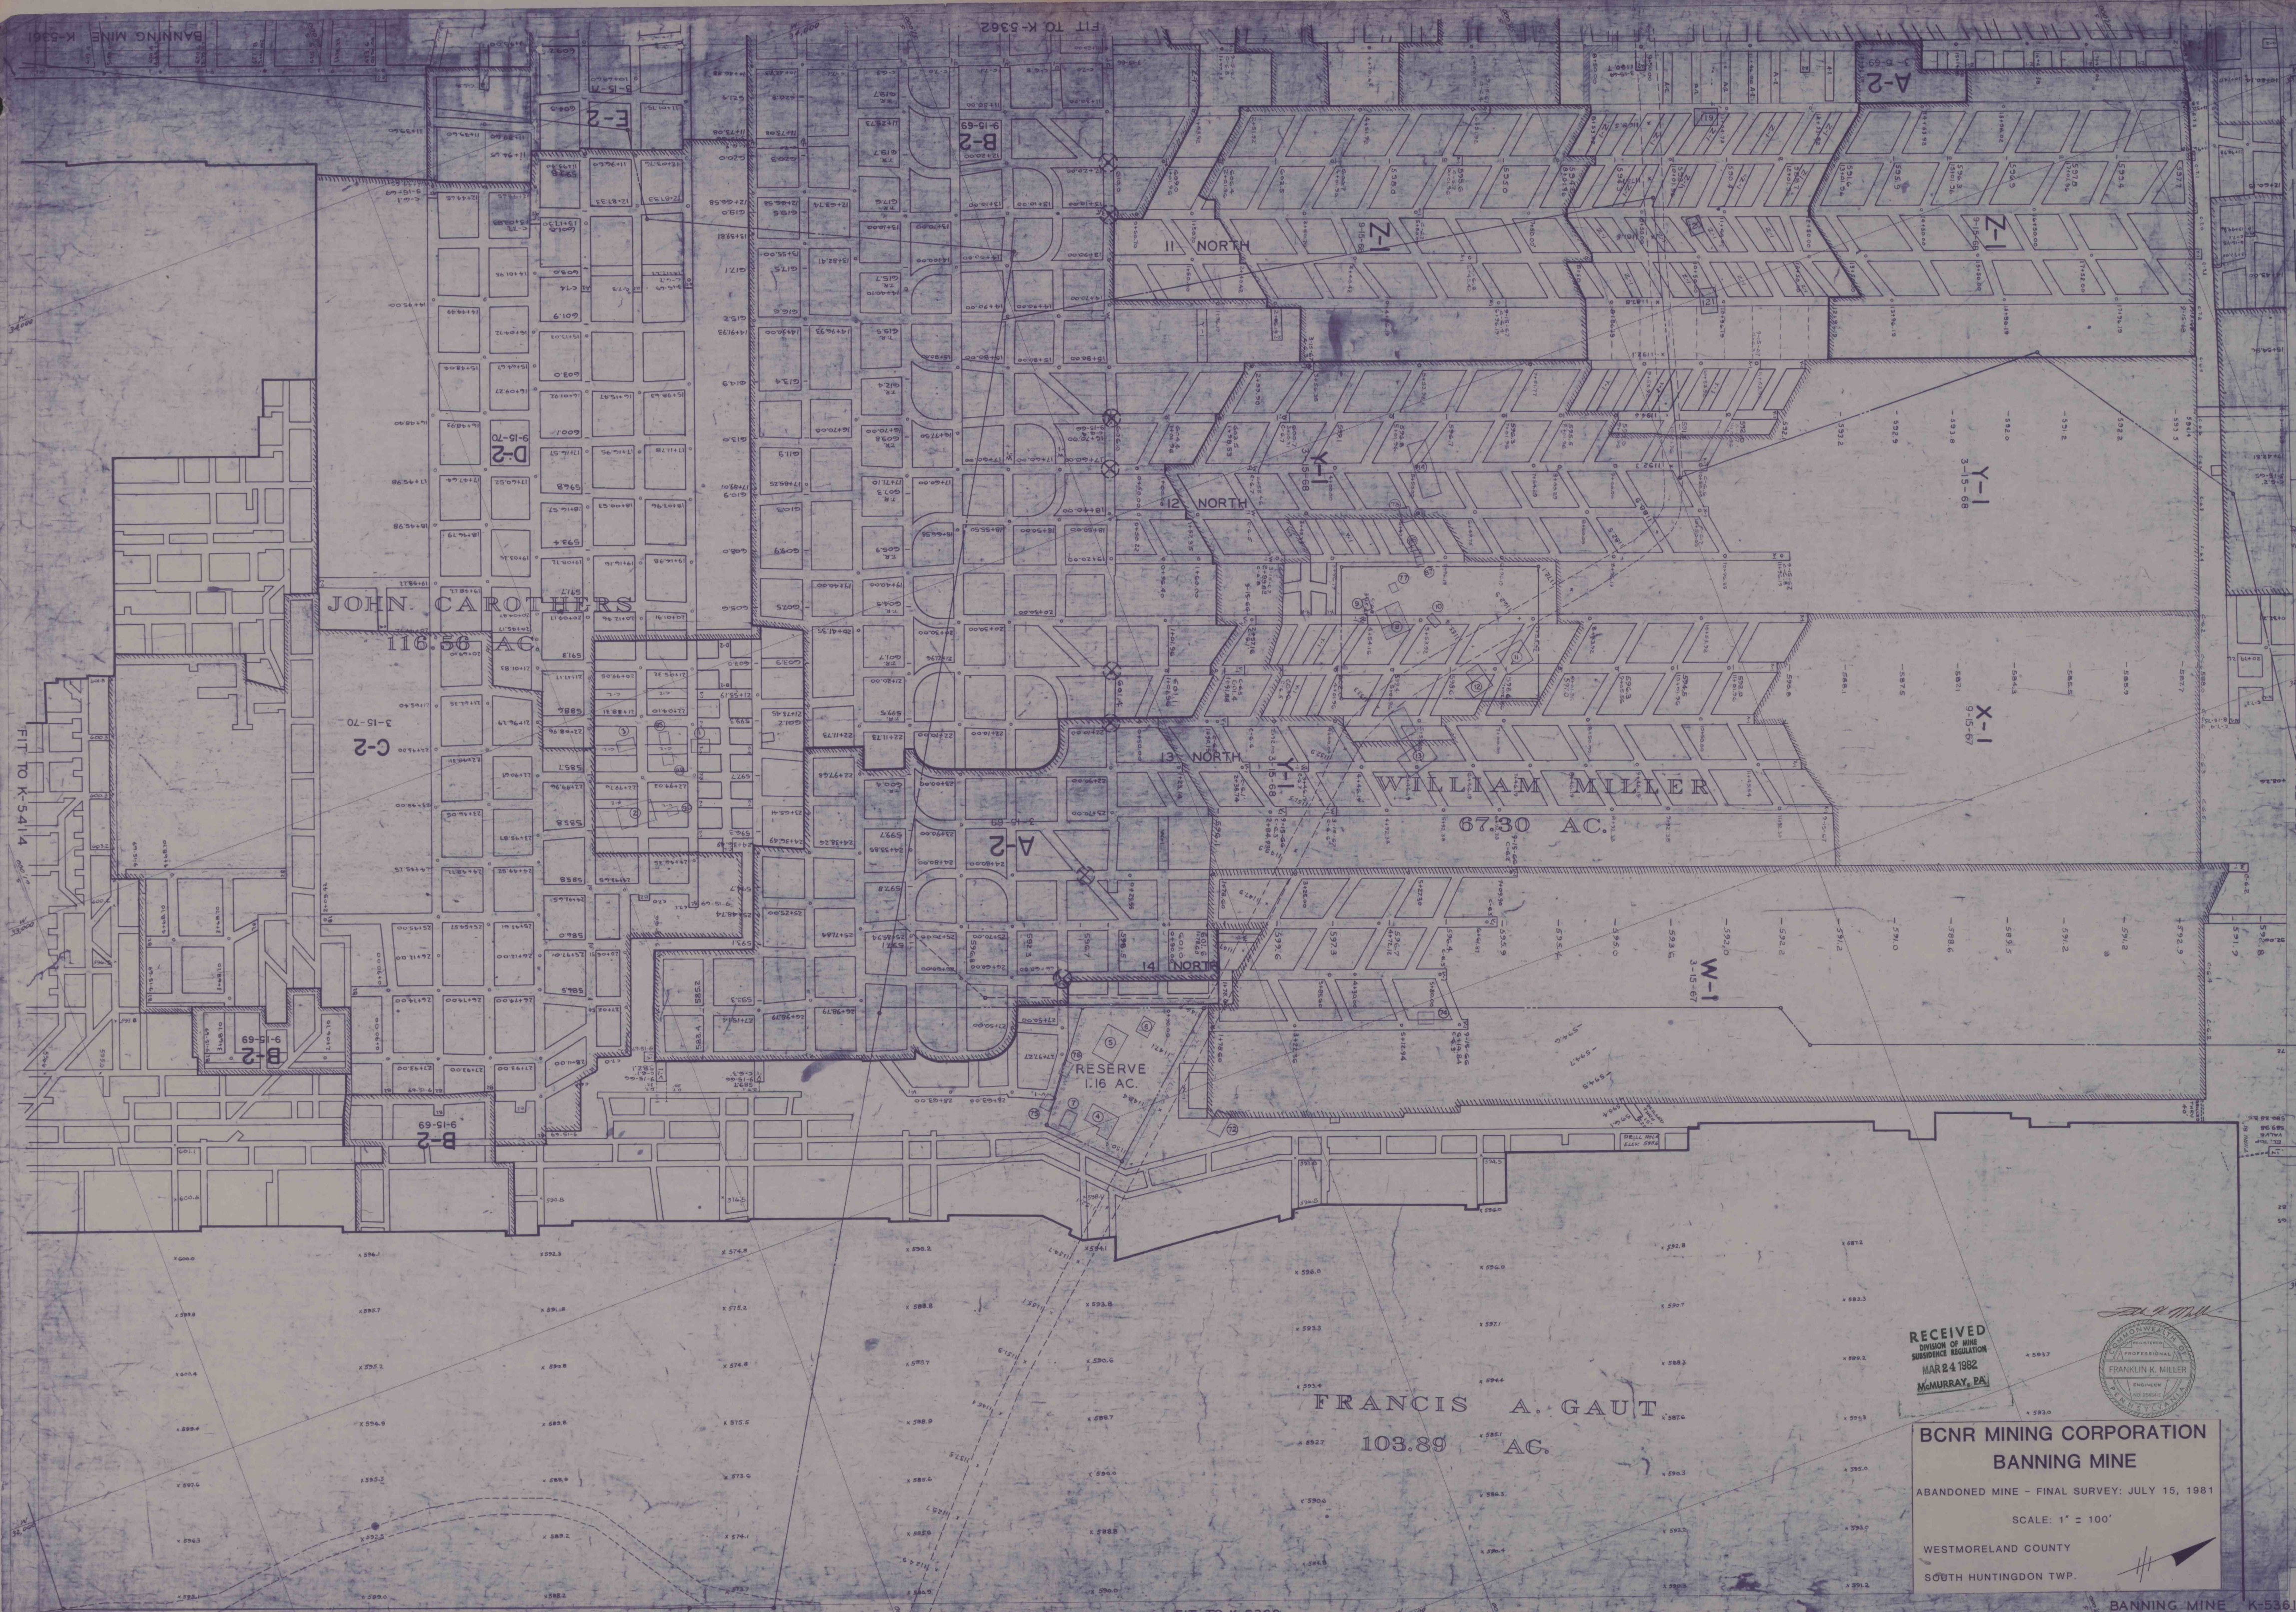

BCNR MINING CORPORATION
BANNING MINE
ABANDONED MINE - FINAL SURVEY: JULY 15, 1981
SCALE: 1" = 100'
WESTMORELAND COUNTY
SOUTH HUNTINGDON TWP.

FIT TO K-5360

BANNING MINE K-5361