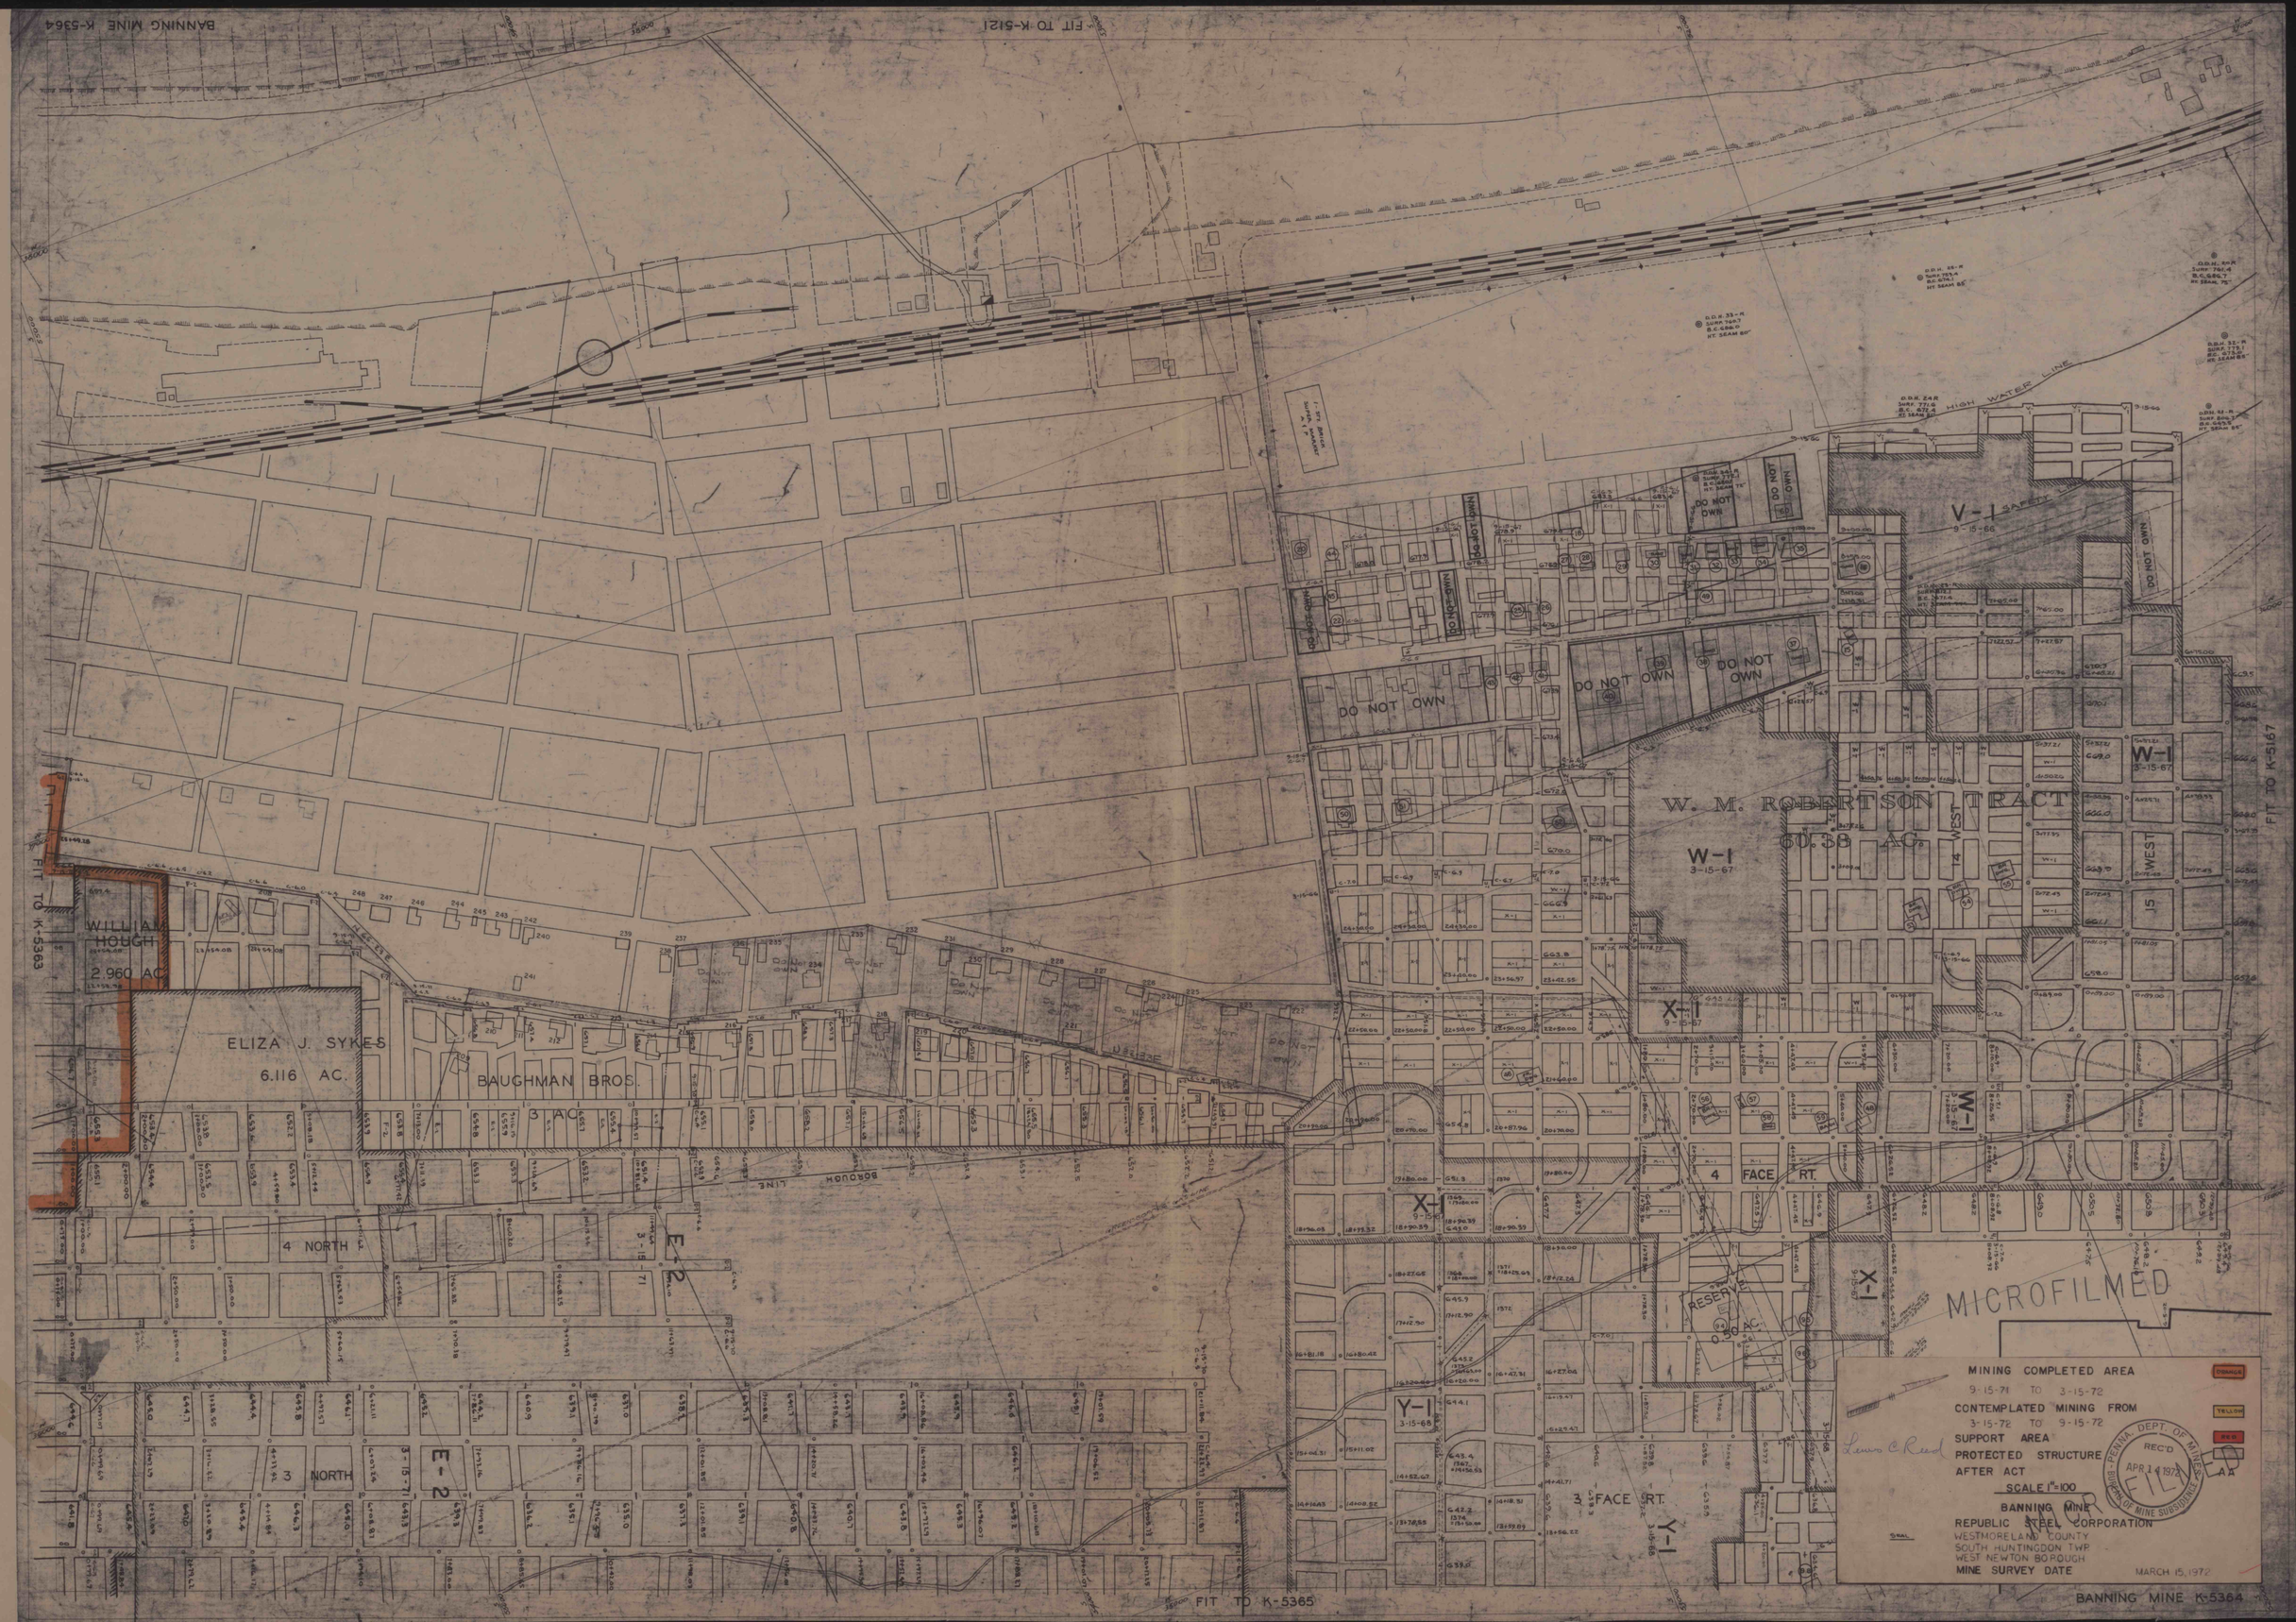
BANNING MINE K-5364
FIT TO K-5121
FIT TO K-5363
FIT TO K-5167
FIT TO K-5365
WILLIAM HOUGH
2.960 AC.
ELIZA J. SYKES
6.116 AC.
BAUGHMAN BROS.
3 AC.
BOROUGH LINE
4 NORTH
3 NORTH
E-2
3-15-71
DO NOT OWN
HIGH WATER LINE
V-1
9-15-66
W-1
3-15-67
W. M. ROBERTSON TRACT
60.38 AC.
14 WEST
15 WEST
X-1
9-15-67
4 FACE RT.
3 FACE RT.
Y-1
3-15-68
RESERVE
0.50 AC.
MICROFILMED
MINING COMPLETED AREA
9-15-71 TO 3-15-72
ORANGE
CONTEMPLATED MINING FROM
3-15-72 TO 9-15-72
YELLOW
SUPPORT AREA
PROTECTED STRUCTURE
AFTER ACT
RED
SCALE 1"=100'
BANNING MINE
REPUBLIC STEEL CORPORATION
WESTMORELAND COUNTY
SOUTH HUNTINGDON TWP.
WEST NEWTON BOROUGH
MINE SURVEY DATE
MARCH 15, 1972
PENNA. DEPT. OF MINES
REC'D
APR 14 1972
BUREAU OF MINE SUBSIDENCE
FILE
BANNING MINE K-5364