


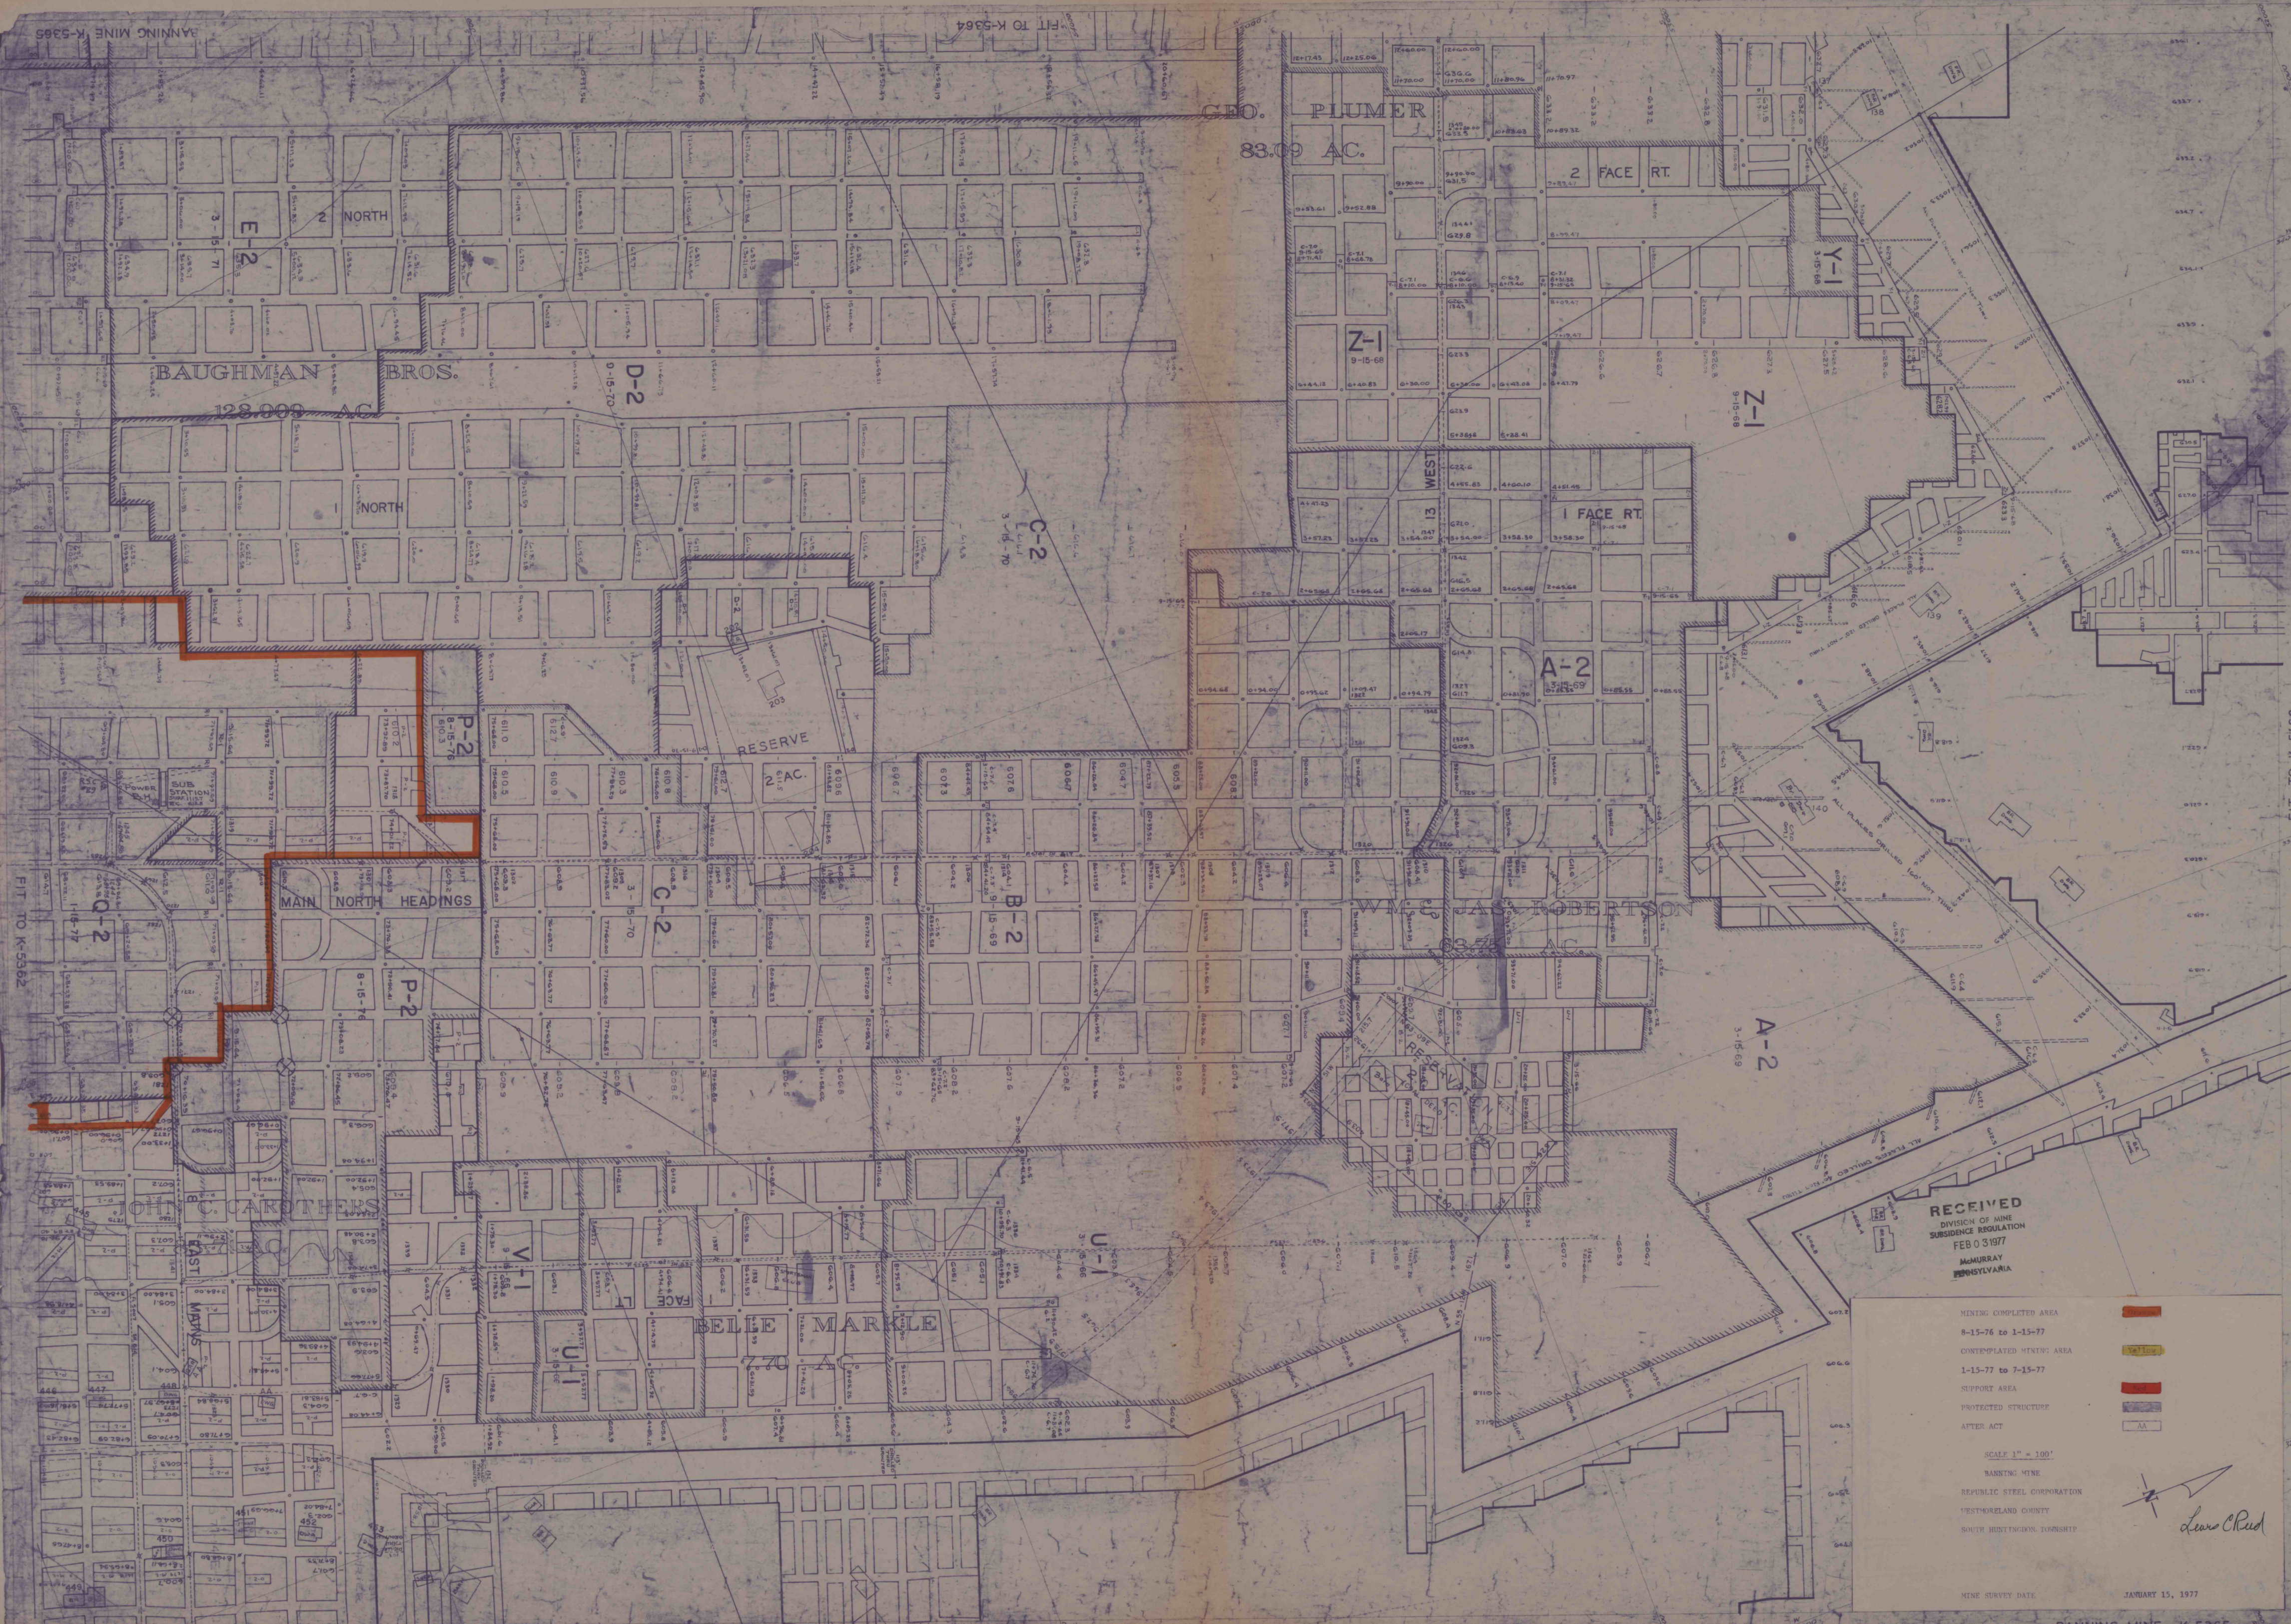

RECEIVED
DIVISION OF MINE
SUBSISTENCE REGULATION
FEB 03 1977
McMURRAY
PENNSYLVANIA

- MINE COMPLETED AREA
- 8-15-76 to 1-15-77
- CONTEMPLATED MINE AREA
- 1-15-77 to 7-15-77
- SUPPORT AREA
- PROTECTED STRUCTURE
- AFTER ACT

SCALE 1" = 100'

BANNING MINE
REPUBLIC STEEL CORPORATION
WESTMORELAND COUNTY
SOUTH HUNTINGDON TOWNSHIP

MINE SURVEY DATE

JANUARY 15, 1977

BANNING MINE K-5365

FIT TO K-5462

FIT TO K-5168

Leone C. Reed