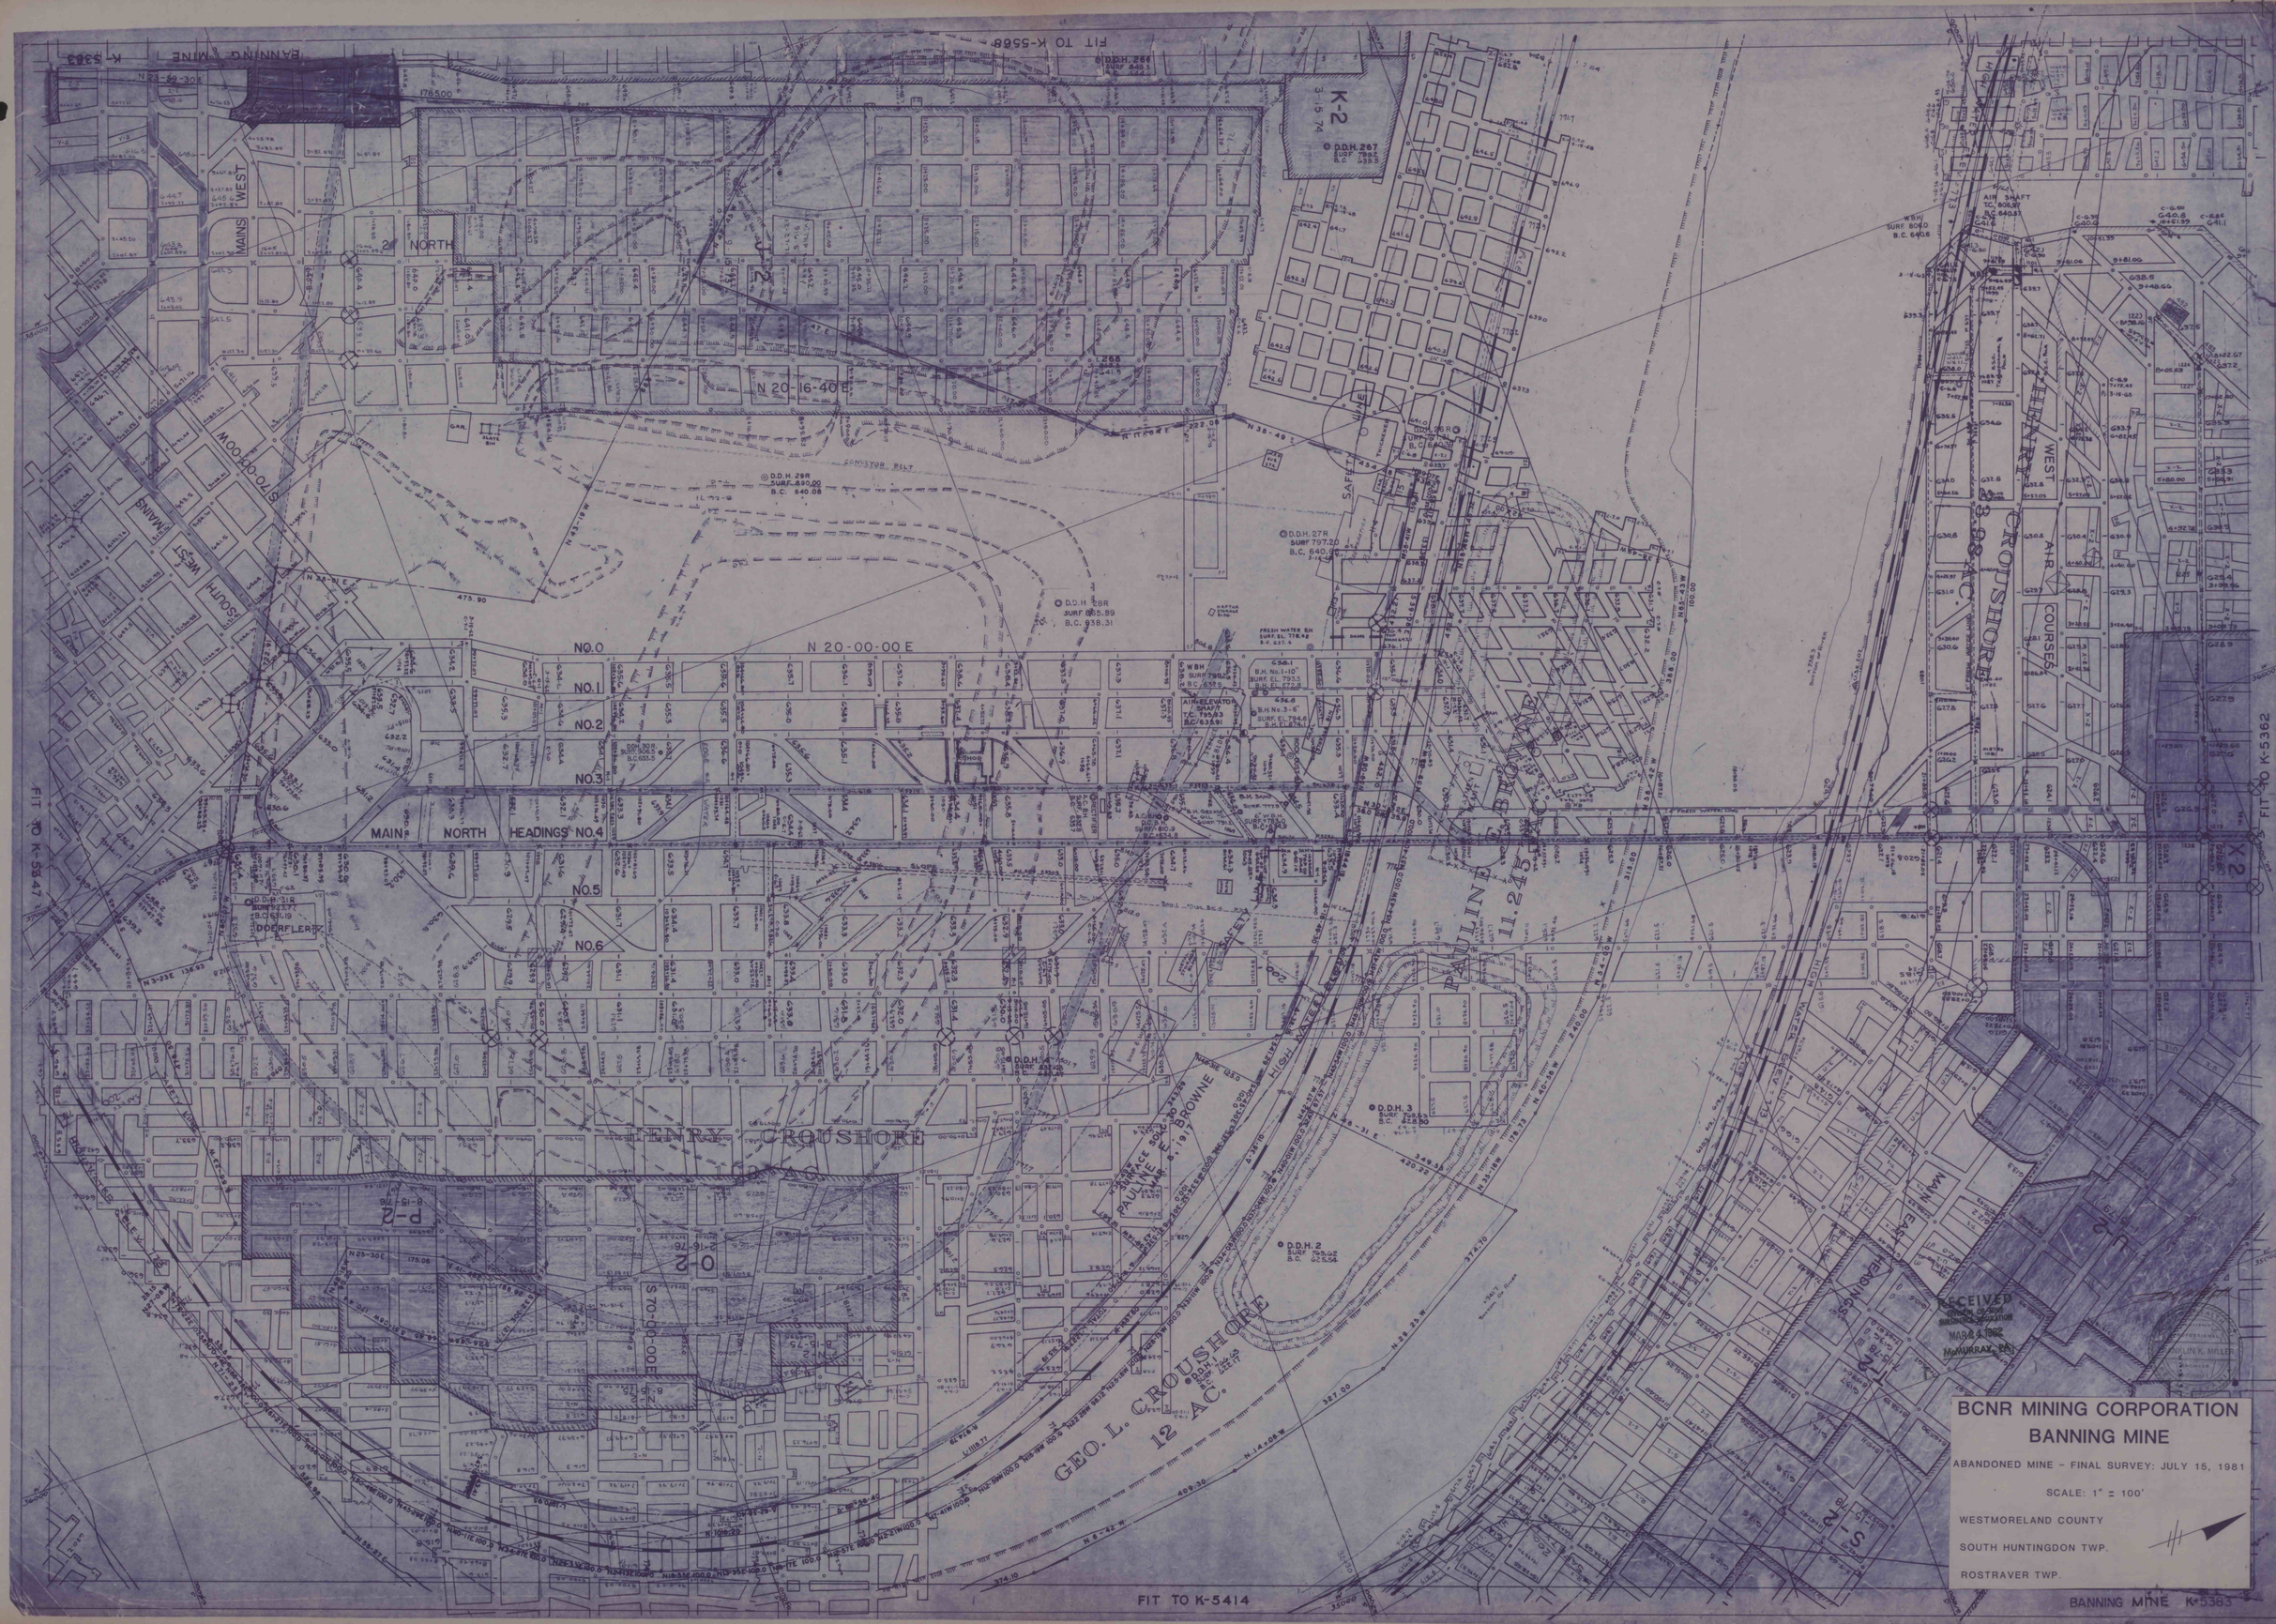
BCNR MINING CORPORATION
BANNING MINE
ABANDONED MINE - FINAL SURVEY: JULY 15, 1981
SCALE: 1" = 100'
WESTMORELAND COUNTY
SOUTH HUNTINGDON TWP.
ROSTRAVER TWP.
RECEIVED
MAR 4 1982
McMURRAY, PA.
BANNING MINE K-5363
FIT TO K-5414
FIT TO K-5547
FIT TO K-5362
FIT TO K-5568
BANNING MINE K-5363
MAINS WEST
SOUTH WEST
NORTH
N 20-16-40 E
N 20-00-00 E
NO.0
NO.1
NO.2
NO.3
NO.4
NO.5
NO.6
MAIN NORTH HEADINGS
CONVEYOR BELT
AIR-ELEVATOR SHAFT
FRESH WATER SH.
HENRY CROUSHORE
16 AC.
GEO. L. CROUSHORE
12 AC.
PAULINE E. BROWNE
11.245
HIGH WATER ELEV.
SURFACE SOUTH OF PAULINE E. BROWNE
CROUSHORE
AIR COURSES
EAST
WEST
MAIN
HEADINGS
K-2
X-2
O-2
P-2
DDH 267
DDH 268
DDH 29R
DDH 27R
DDH 28R
DDH 2
DDH 3
DDH 5
DDH 6
