


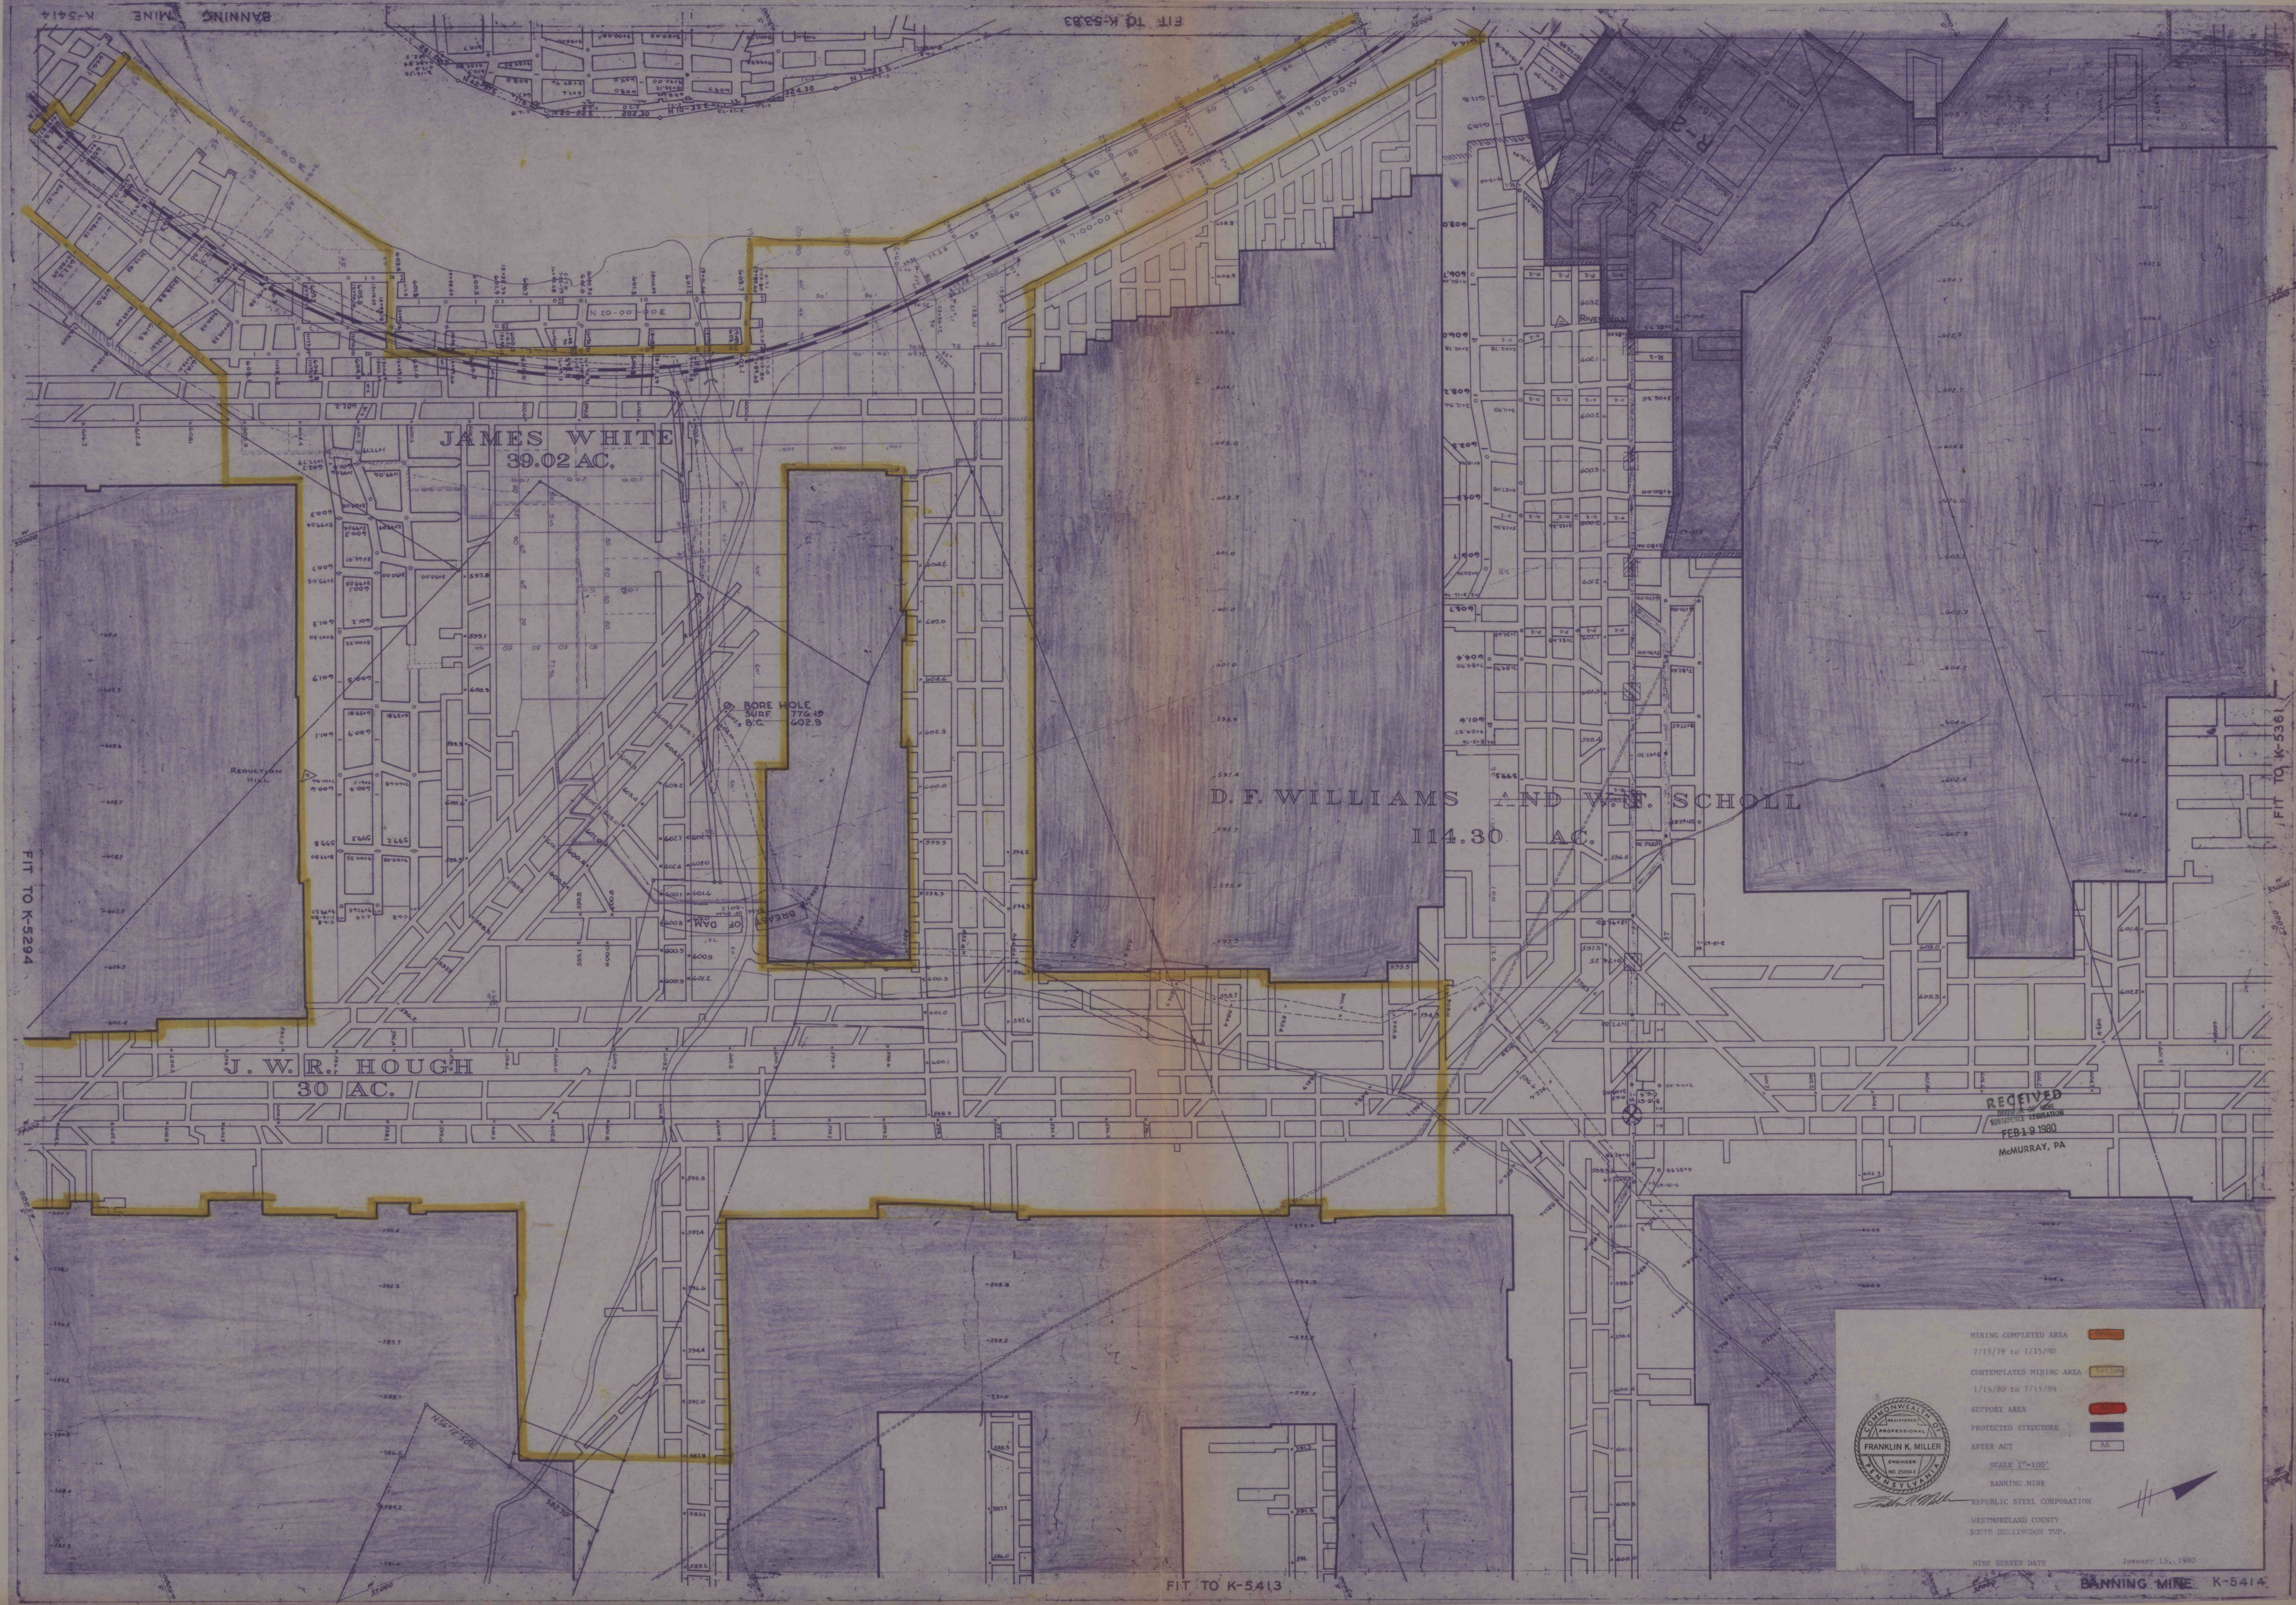

MINING COMPLETED AREA 7/15/79 to 1/15/80
CONTINGENT MINING AREA 1/15/80 to 7/15/80
SUPPORT AREA
PROTECTED STRUCTURE
AFTER ACT

SCALE 1"=100'

BANKING MINE
REPUBLIC STEEL CORPORATION
WESTMORELAND COUNTY
SOUTH HILLINGTON TWP.

MINE SURVEY DATE January 15, 1980

RECEIVED
DEPARTMENT OF REVENUE
FEB 19 1980
McMURRAY, PA

FRANKLIN K. MILLER
PROFESSIONAL ENGINEER
NO. 25054
PENNSYLVANIA

FIT TO K-5413

BANKING MINE K-5414