


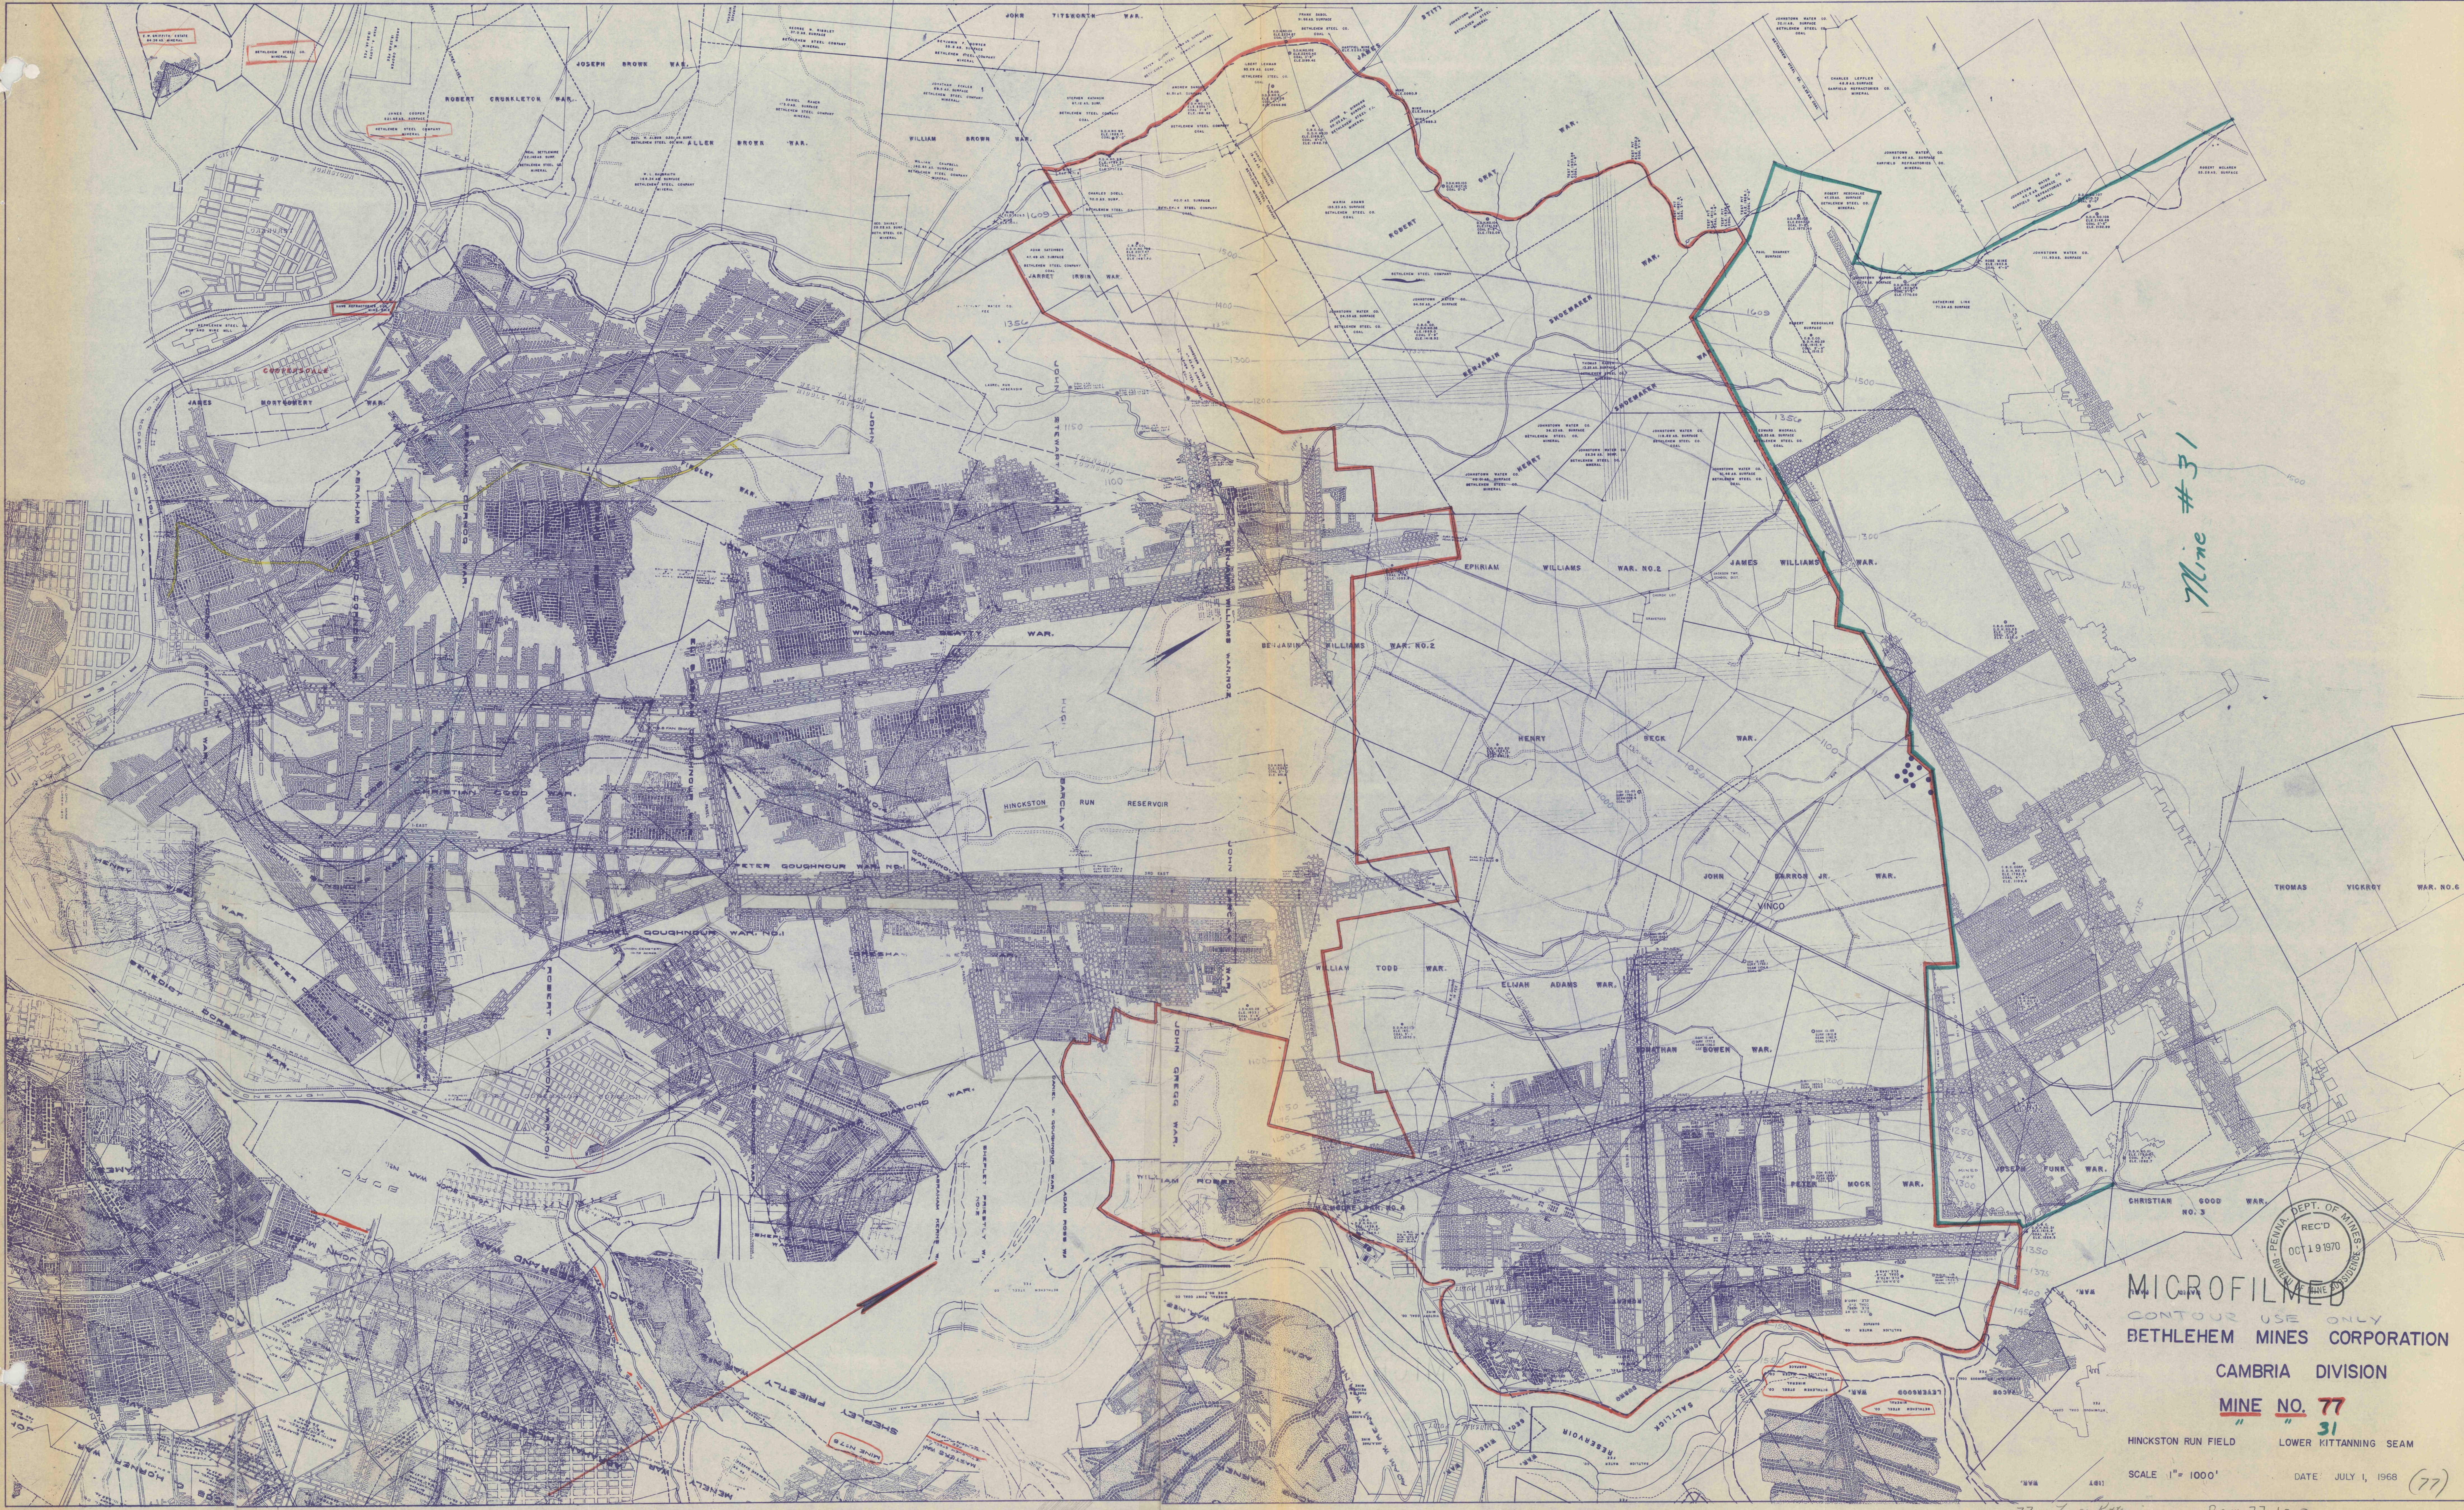

Mine #31

REC'D
OCT 19 1970

MICROFILMED
CONTOUR USE ONLY
BETHLEHEM MINES CORPORATION
CAMBRIA DIVISION
MINE NO. 77
" 31"
HINKSTON RUN FIELD LOWER KITTANNING SEAM
SCALE 1" = 1000' DATE: JULY 1, 1968 (77)