


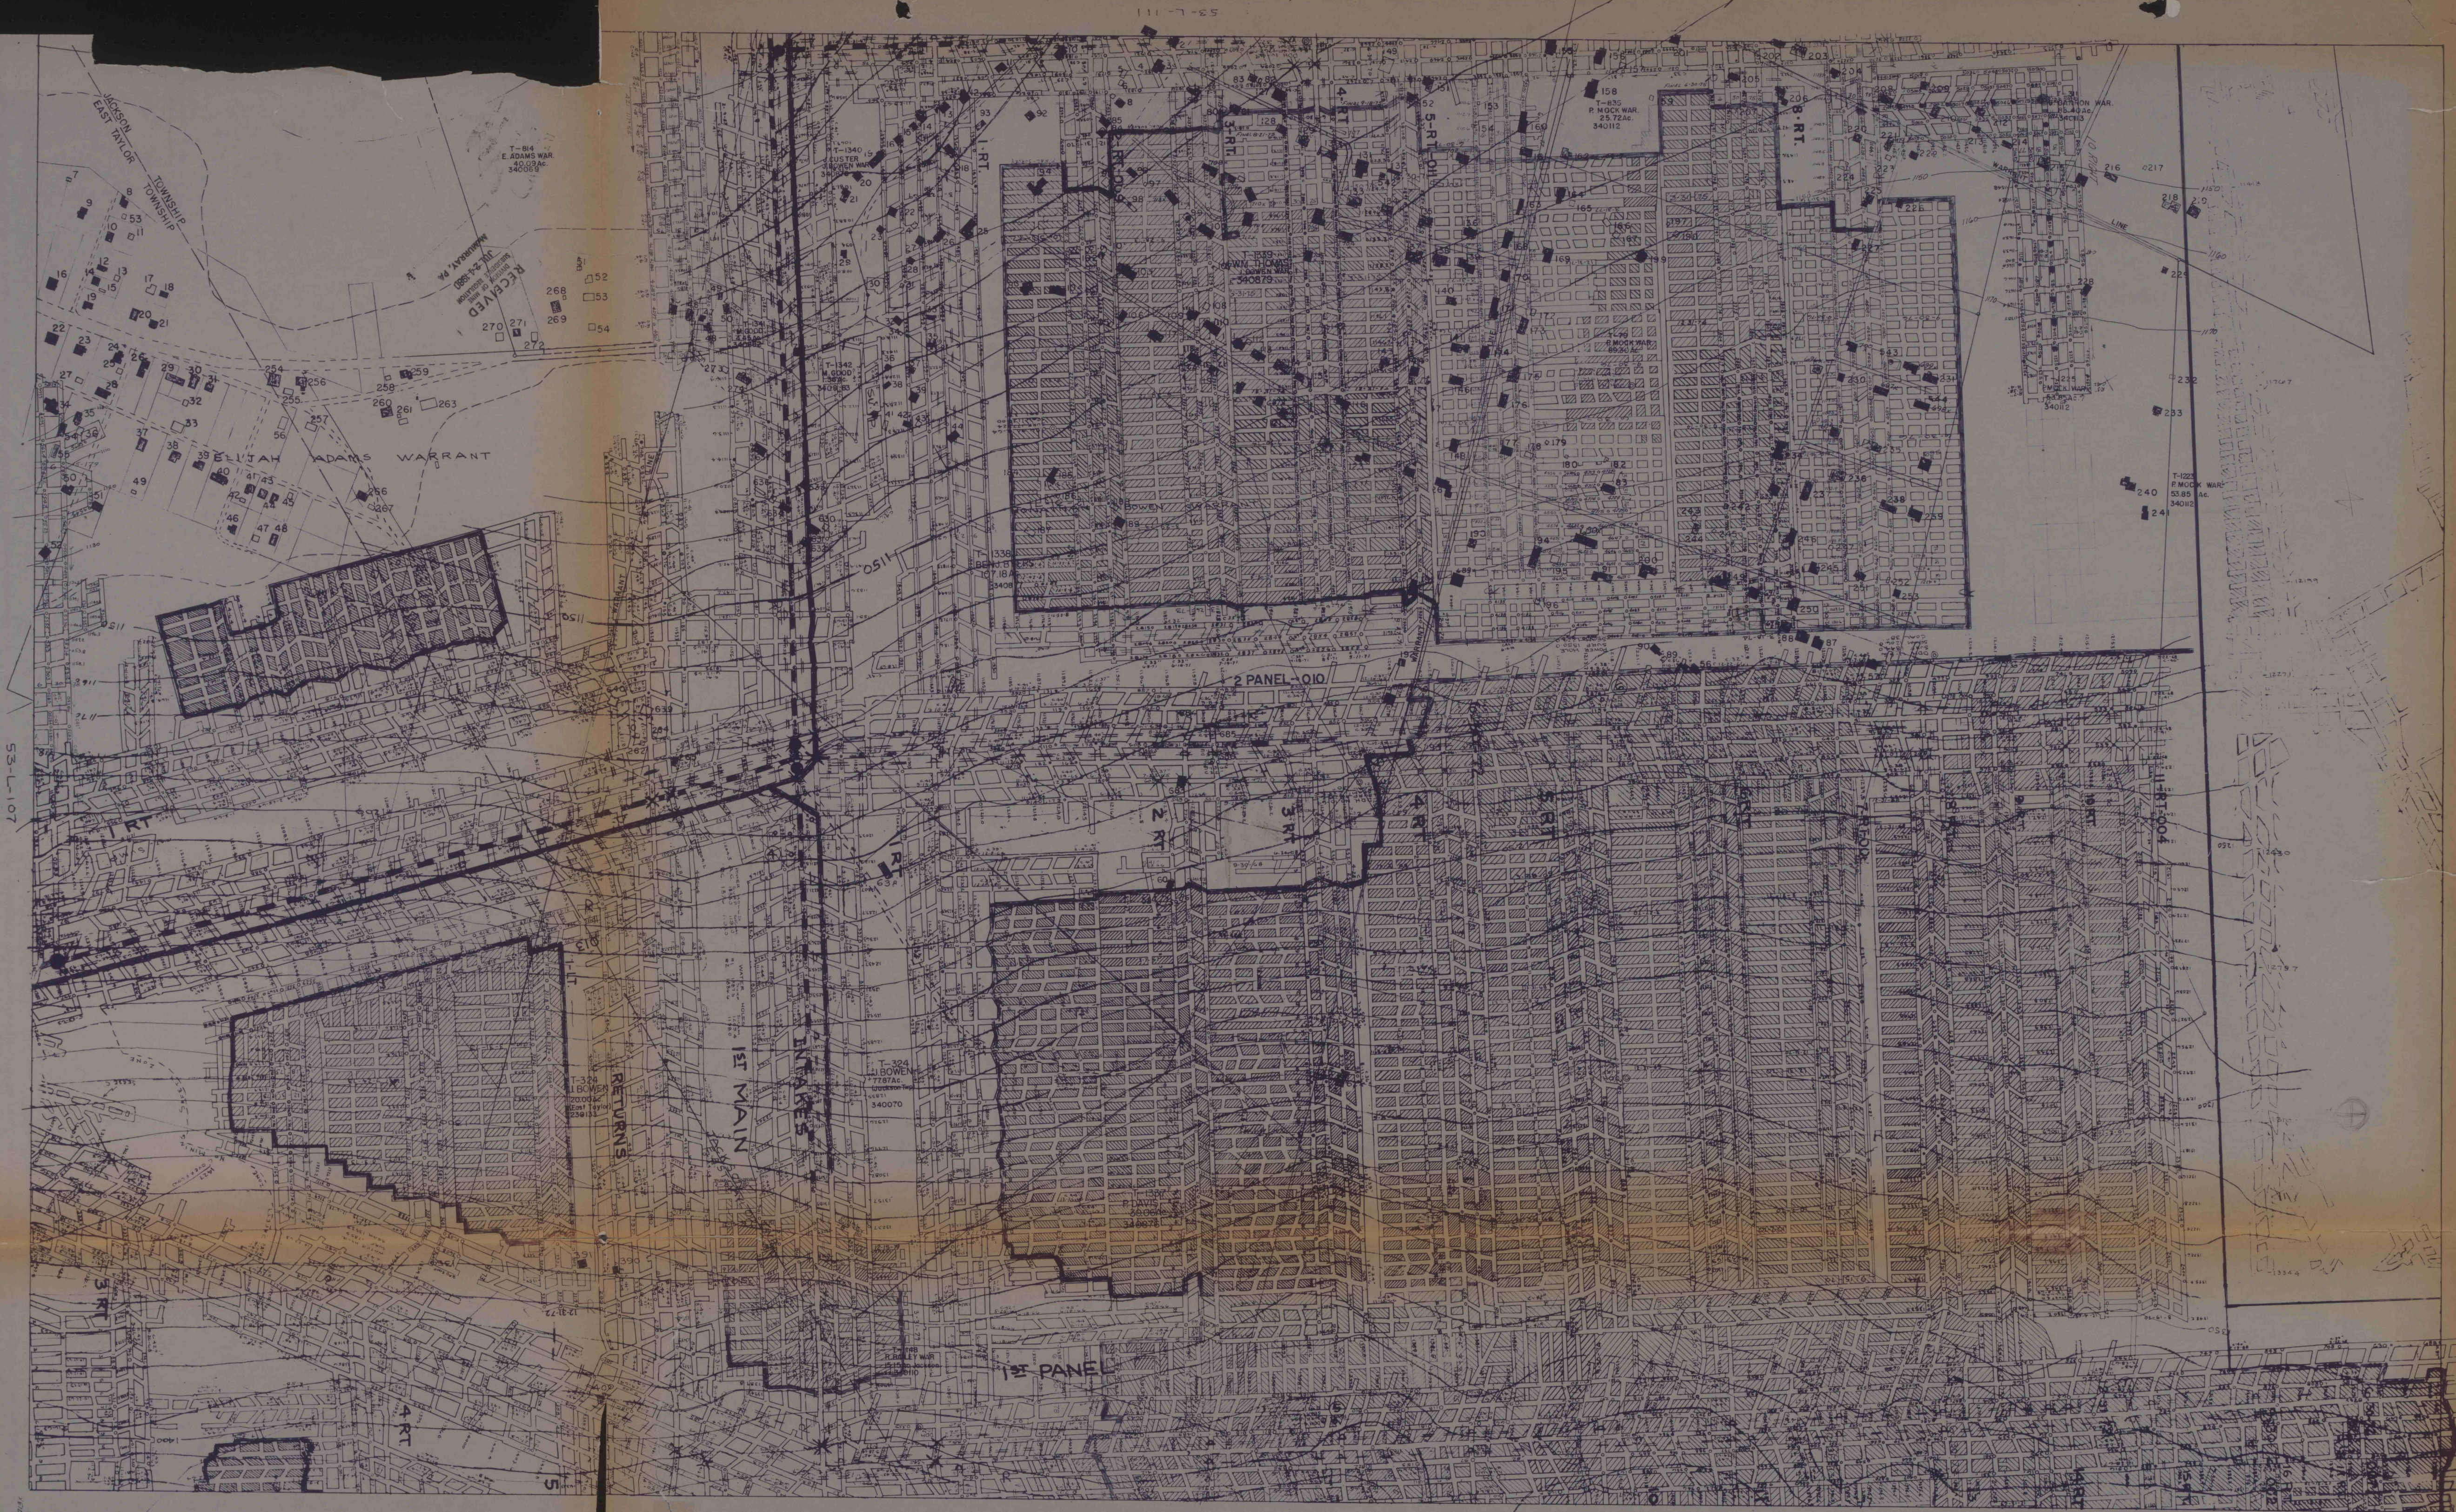

53-L-107

53-L-109A

* 53-L-110