




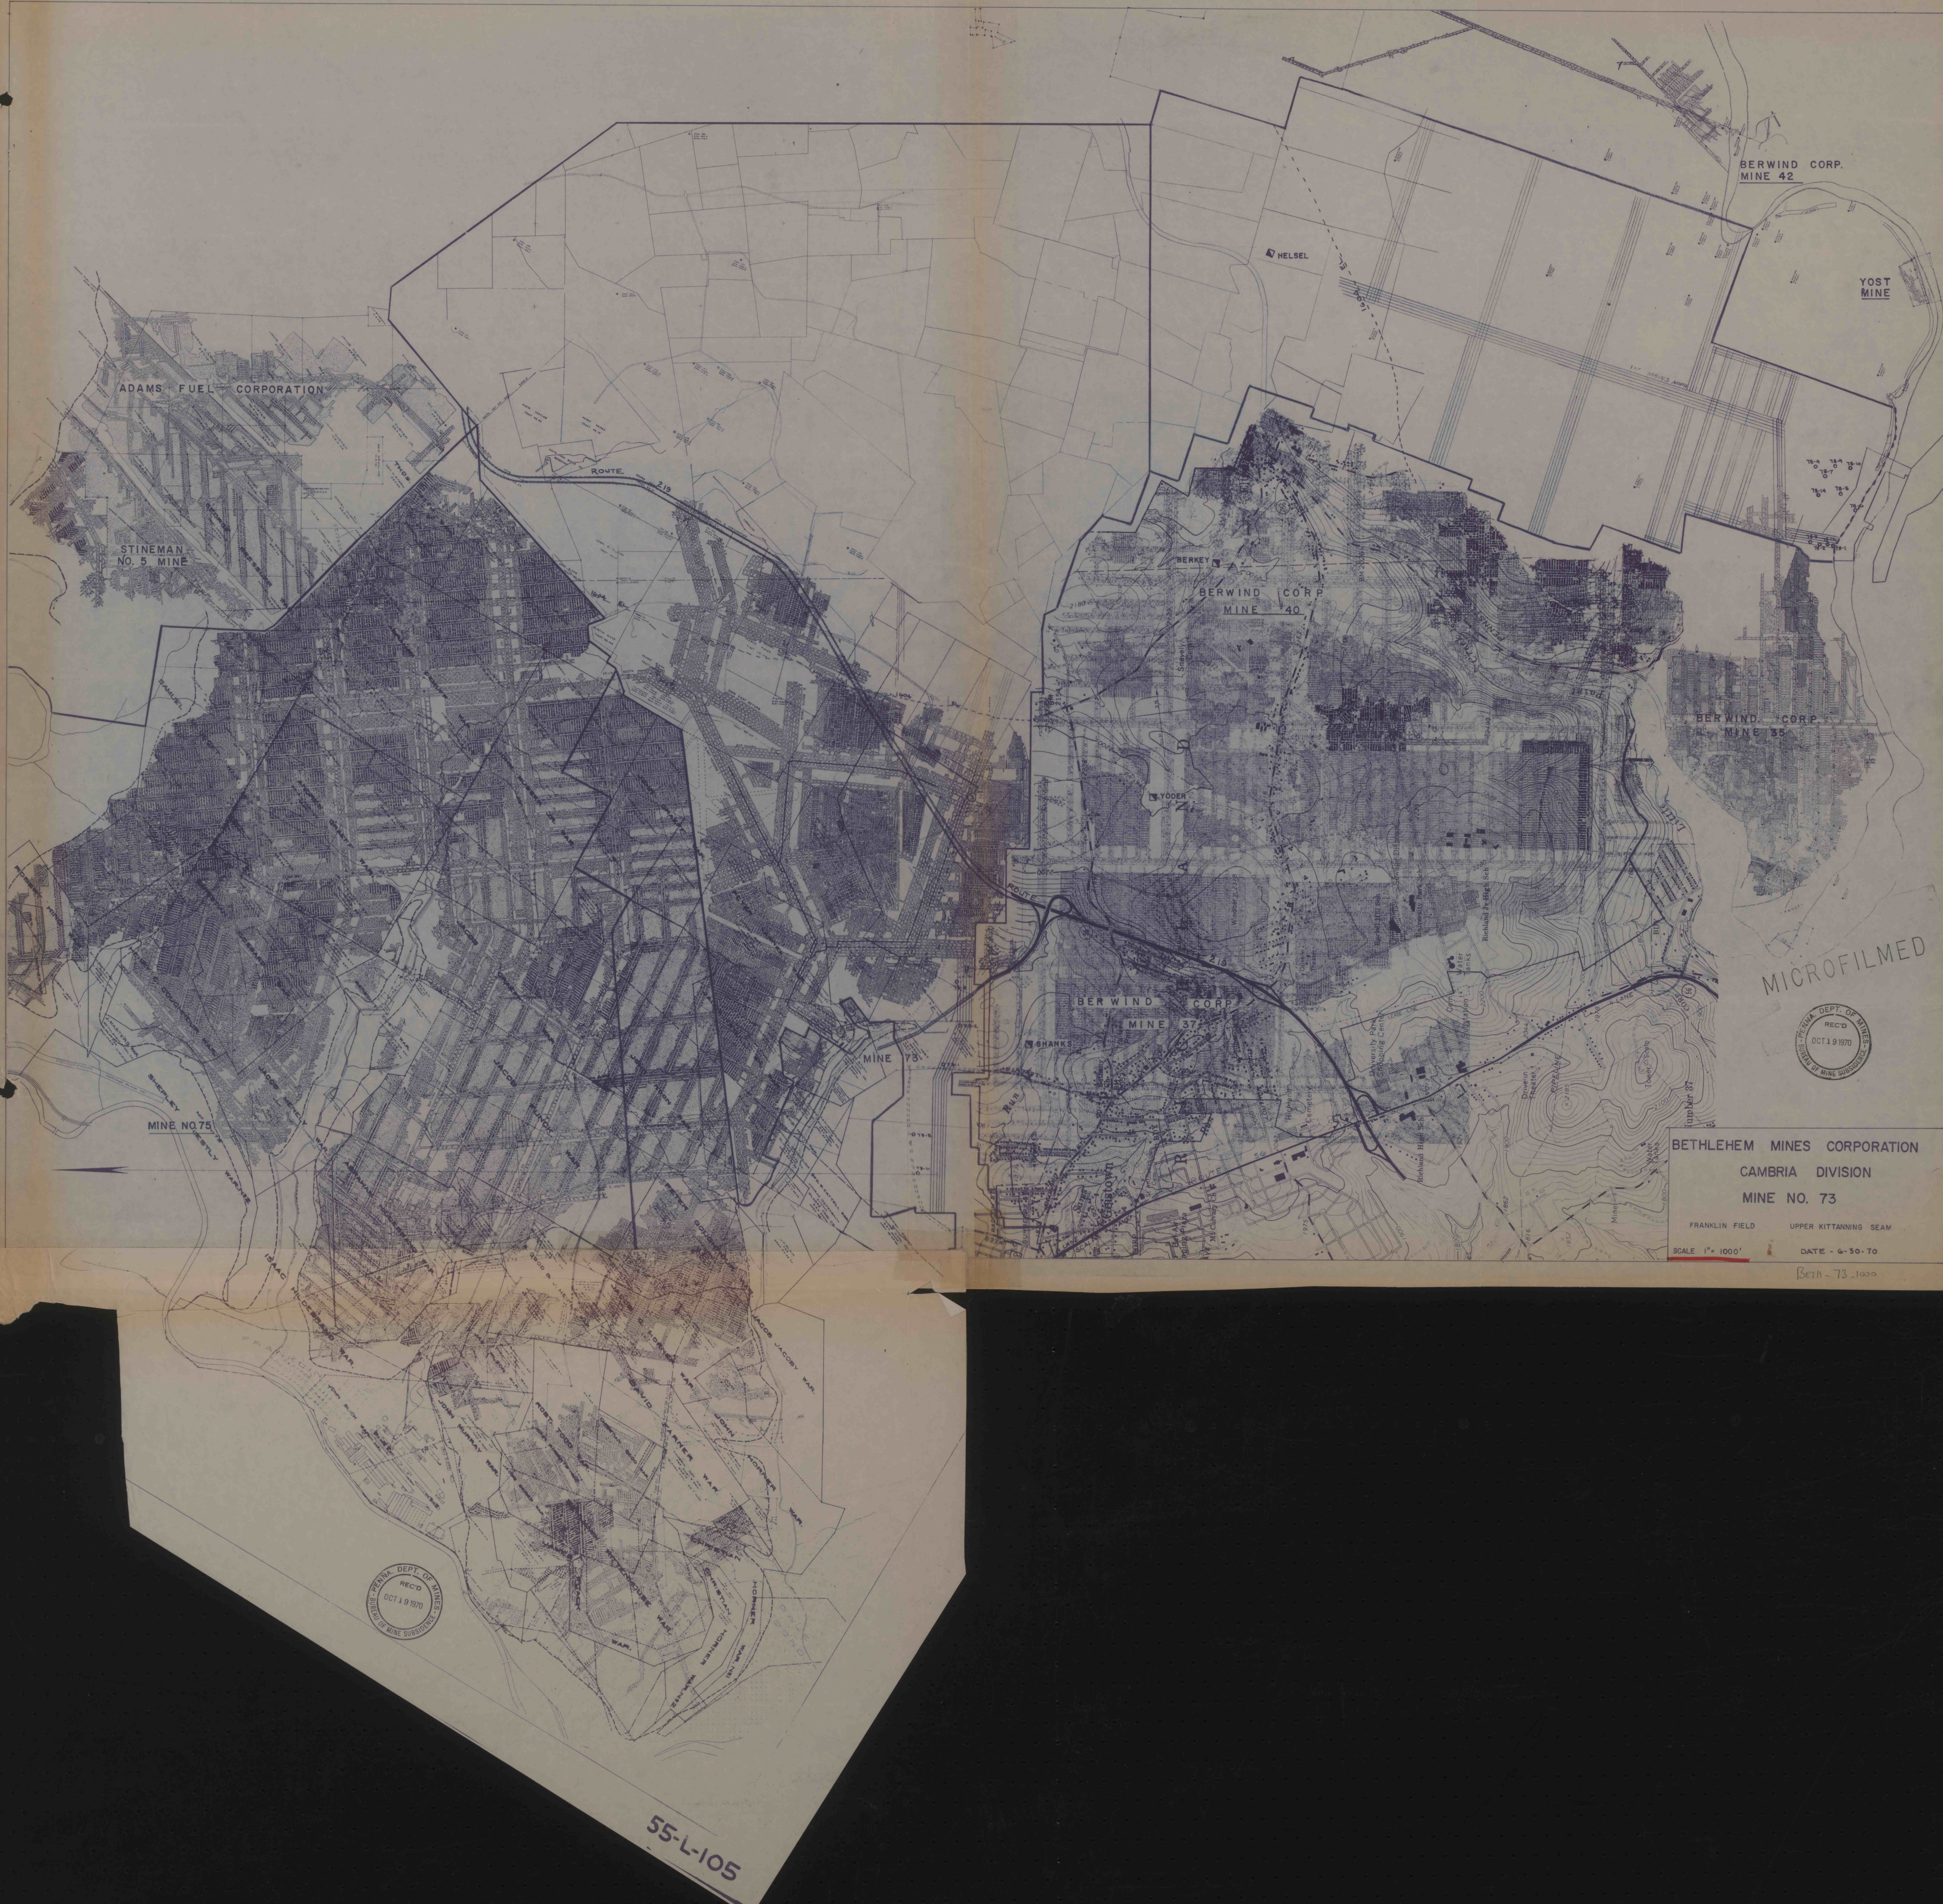

MICROFILMED

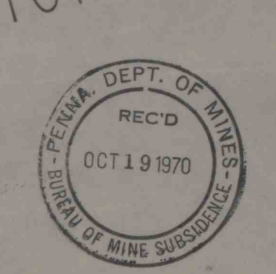

BETHLEHEM MINES CORPORATION
CAMBRIA DIVISION
MINE NO. 73
FRANKLIN FIELD UPPER KITTANNING SEAM
SCALE 1" = 1000'
DATE - 6-30-70
BETH - 73 - 1000

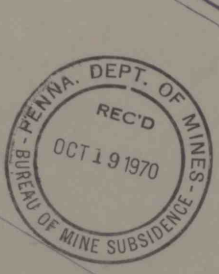

55-L-105