


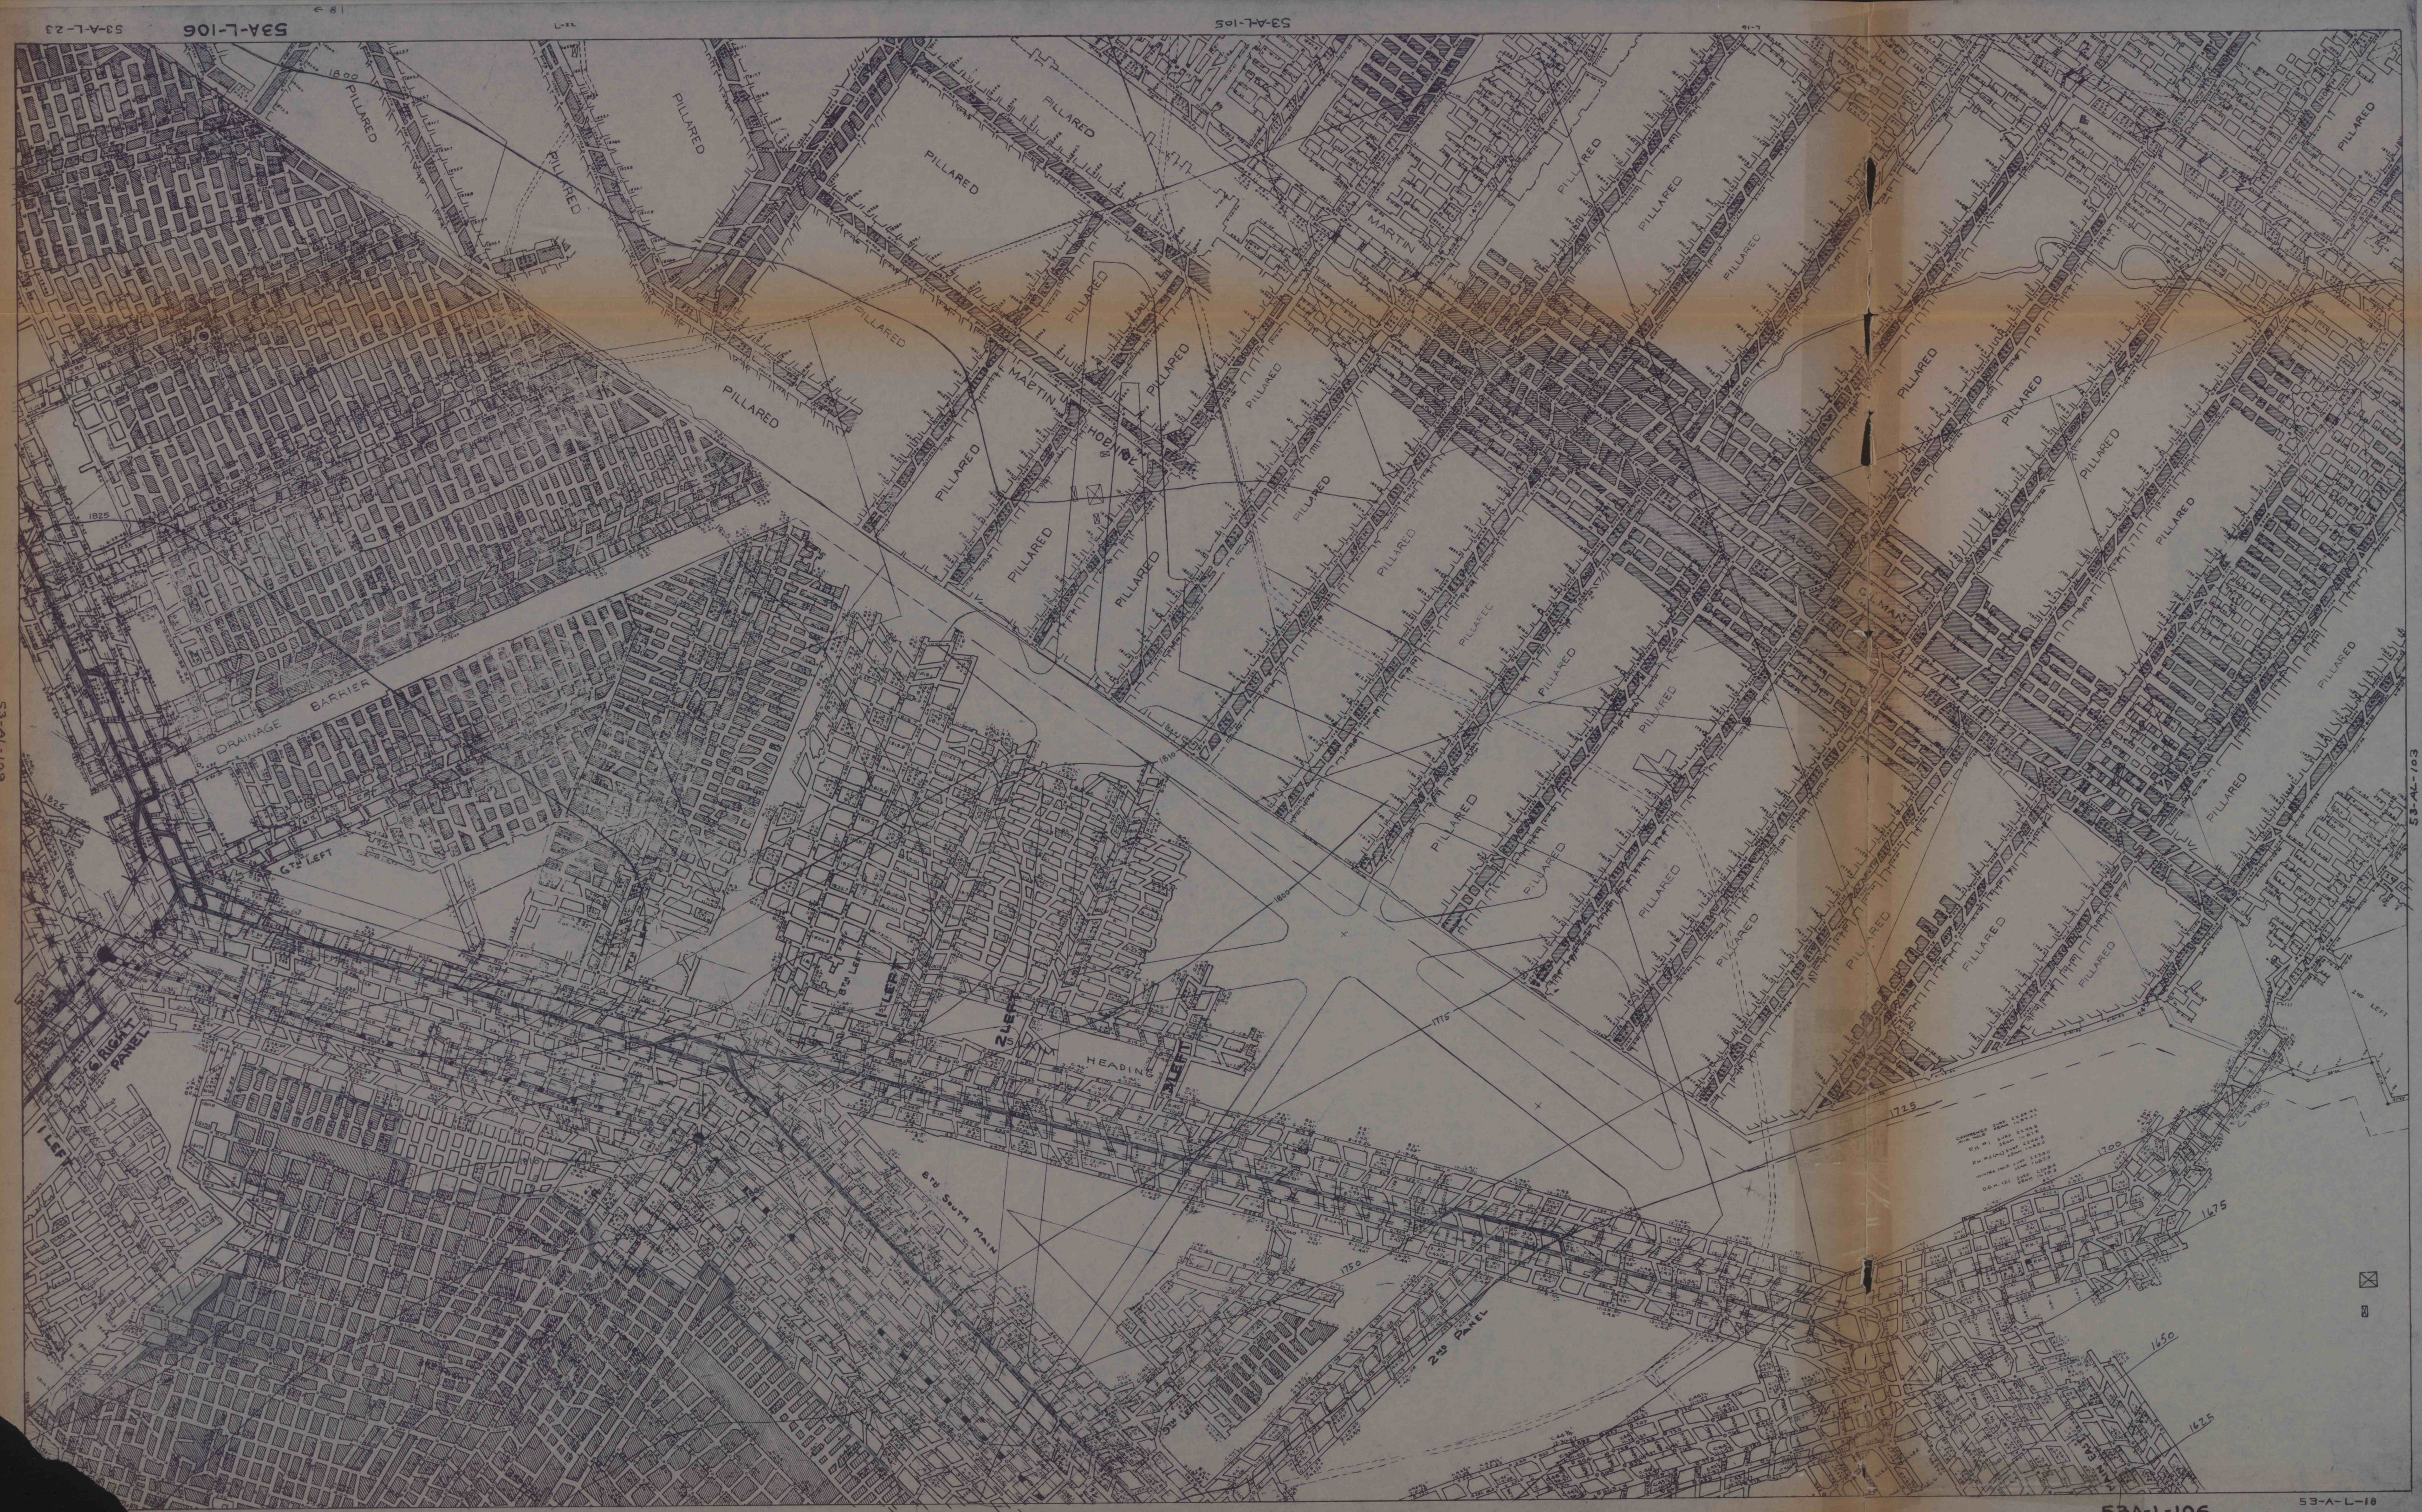

53A-L-106

53A-L-105

53A-L-103

53A-L-106

53A-L-10

53A-L-111

