


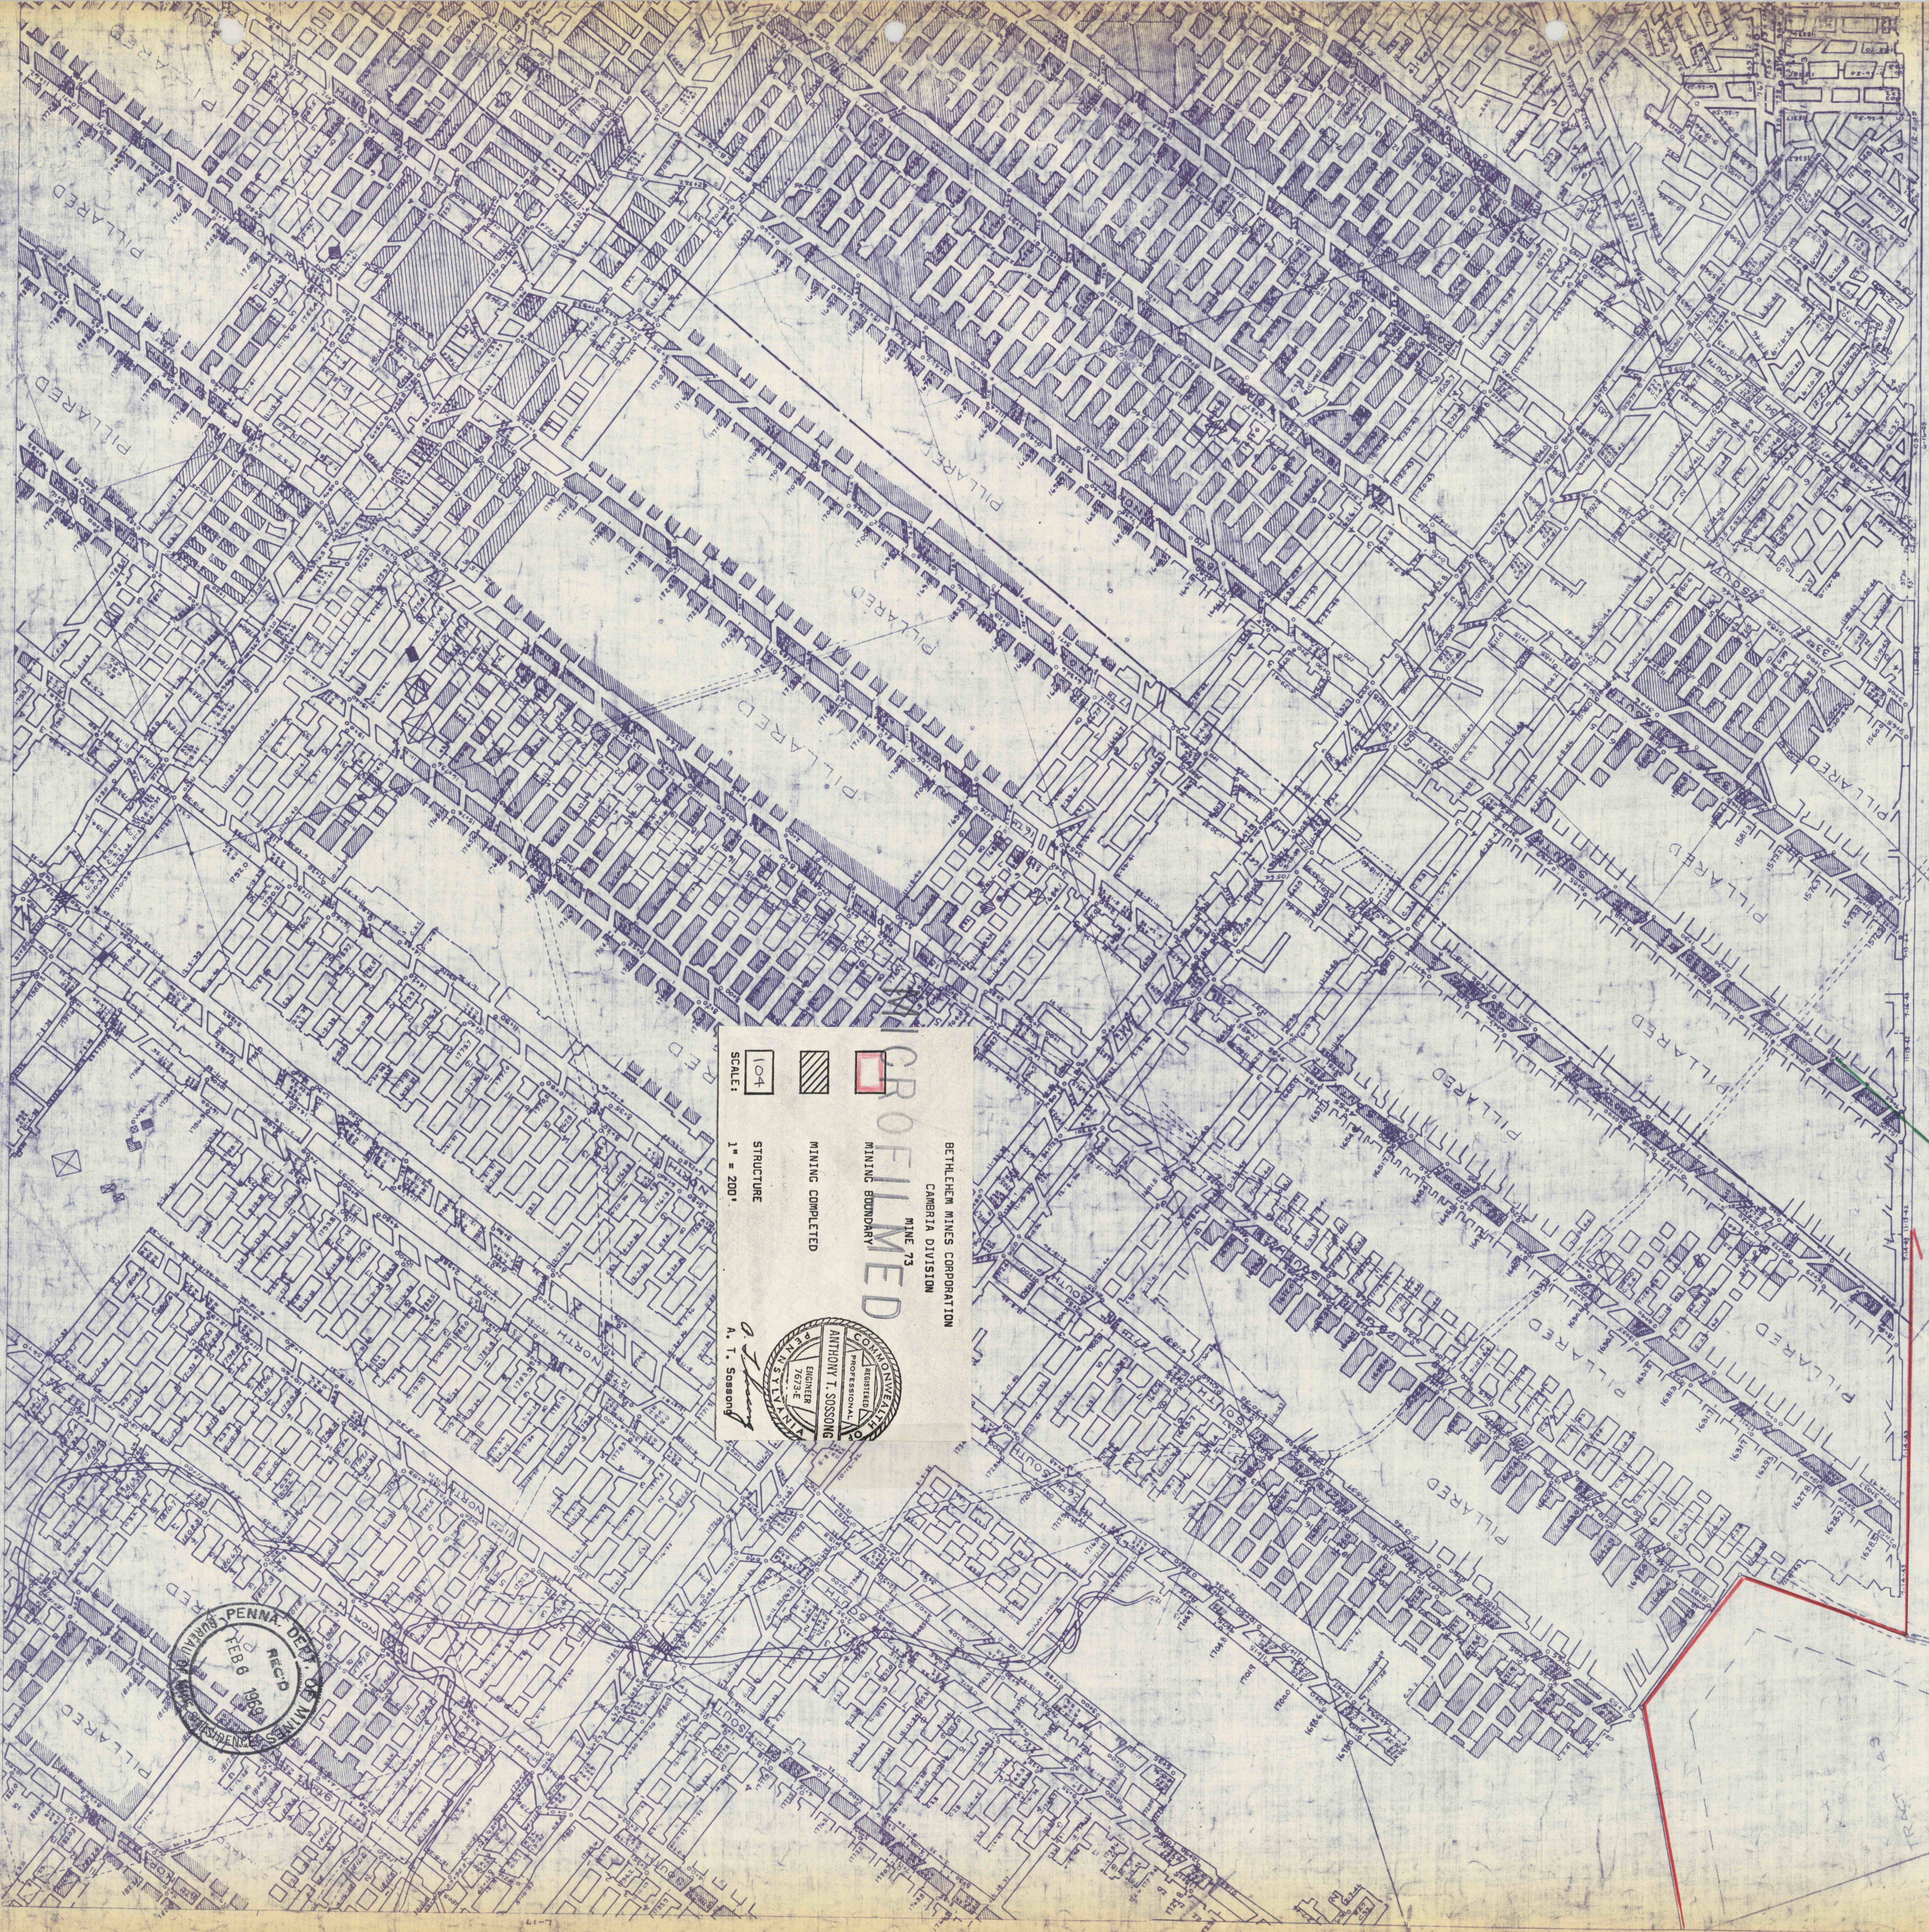

COPIED

BETHLEHEM MINES CORPORATION
CAMBRIA DIVISION
MINE 73

MINING BOUNDARY

MINING COMPLETED

STRUCTURE


SCALE: 1" = 200'

A. T. Sweeney

ANTHONY T. SWEENEY
Professional Engineer
No. 10732
PENNSYLVANIA



RICHLAND TWP.

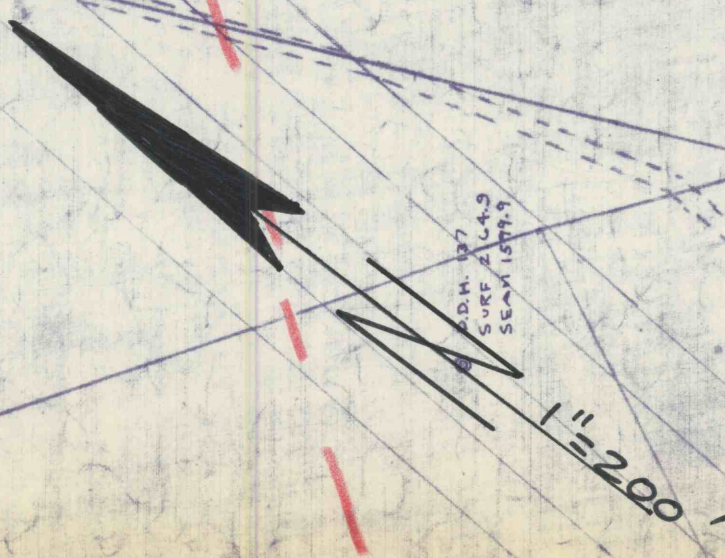

53-A-L-103S
Feb. 69