


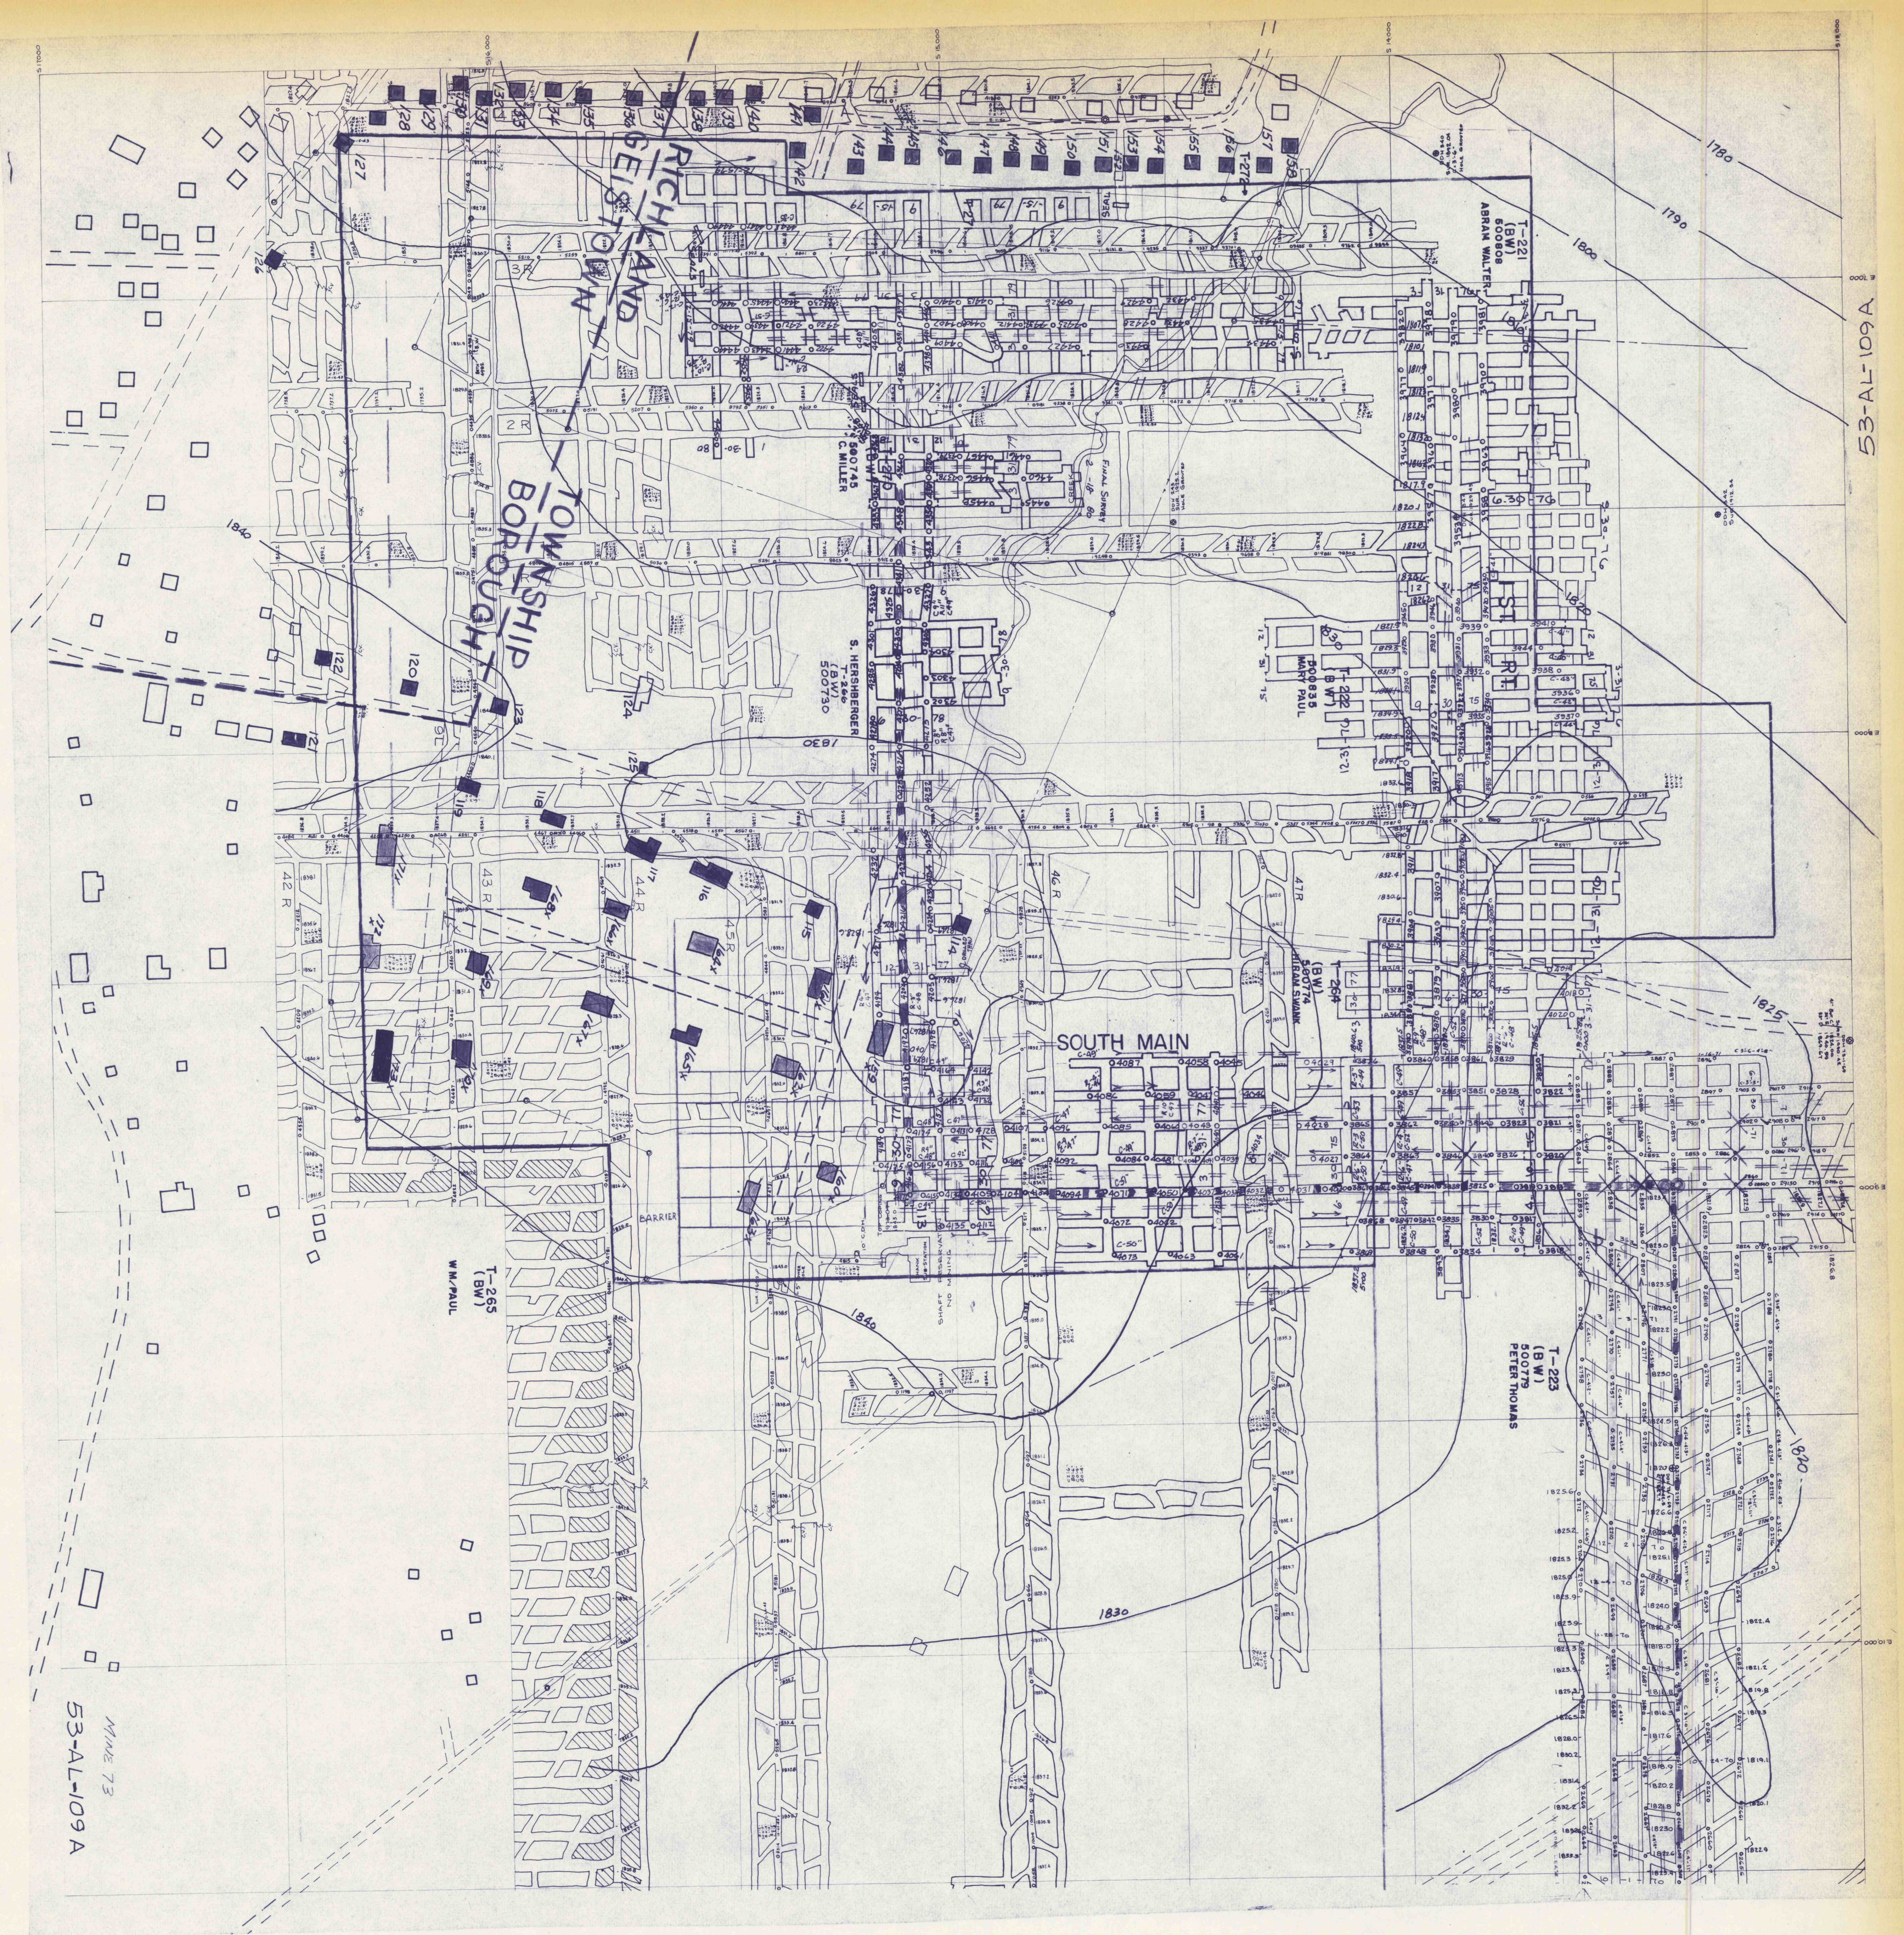

MINE 73
53-AL-109 A

53-AL-109 A

RECEIVED
DIVISION OF MINE
SUBSIDIANCE REGULATION
APR 28 1980
McMURRAY, PA

BETHLEHEM MINES CORPORATION

MINE NO. 73

PERMIT NO. 95-6A-2

RICHLAND TWP. CAMBRIA COUNTY
SCALE: 1"=200' SURVEY DATE: 2-18-80

LEGEND

- CONTEMPLATED MINING
- PROTECTED STRUCTURE 125
- HOUSE BUILT AFTER 1966 710X
- 50% MINING AREA
- MINING COMPLETED AREA
- PILLARED AREA
- C' SEAM



John C. Oswald
JOHN C. OSWALD
R.P.E. 18005-E

FINAL

SHEET NO. 53-AL-109A