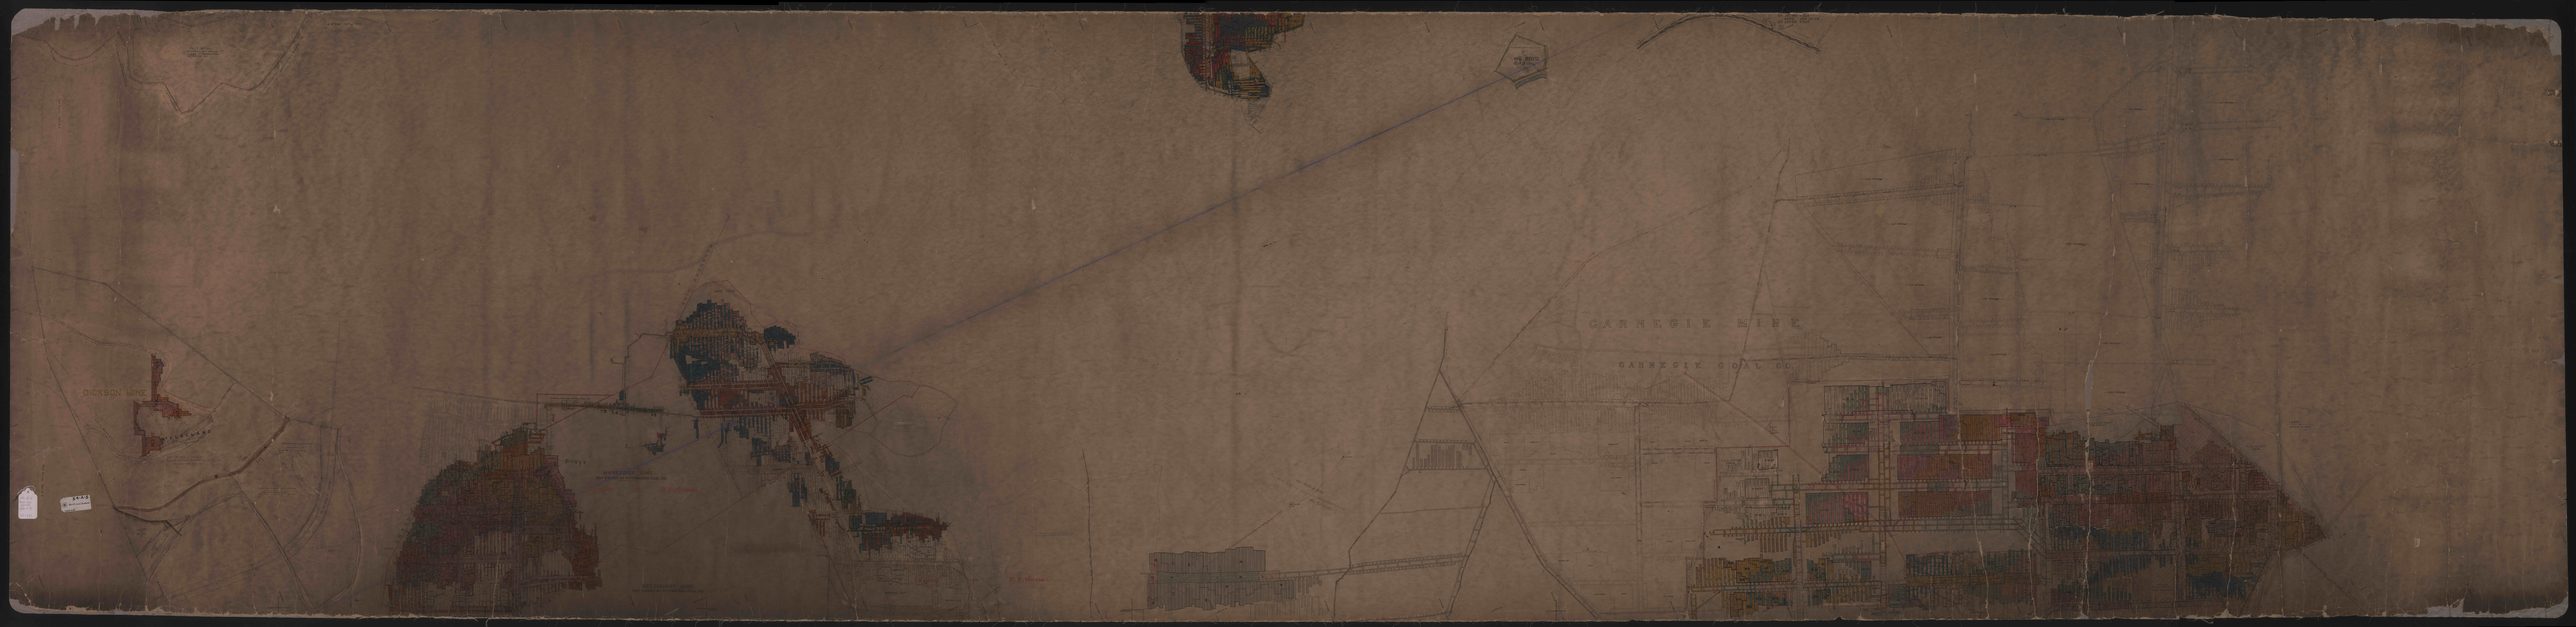

DICKSON MINE
CARNEGIE MINE
CARNEGIE COAL CO.