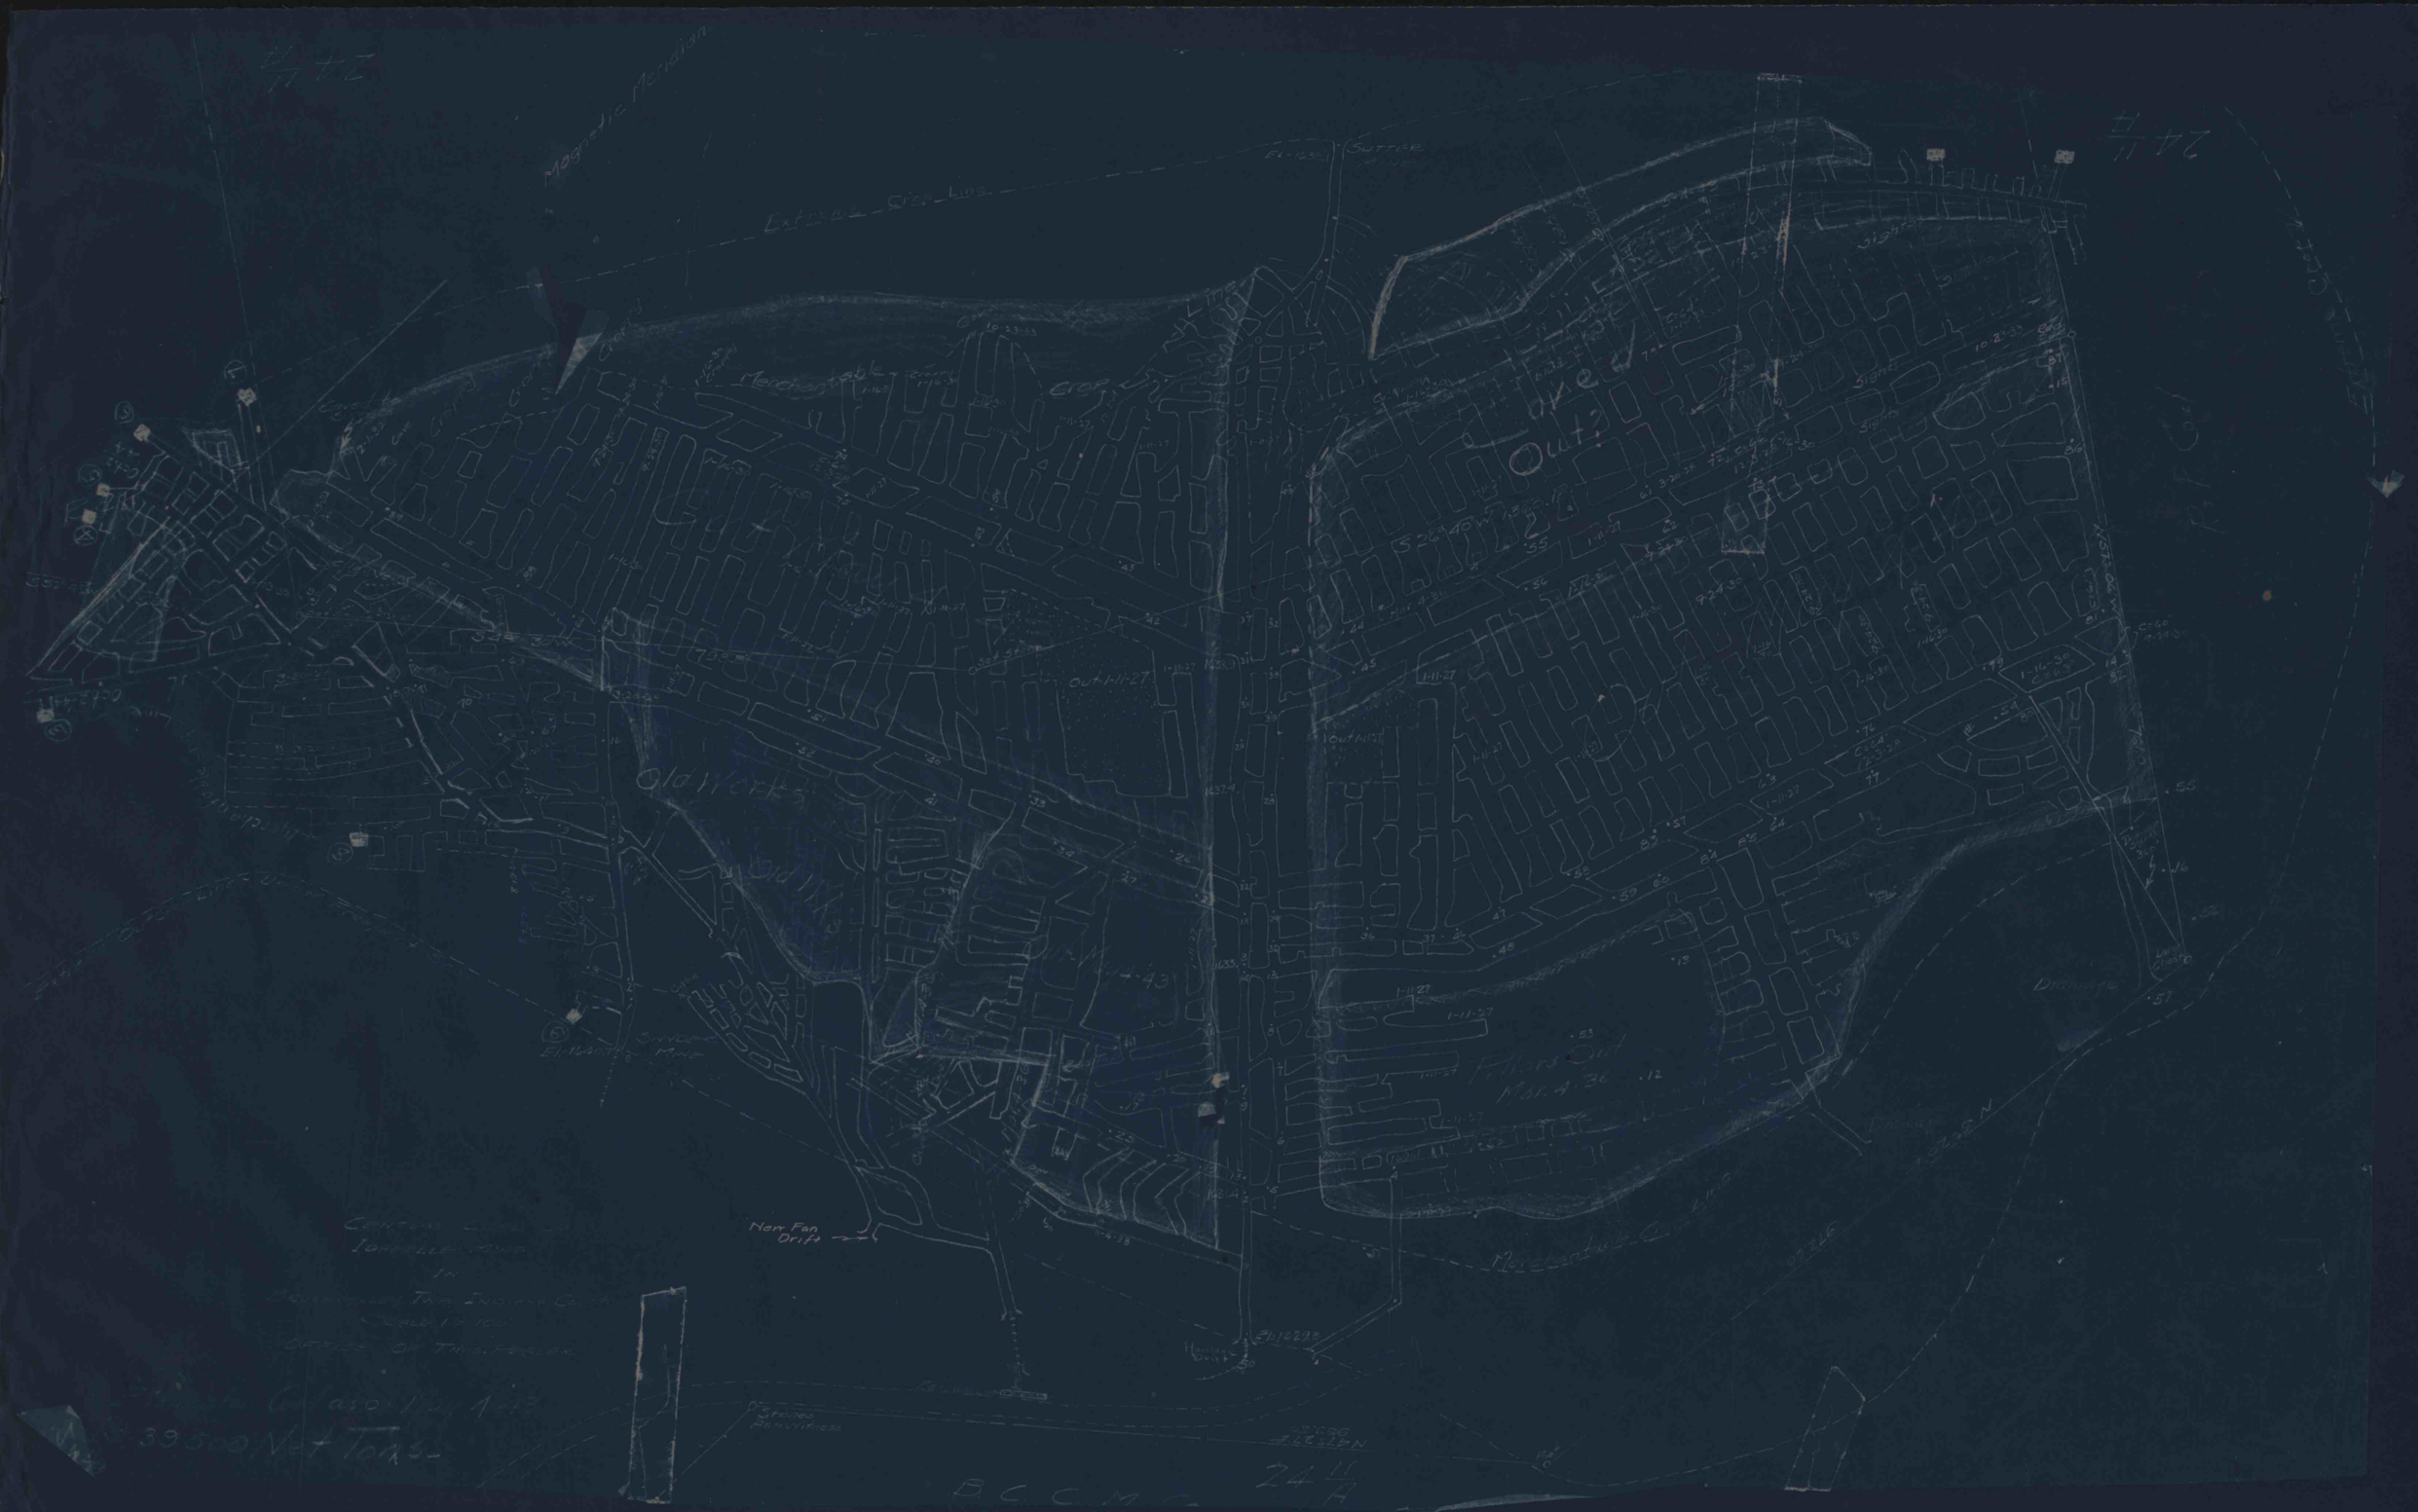
Magnetic Meridian
Merchantable
Old Works
Non Fan Drift
39500 Net Tons
244 A

IMAPS # 19672