


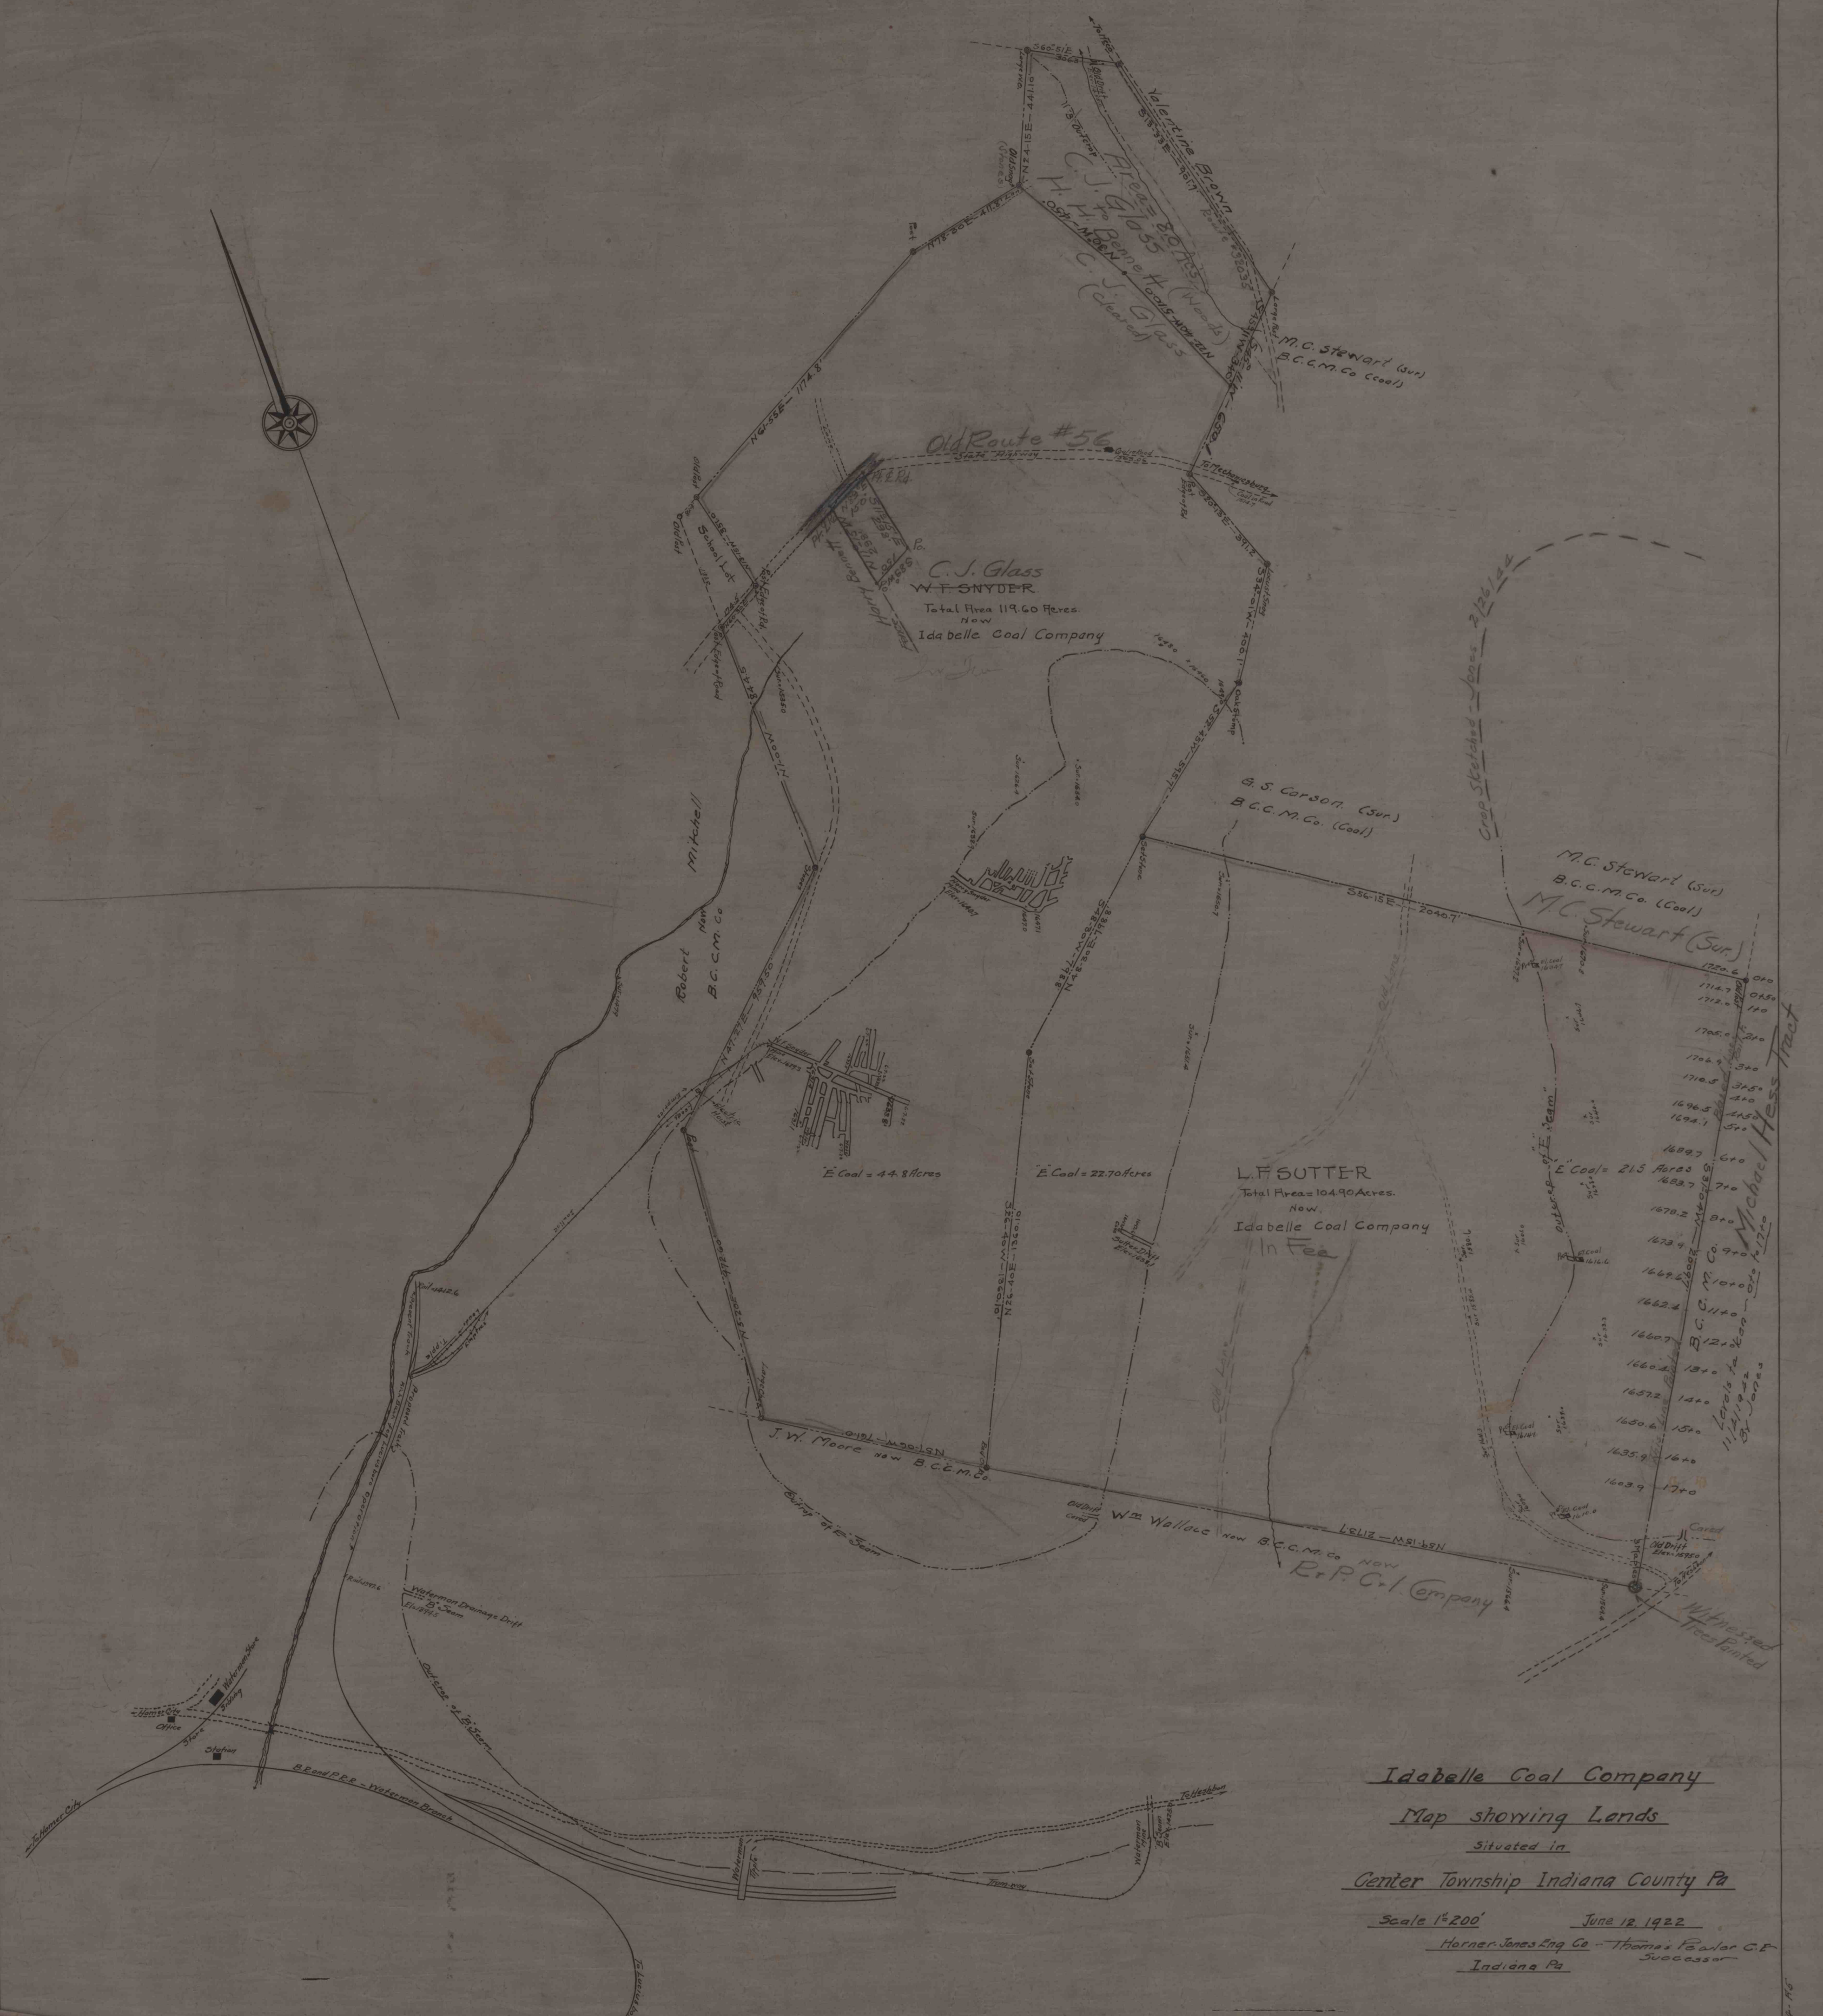

Idabelle Coal Company
Map showing Lands
Situated in
Center Township Indiana County Pa

Scale 1"=200' June 12, 1922
Horner Jones Eng Co - Thomas F. Taylor G.E.
Indiana Pa Successor