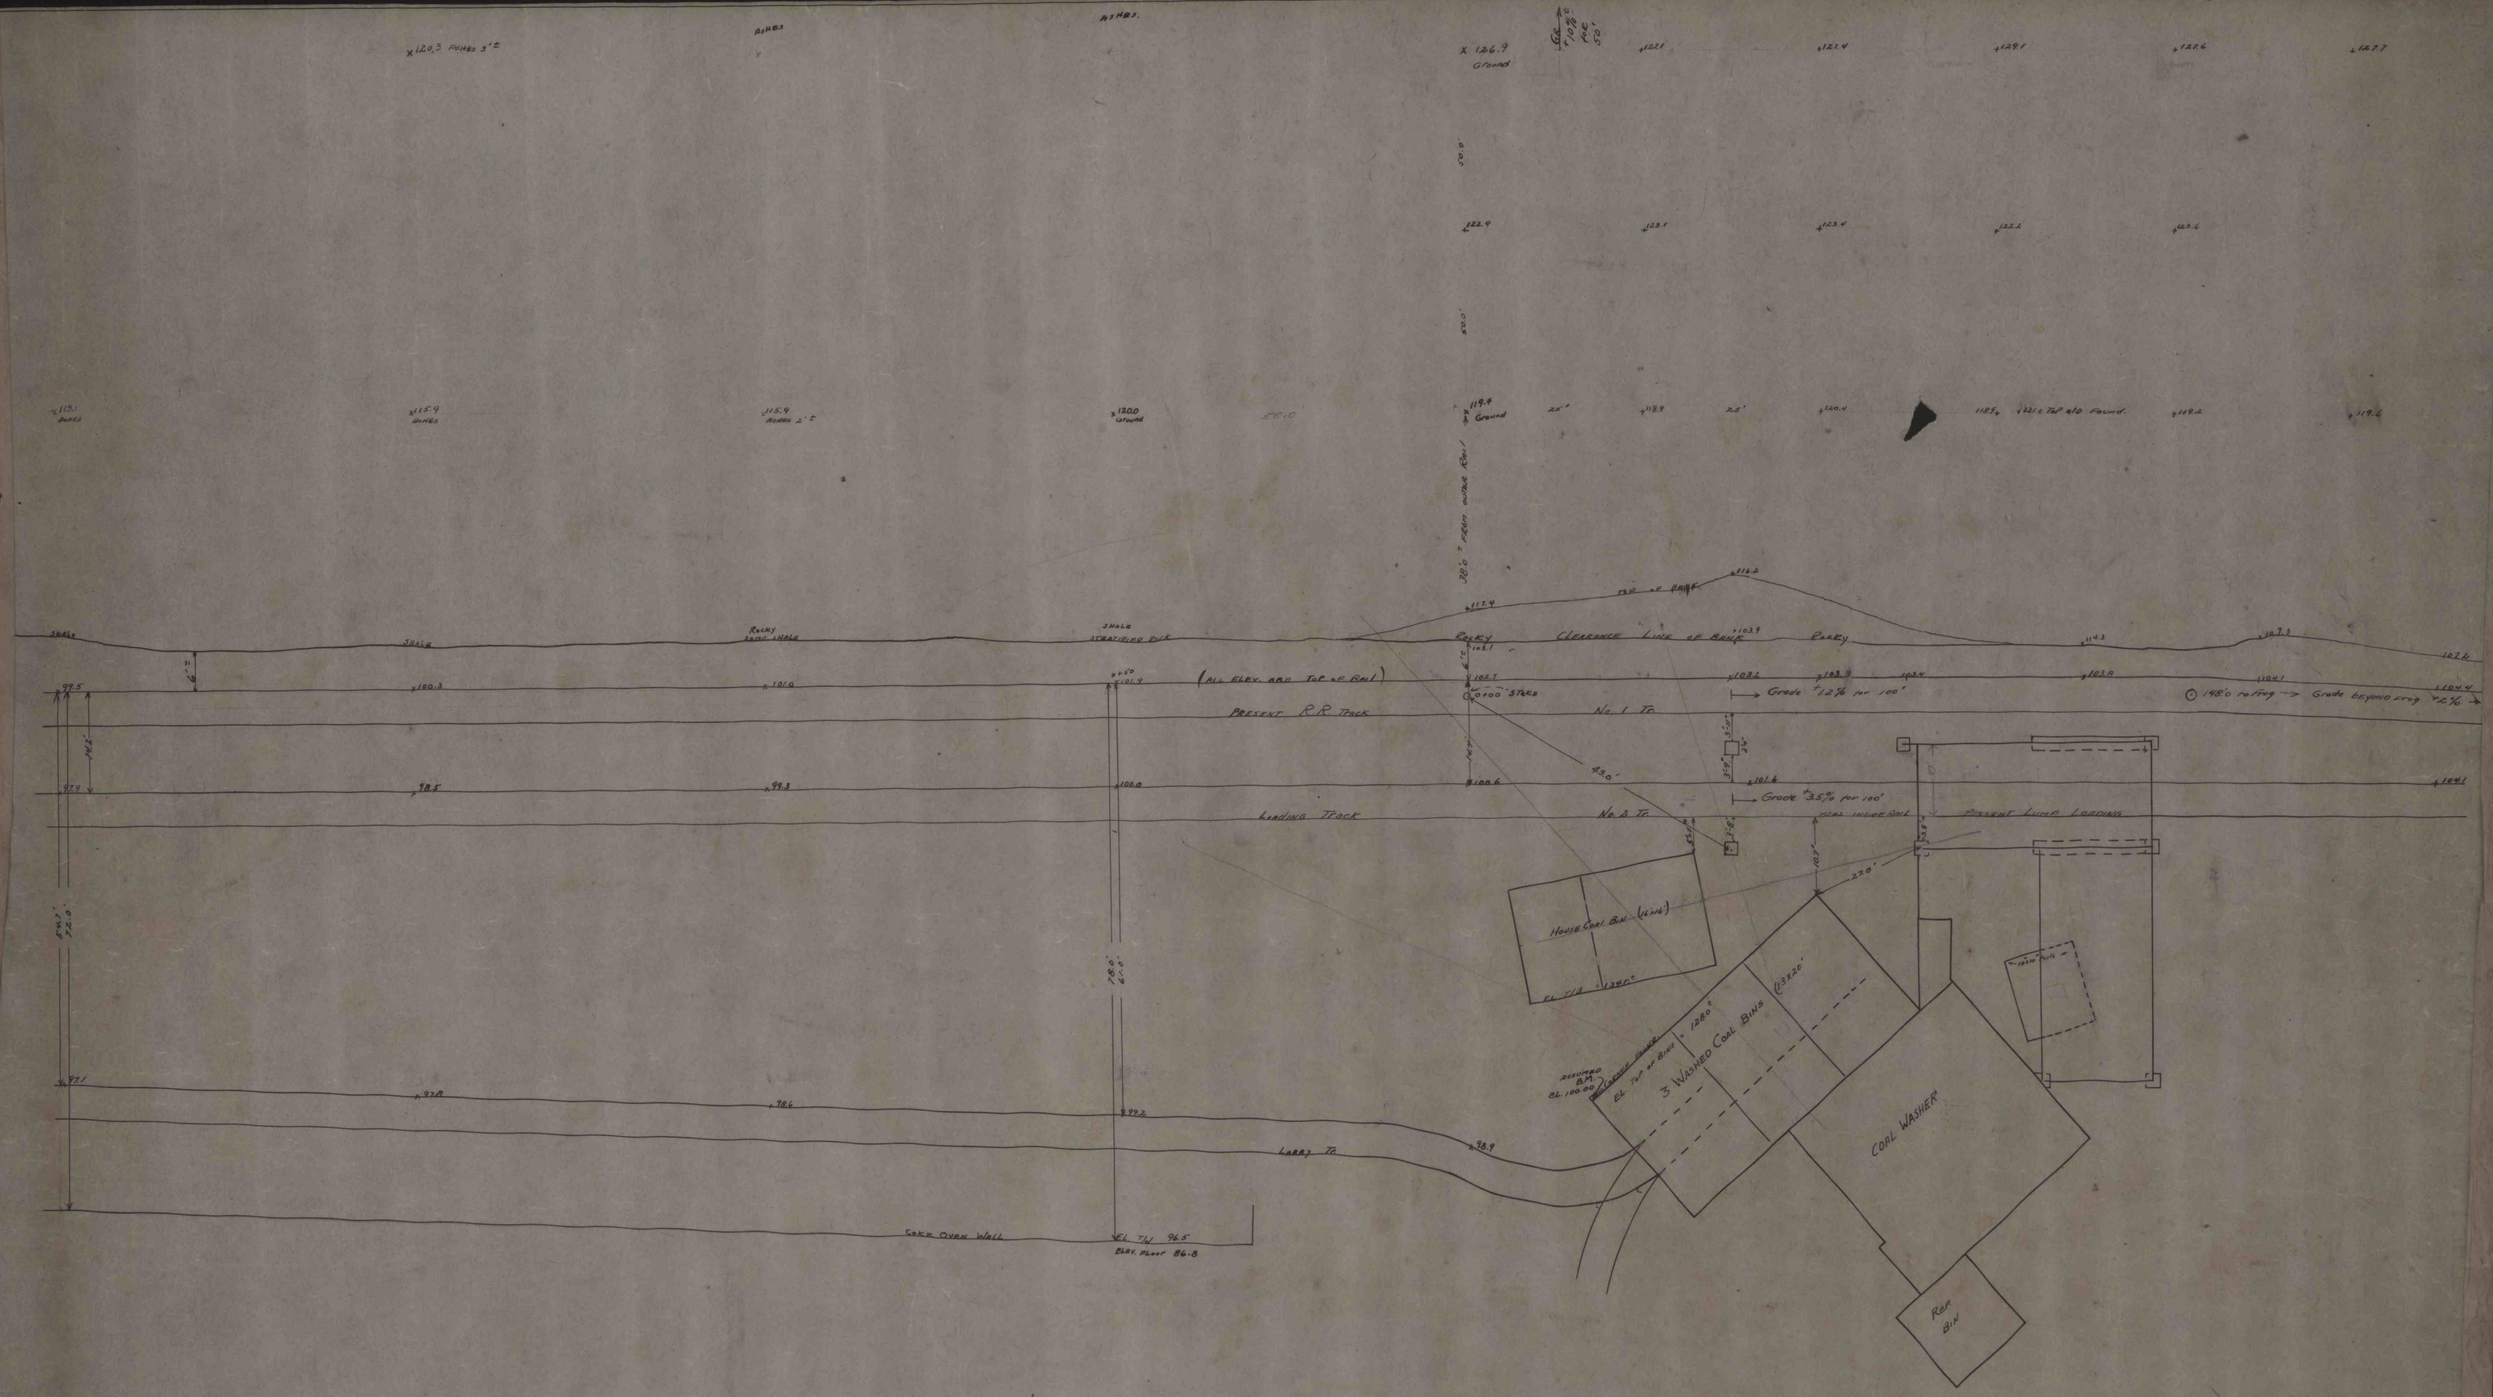

SCALE 1" = 10'

COAL WASHING PLANT & TRACK

AT

ATLANTIC No. 2

NEW DERRY PA. JULY 29, 1949

IMAPS # 19696