


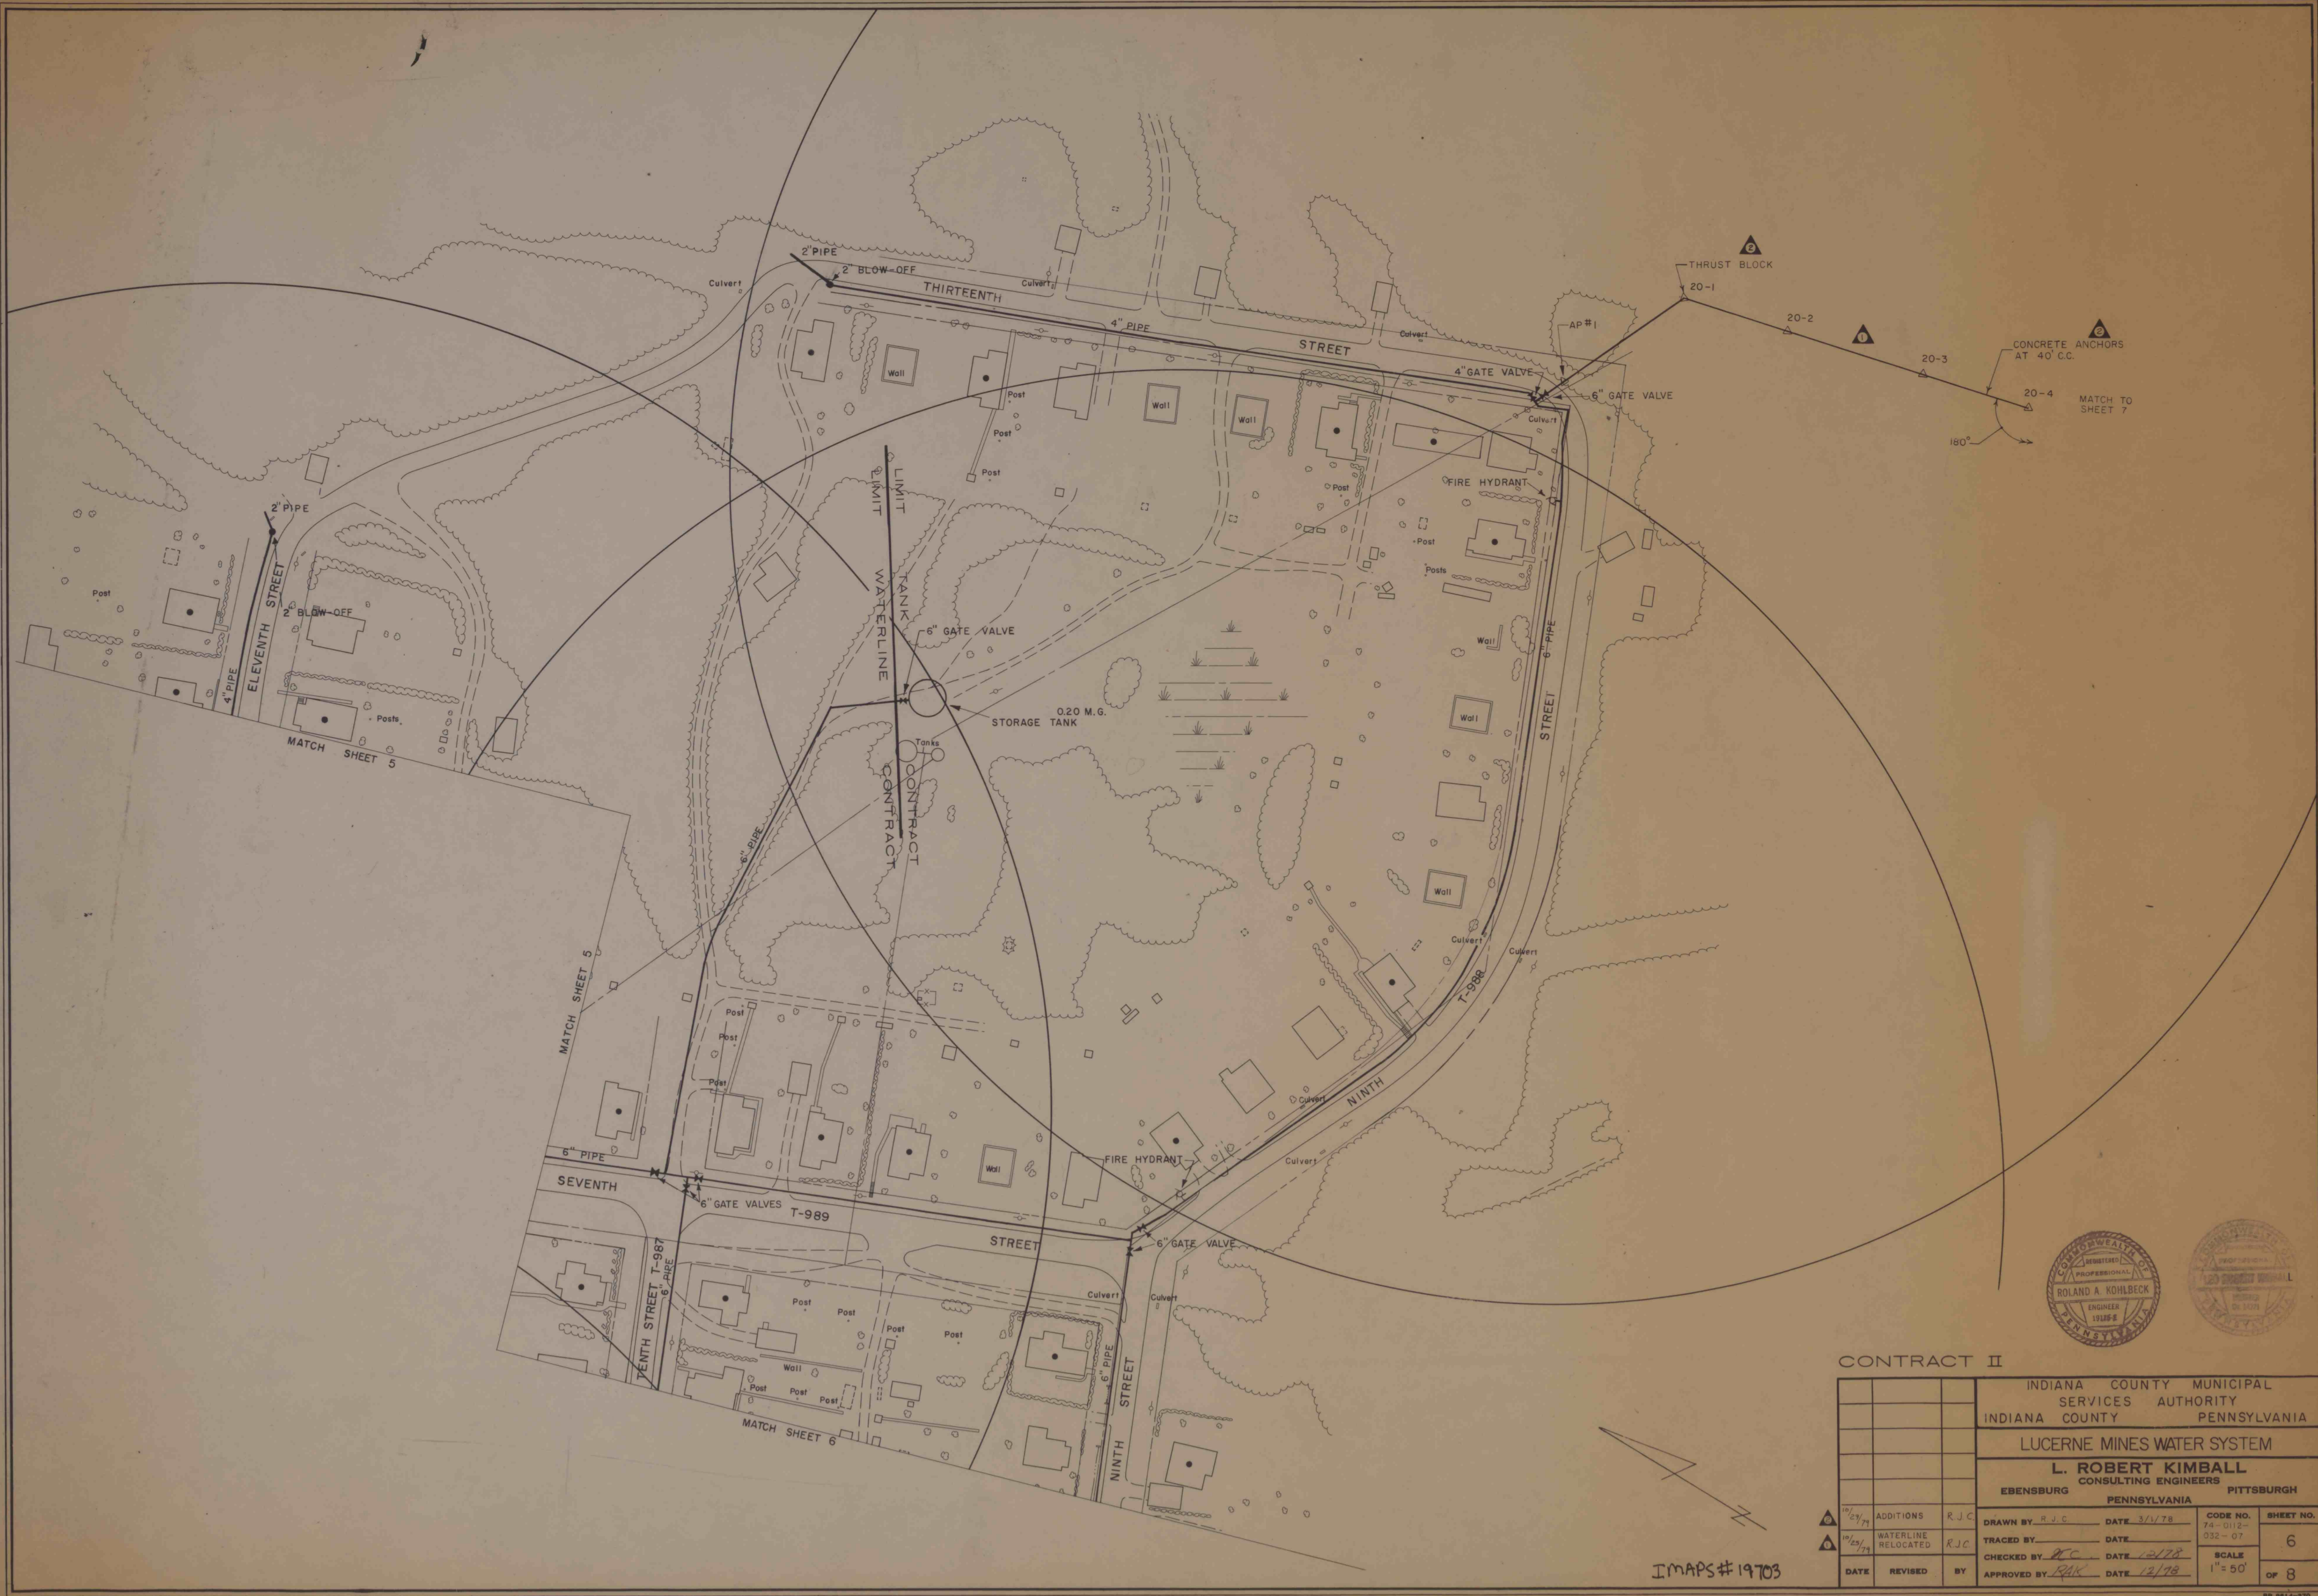

CONTRACT II

		INDIANA COUNTY MUNICIPAL SERVICES AUTHORITY	
		INDIANA COUNTY PENNSYLVANIA	
		LUCERNE MINES WATER SYSTEM	
		L. ROBERT KIMBALL	
		CONSULTING ENGINEERS	
		EBENSBURG	PITTSBURGH
		PENNSYLVANIA	
DATE	REVISED	BY	APPROVED
12/1/78		RJC	DATE 3/1/78
12/1/78		RJC	DATE 12/1/78
12/1/78		RAK	DATE 12/1/78
		CODE NO.	SHEET NO.
		74-0112-032-07	6
		SCALE	OF 8
		1" = 50'	

IMAPS# 19703