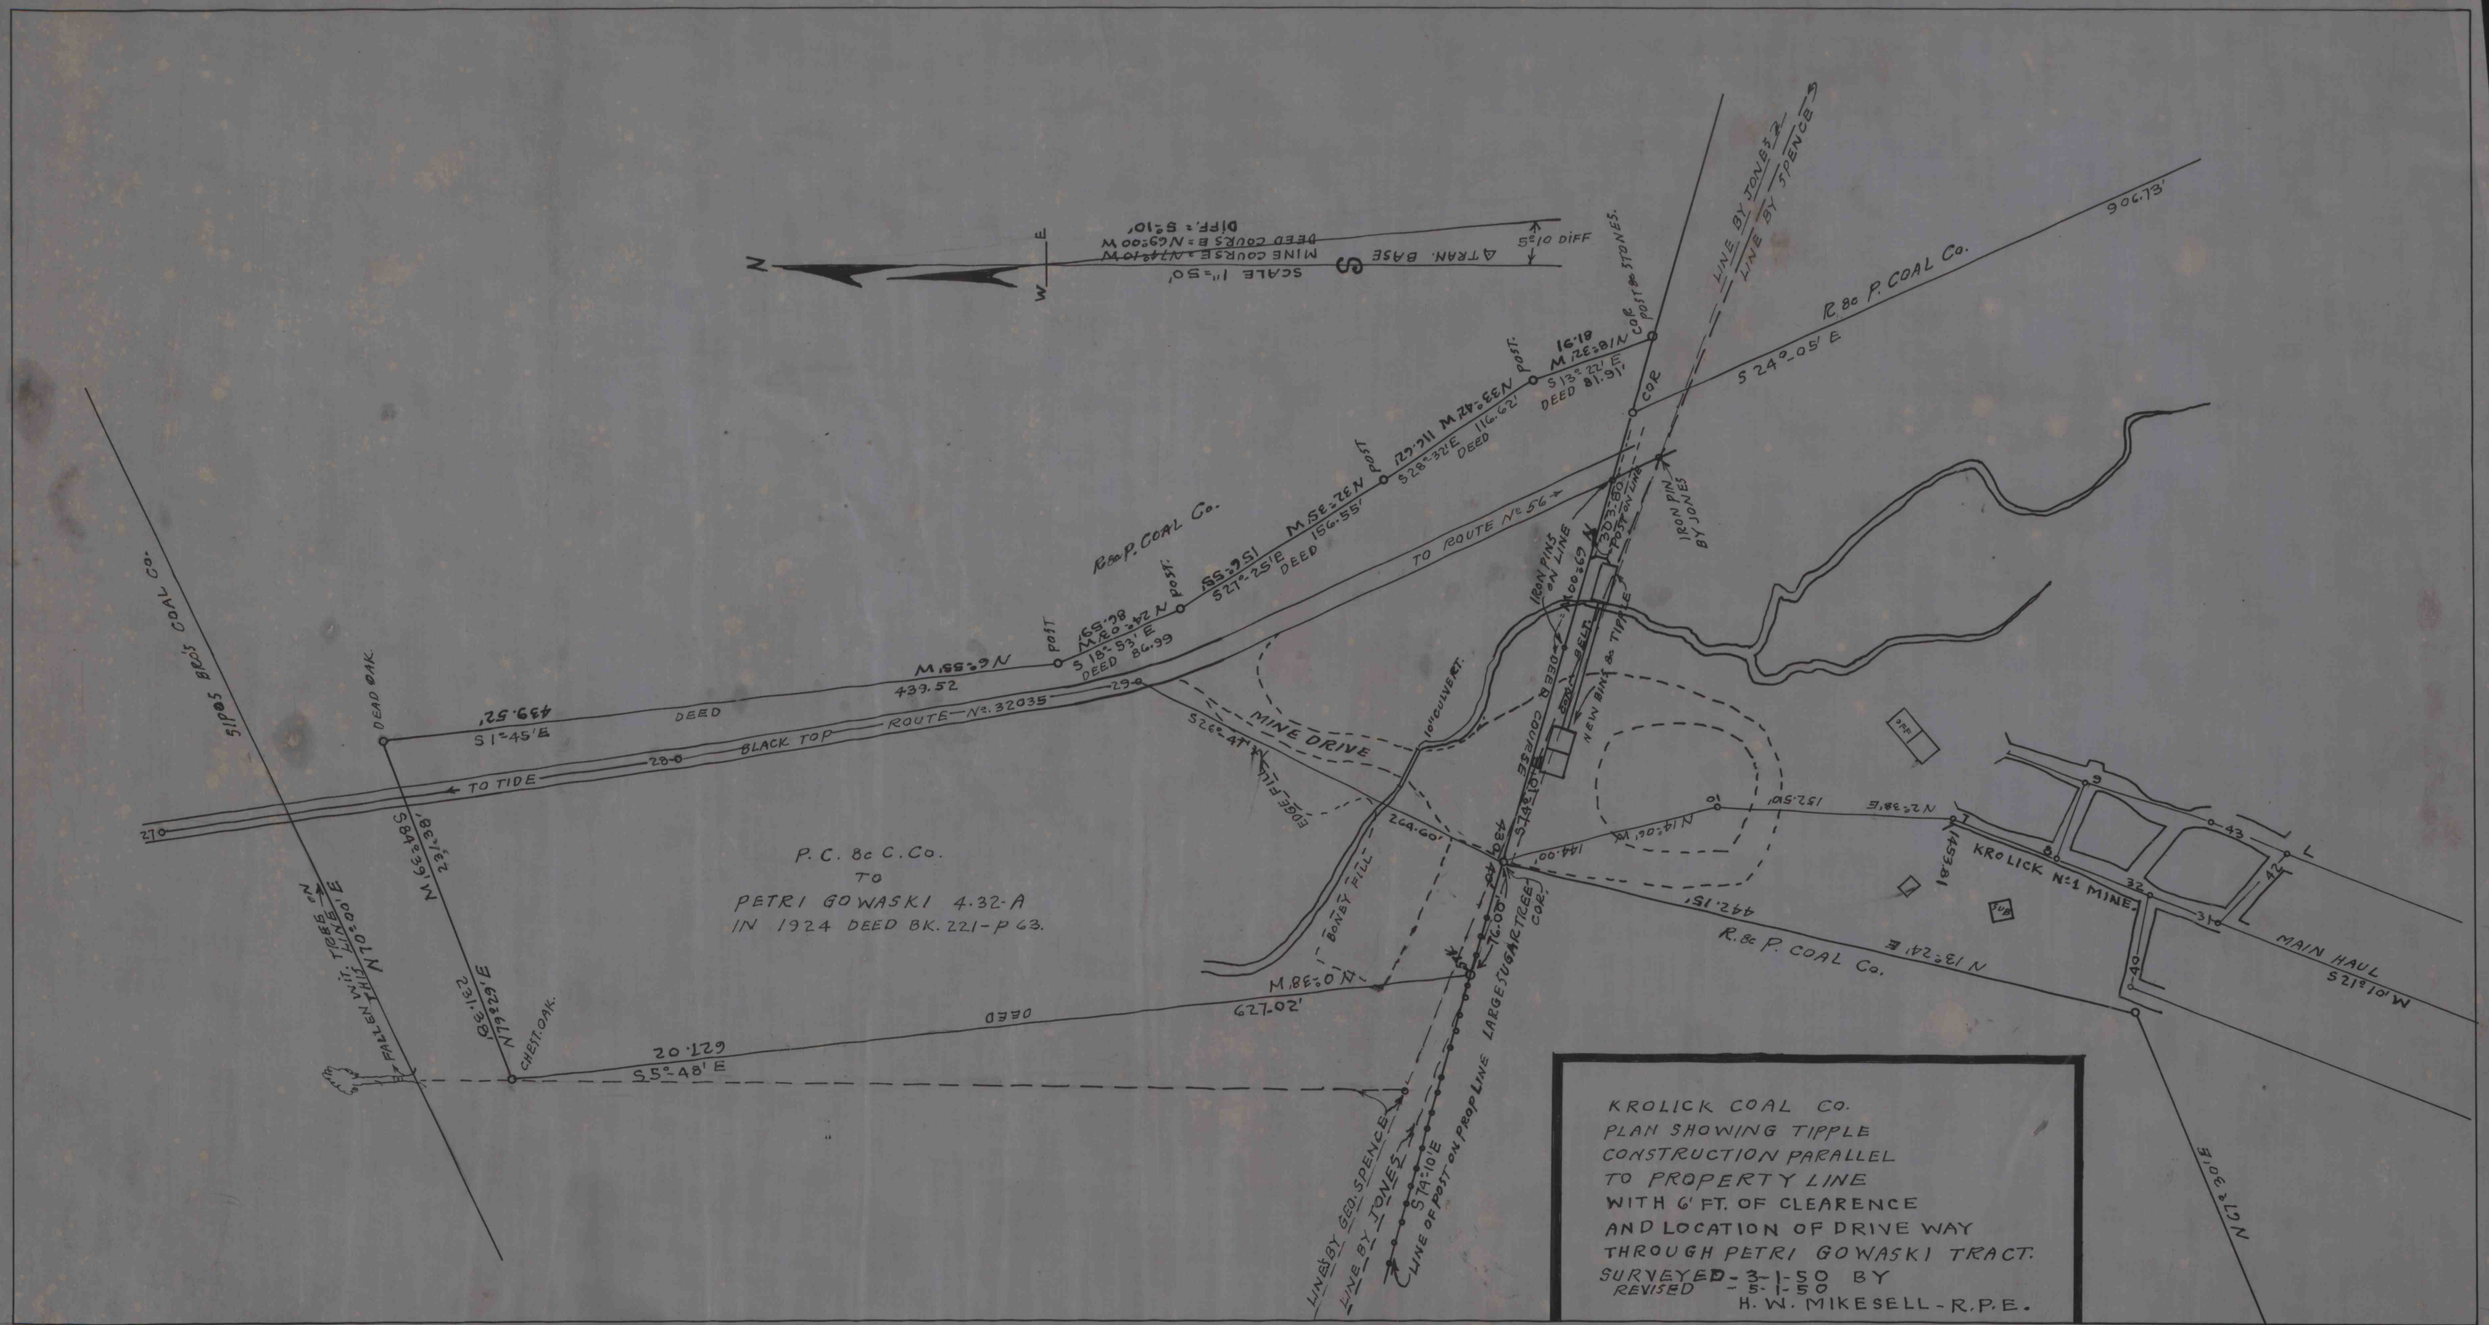
KROLICK COAL CO.
PLAN SHOWING TIPPLE
CONSTRUCTION PARALLEL
TO PROPERTY LINE
WITH 6' FT. OF CLEARENCE
AND LOCATION OF DRIVE WAY
THROUGH PETRI GOWASKI TRACT.
SURVEYED - 3-1-50 BY
REVISED - 5-1-50
H. W. MIKESELL - R.P.E.
P. C. & C. Co.
TO
PETRI GOWASKI 4.32-A
IN 1924 DEED BK. 221-P 63.
SCALE 1" = 50'
ATRAN. BASE
MINE COURSE = N14°10'W
DEED COURSE = N69°00'W
DIFF. = S2°10'
S2°10' DIFF
R. & P. COAL Co.
TO ROUTE No. 56
TO TIDE
BLACK TOP ROUTE No. 32035
DEED
MINE DRIVE
EDGE FILL
BONEY FILL
NEW BINS & TIPPLE
IRON PINS ON LINE
IRON PIN BY JONES
LINE BY JONES
LINE BY SPENCE
LINE BY GEO. SPENCE
LINE BY JONES
LINE OF POST ON PROP. LINE
KROLICK No. 1 MINE
MAIN HAUL
S 24°-05' E
906.73'
N 13°-24' E
442.15'
N 14°-06' W
144.00'
N 2°-38' E
152.50'
264.60'
N 0°-38' W
627.20'
S 5°-48' E
231.38'
N 73°-29' E
M 16°-38' W
439.52'
S 1°-45' E
439.52'
M 88°-29' N
S 18°-53' E
DEED 86.99
S 27°-25' E
DEED 156.55'
S 28°-32' E
DEED 116.62'
S 13°-22' E
DEED 81.91'
M 18°-32' N
M 33°-42' W
M 32°-52' N
M 20°-42' N
M 55°-28'
M 88°-29' N
M 16°-38' W
N 10°-00' E
FALLEN WIT. TREES
DEAD OAK
CHEST. OAK
POST
COR
COR. POST & STONES
N 67°-30' E

IMAPS # 11708