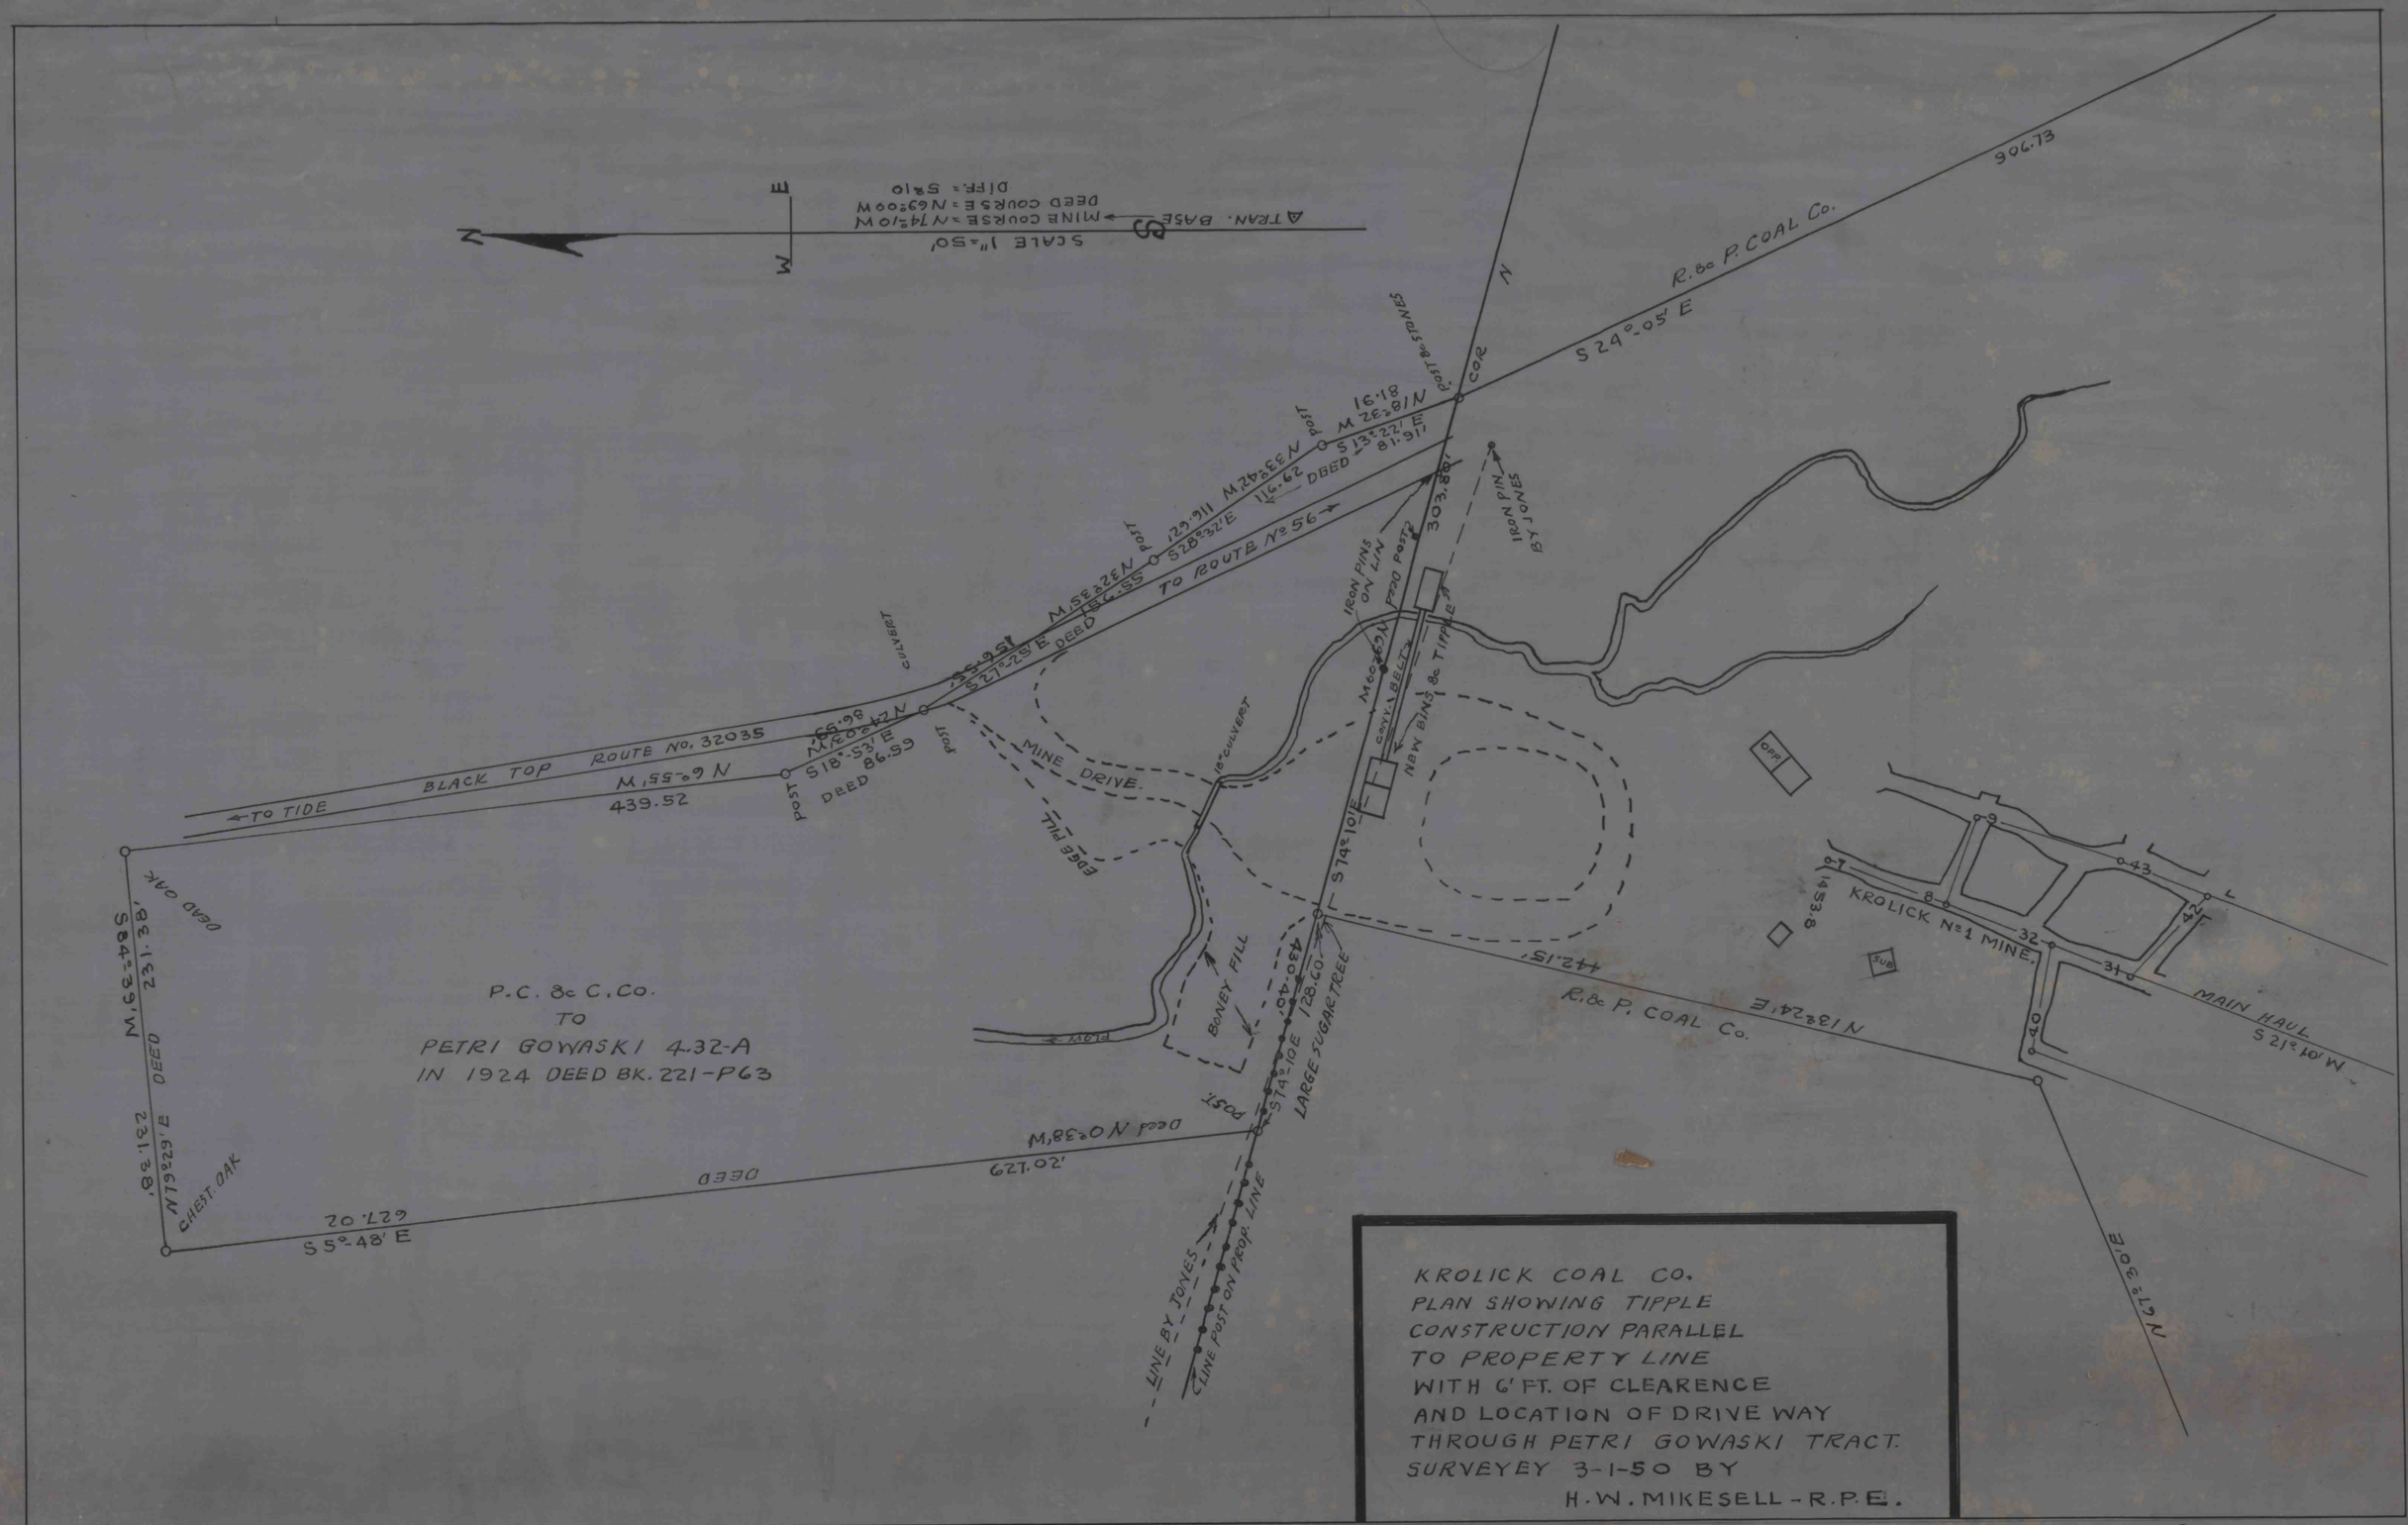

IMAPS # 17910

17X29