


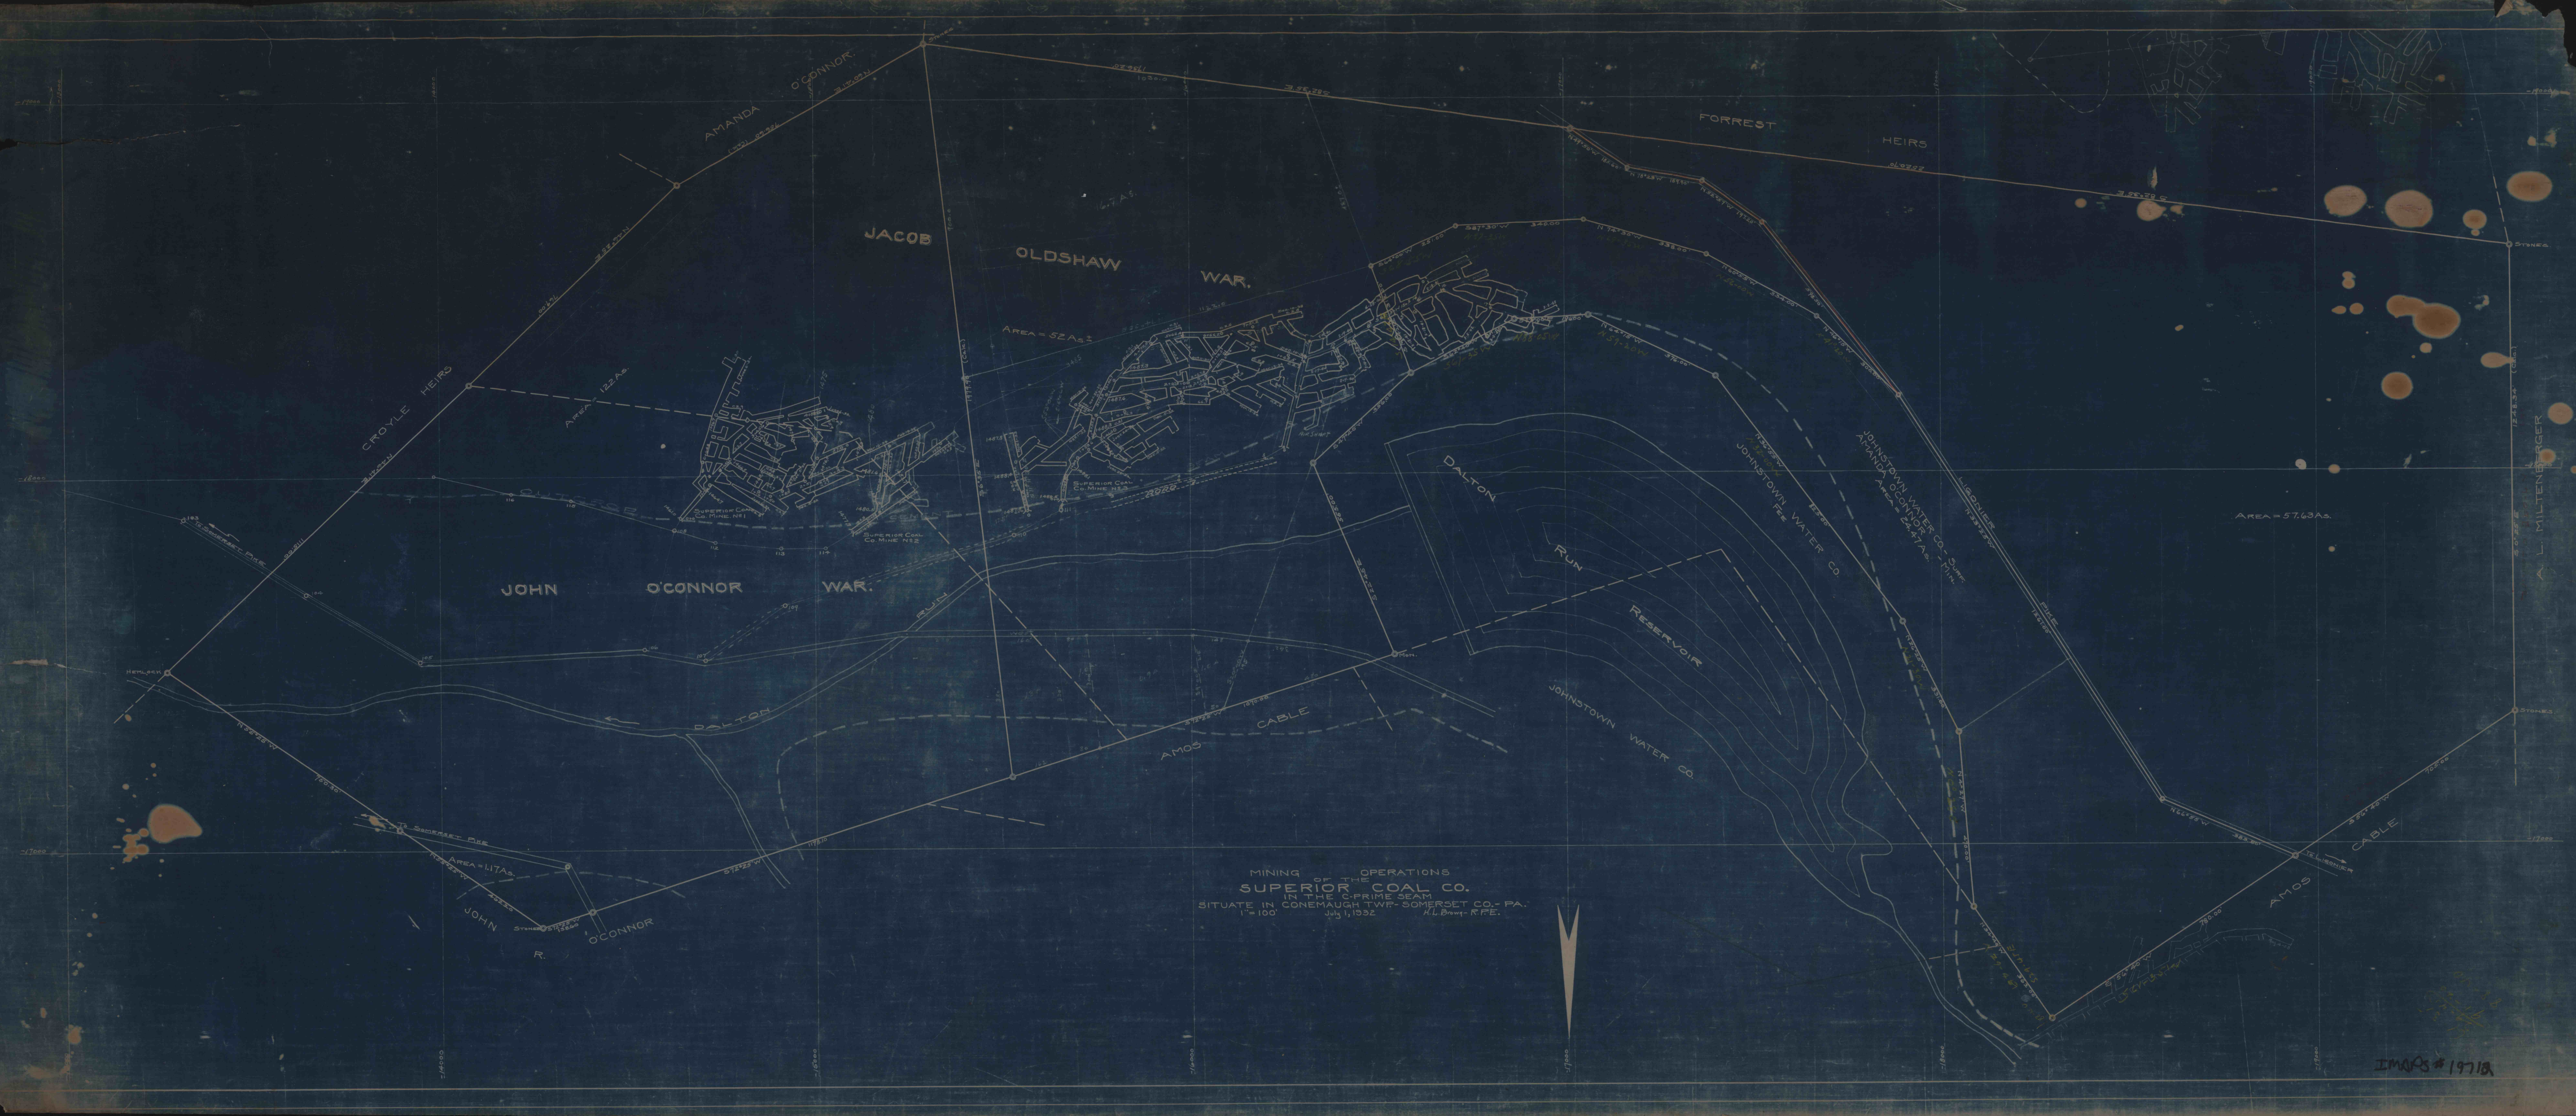

MINING OF THE OPERATIONS
SUPERIOR COAL CO.
IN THE C-PRIME SEAM
SITUATE IN CONEMAUGH TWP-SOMERSET CO.-PA.
1"=100
July 1, 1932
N.L. Brown - R.F.E.

IMAPS #19718