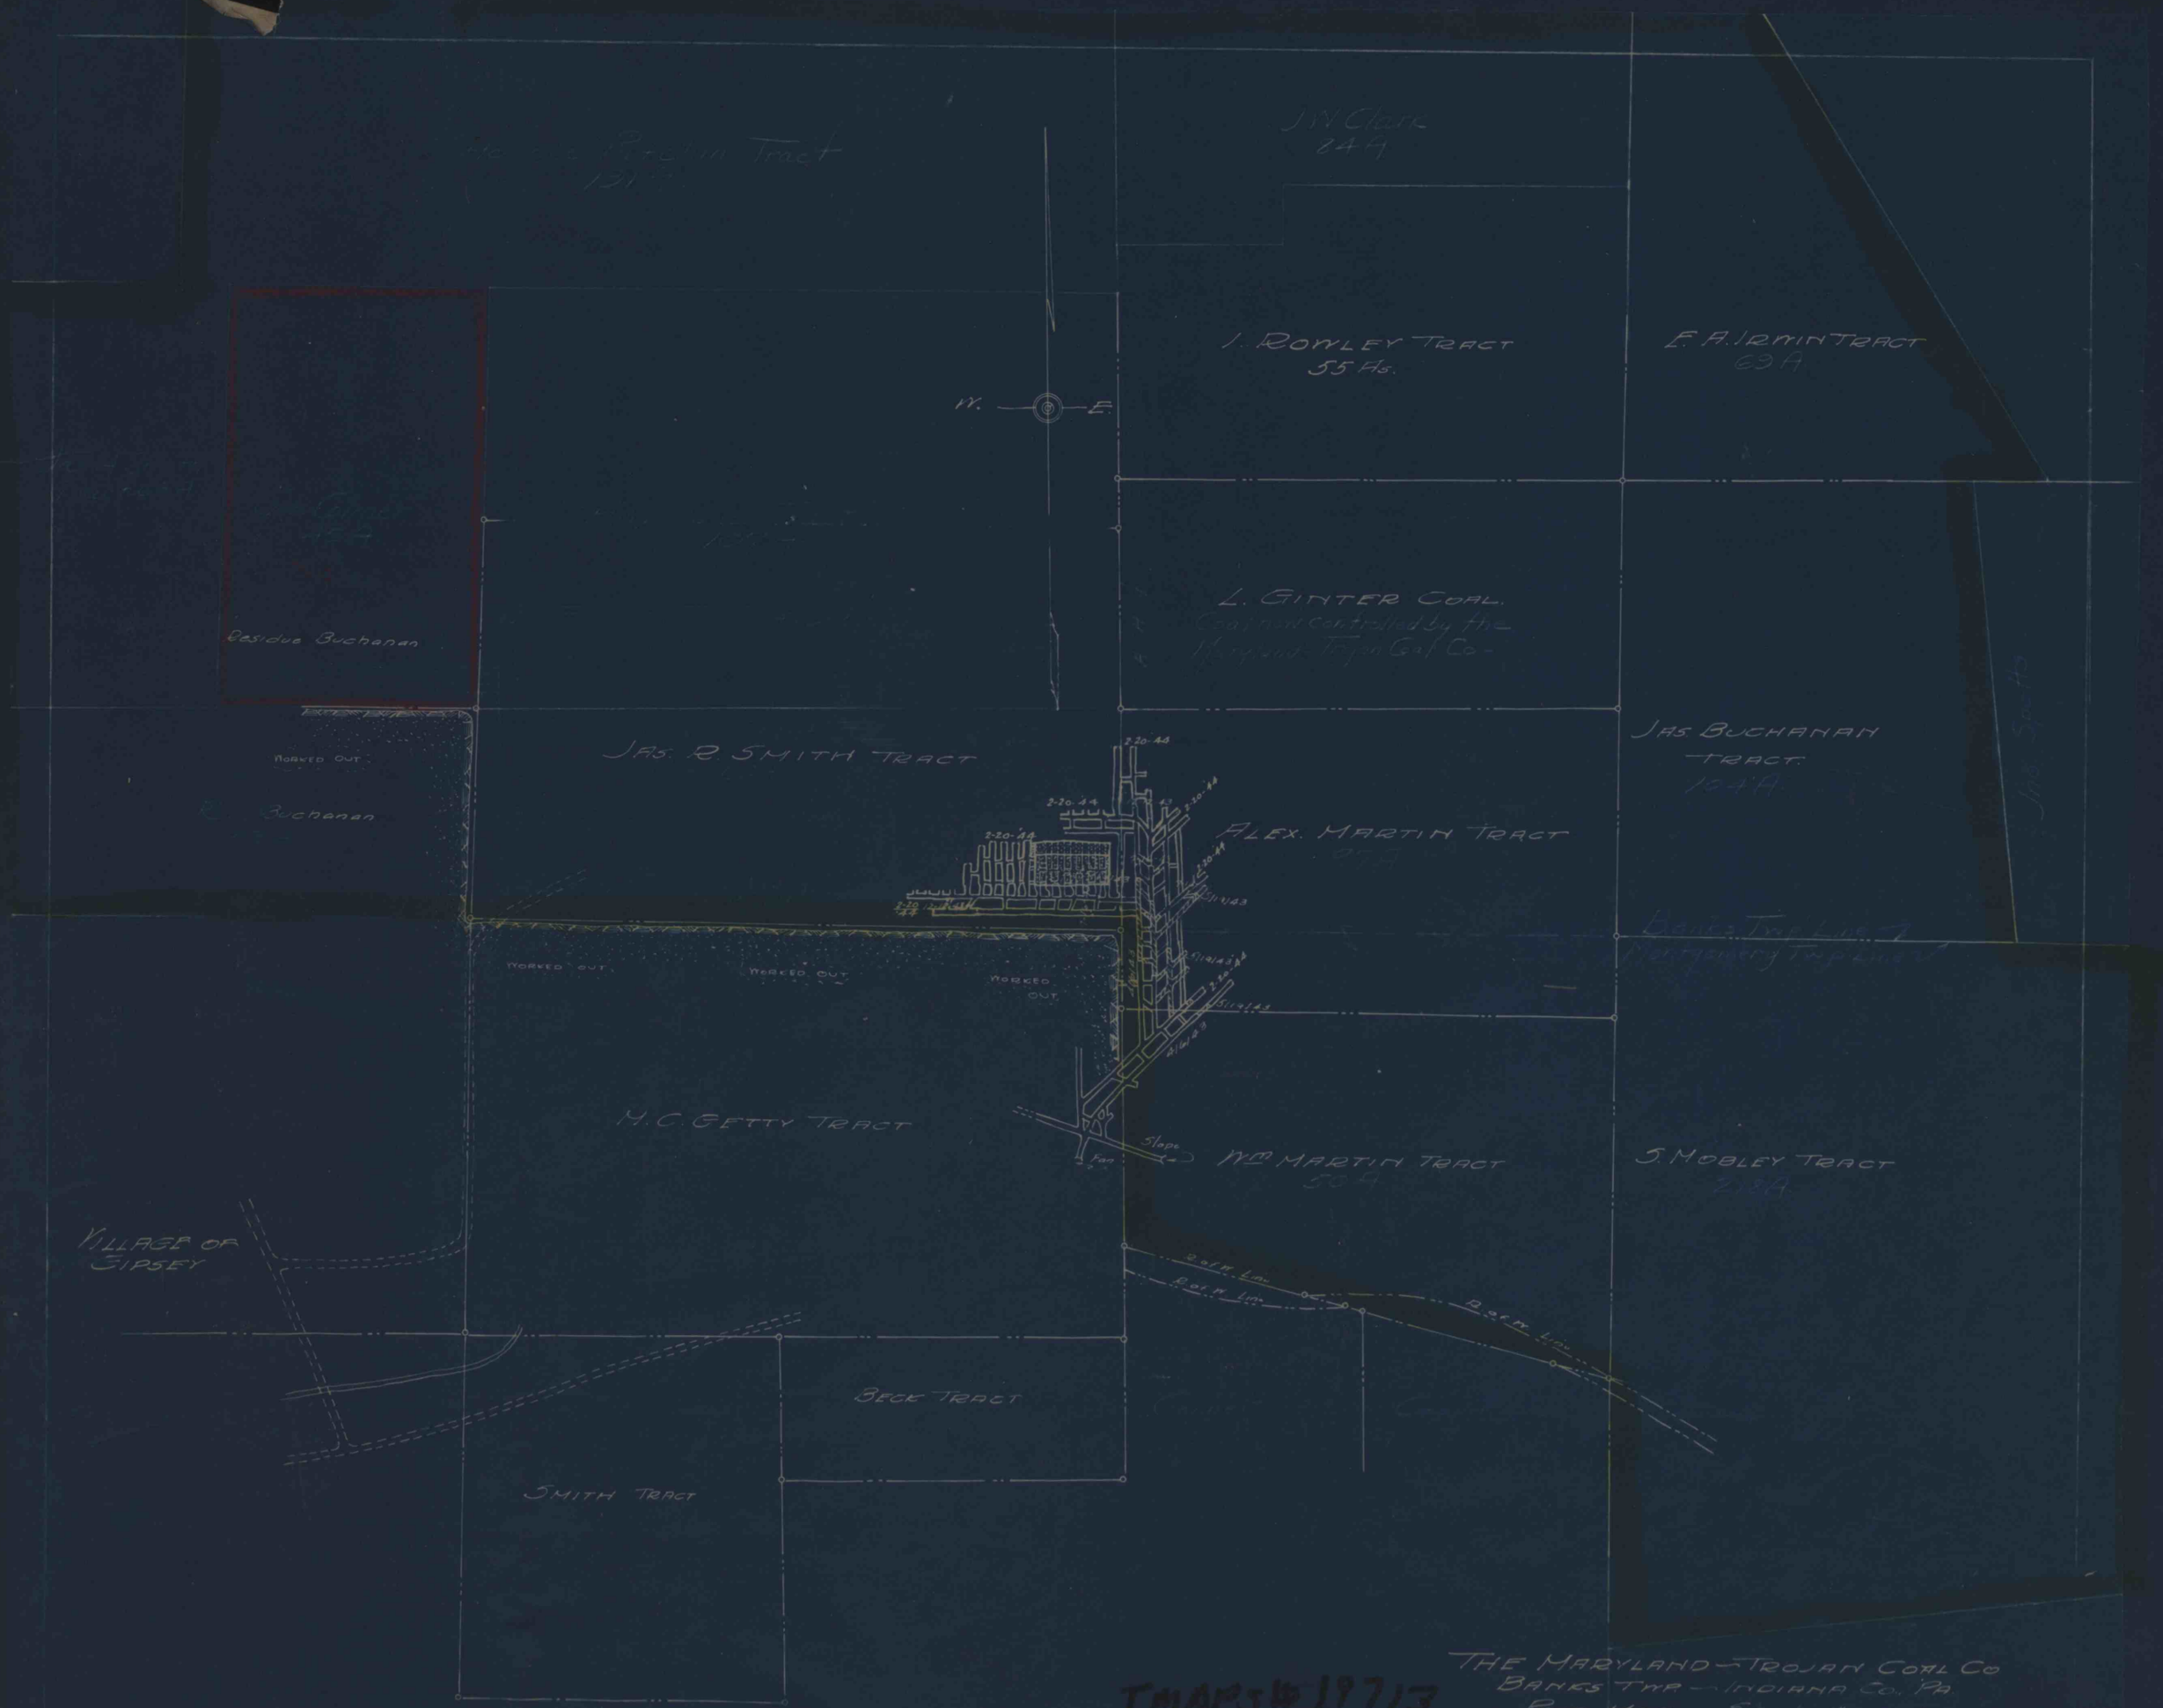

THE MARYLAND-TROJAN COAL CO
BANKS TWP — INDIANA CO. PA.
PROP. MAP — SCALE 1" = 400'
4/19/1943 — Thomas Paular Reg. Engr.
Indiana, Pa.
From Office Records & Deeds

IMAPS # 19713