


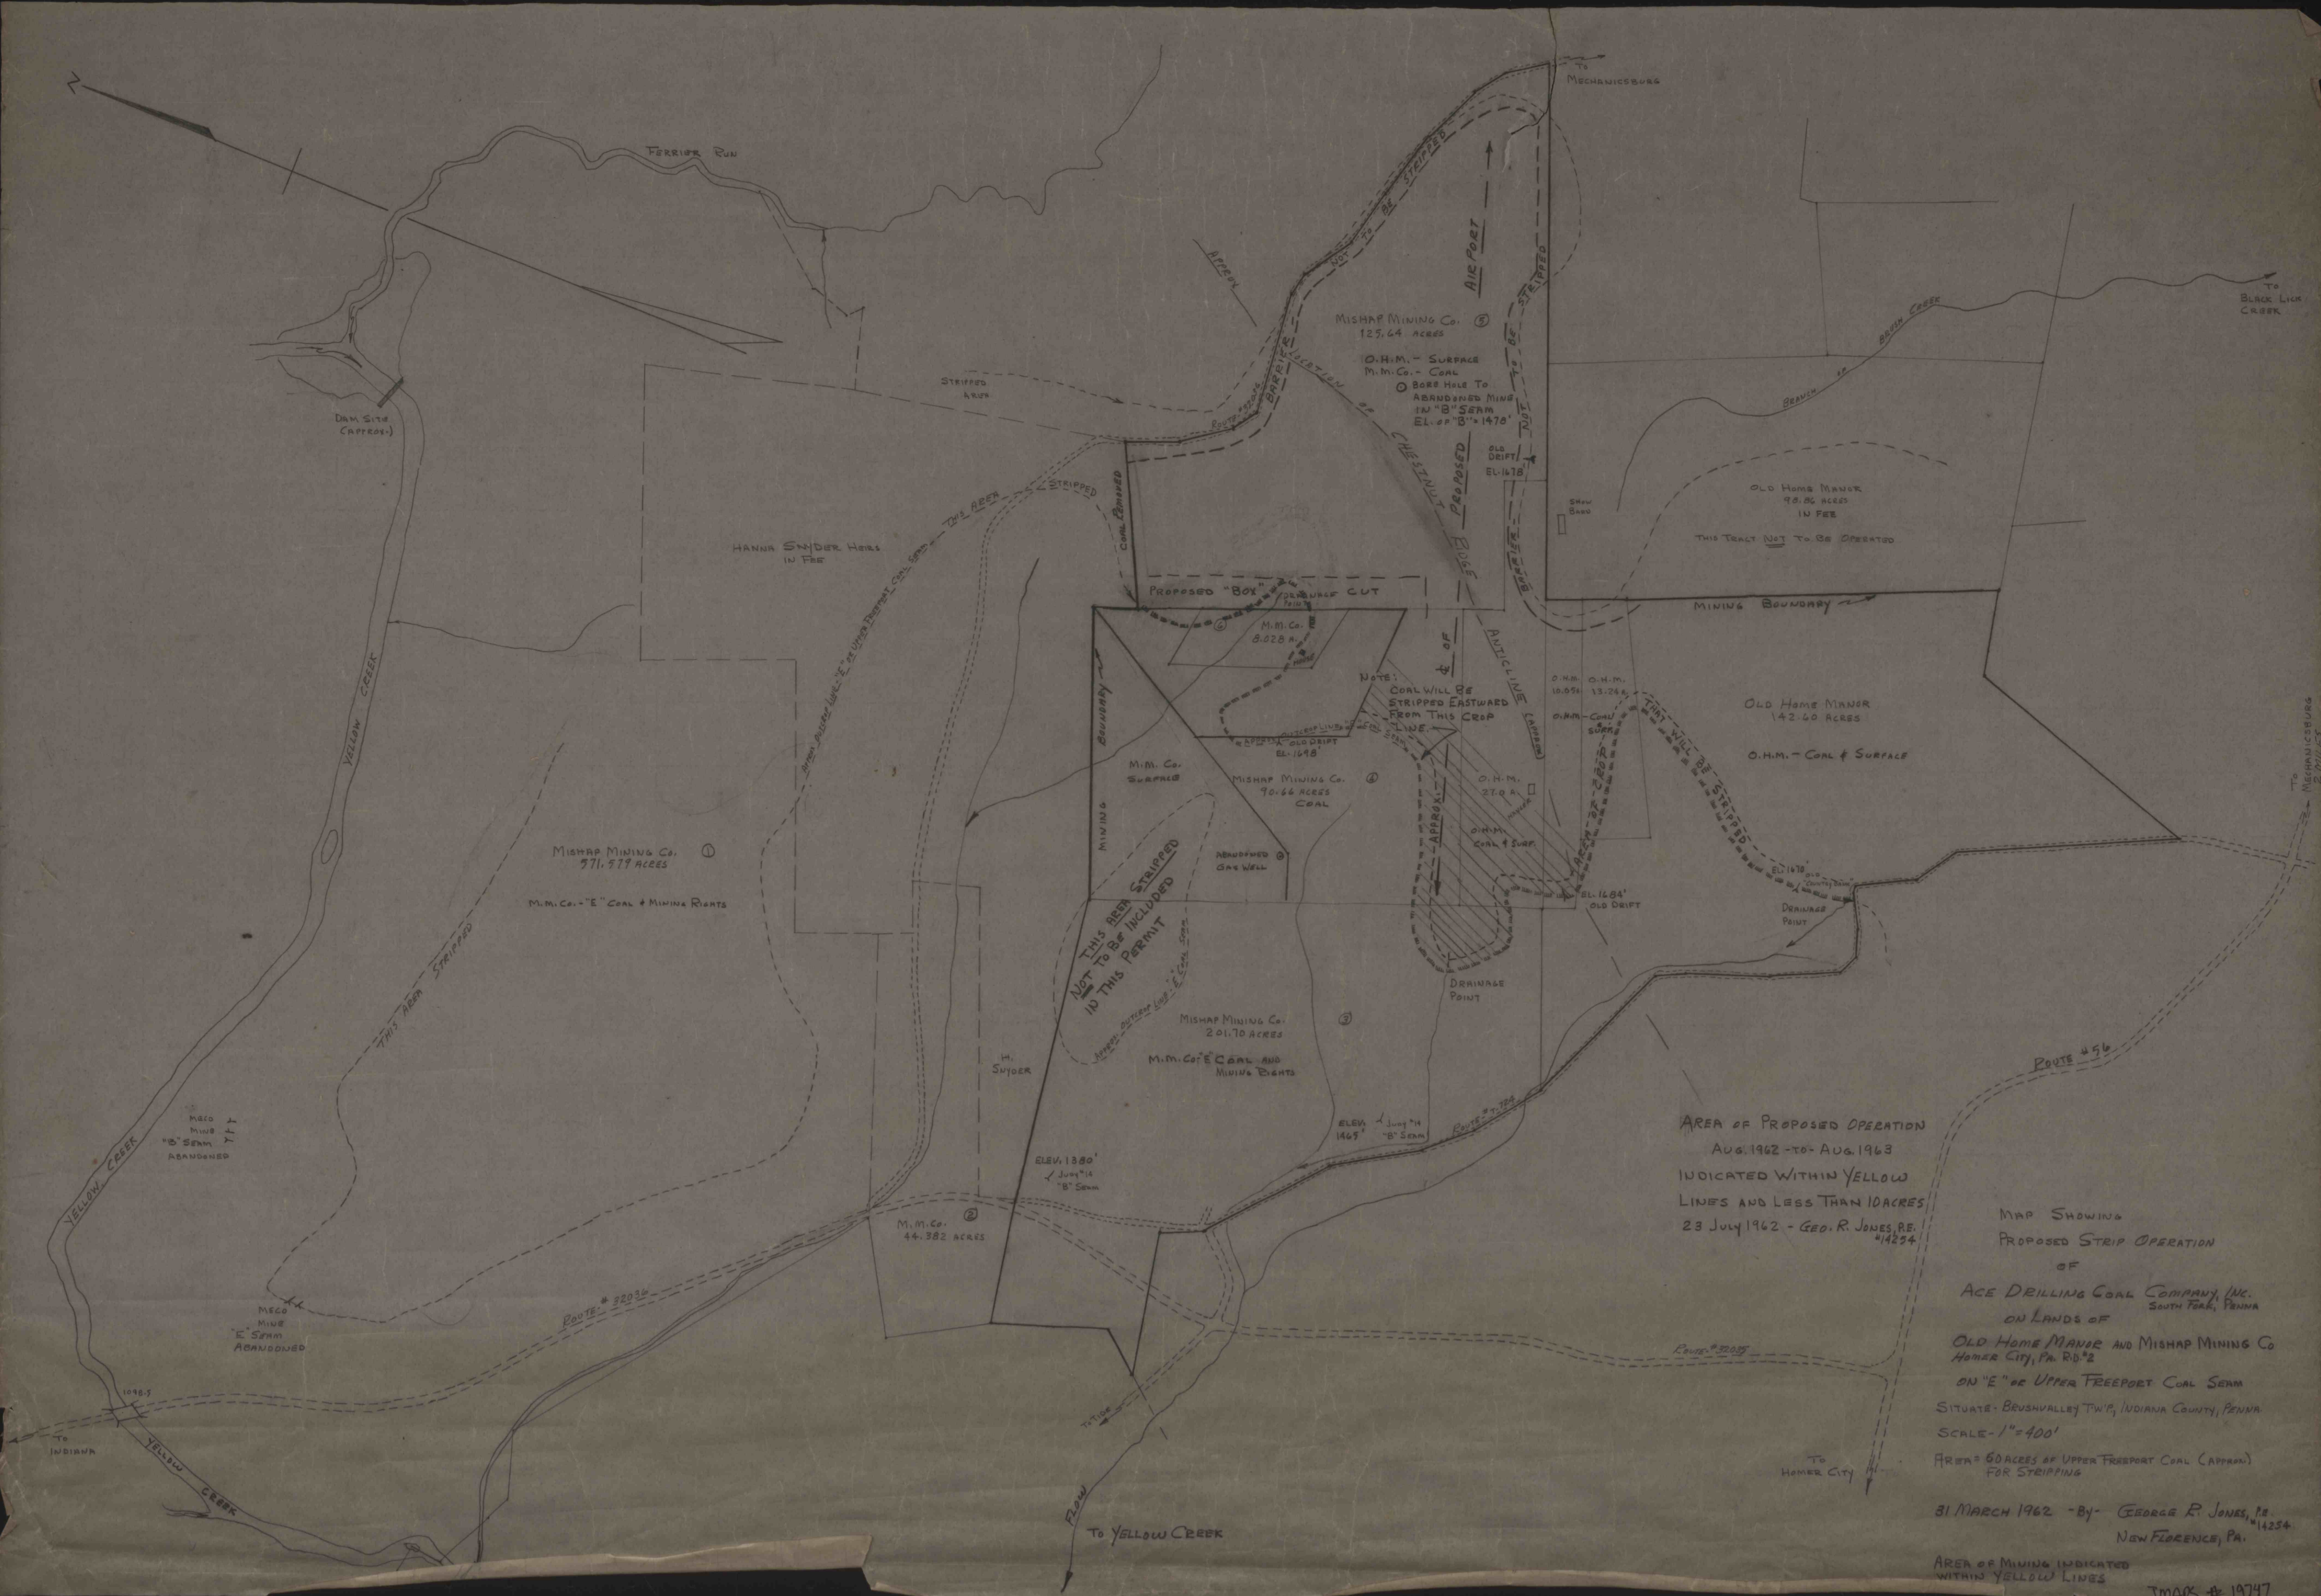

AREA OF PROPOSED OPERATION
AUG. 1962 - TO - AUG. 1963
INDICATED WITHIN YELLOW
LINES AND LESS THAN 10 ACRES
23 JULY 1962 - GEO. R. JONES, JR.
#14254

MAP SHOWING
PROPOSED STRIP OPERATION
OF
ACE DRILLING COAL COMPANY, INC.
SOUTH YORK, PENNA.
ON LANDS OF
OLD HOME MANOR AND MISHAP MINING CO.
HOMER CITY, PA. RD #2
ON "E" OF UPPER FREEPORT COAL SEAM
SITUATE - BRUSHVALLEY TWP., INDIANA COUNTY, PENNA.
SCALE - 1" = 400'
AREA = 60 ACRES OF UPPER FREEPORT COAL (APPROX.)
FOR STRIPPING
31 MARCH 1962 - BY - GEORGE R. JONES, JR.
NEW FLORENCE, PA. #14254
AREA OF MINING INDICATED
WITHIN YELLOW LINES
IMAPS # 19747