


NOTE:

MURPHY TRACT
TOTAL AREA
100 ACRES (±)
OLD HOME MANOR
OWNED BY "B" COAL
NEW "IN FEE"
"E" COAL LISTED AS
TRACT "FIFTH" FROM
H.H. BENNETT
See D.B. Vol. 239, Pg. 111

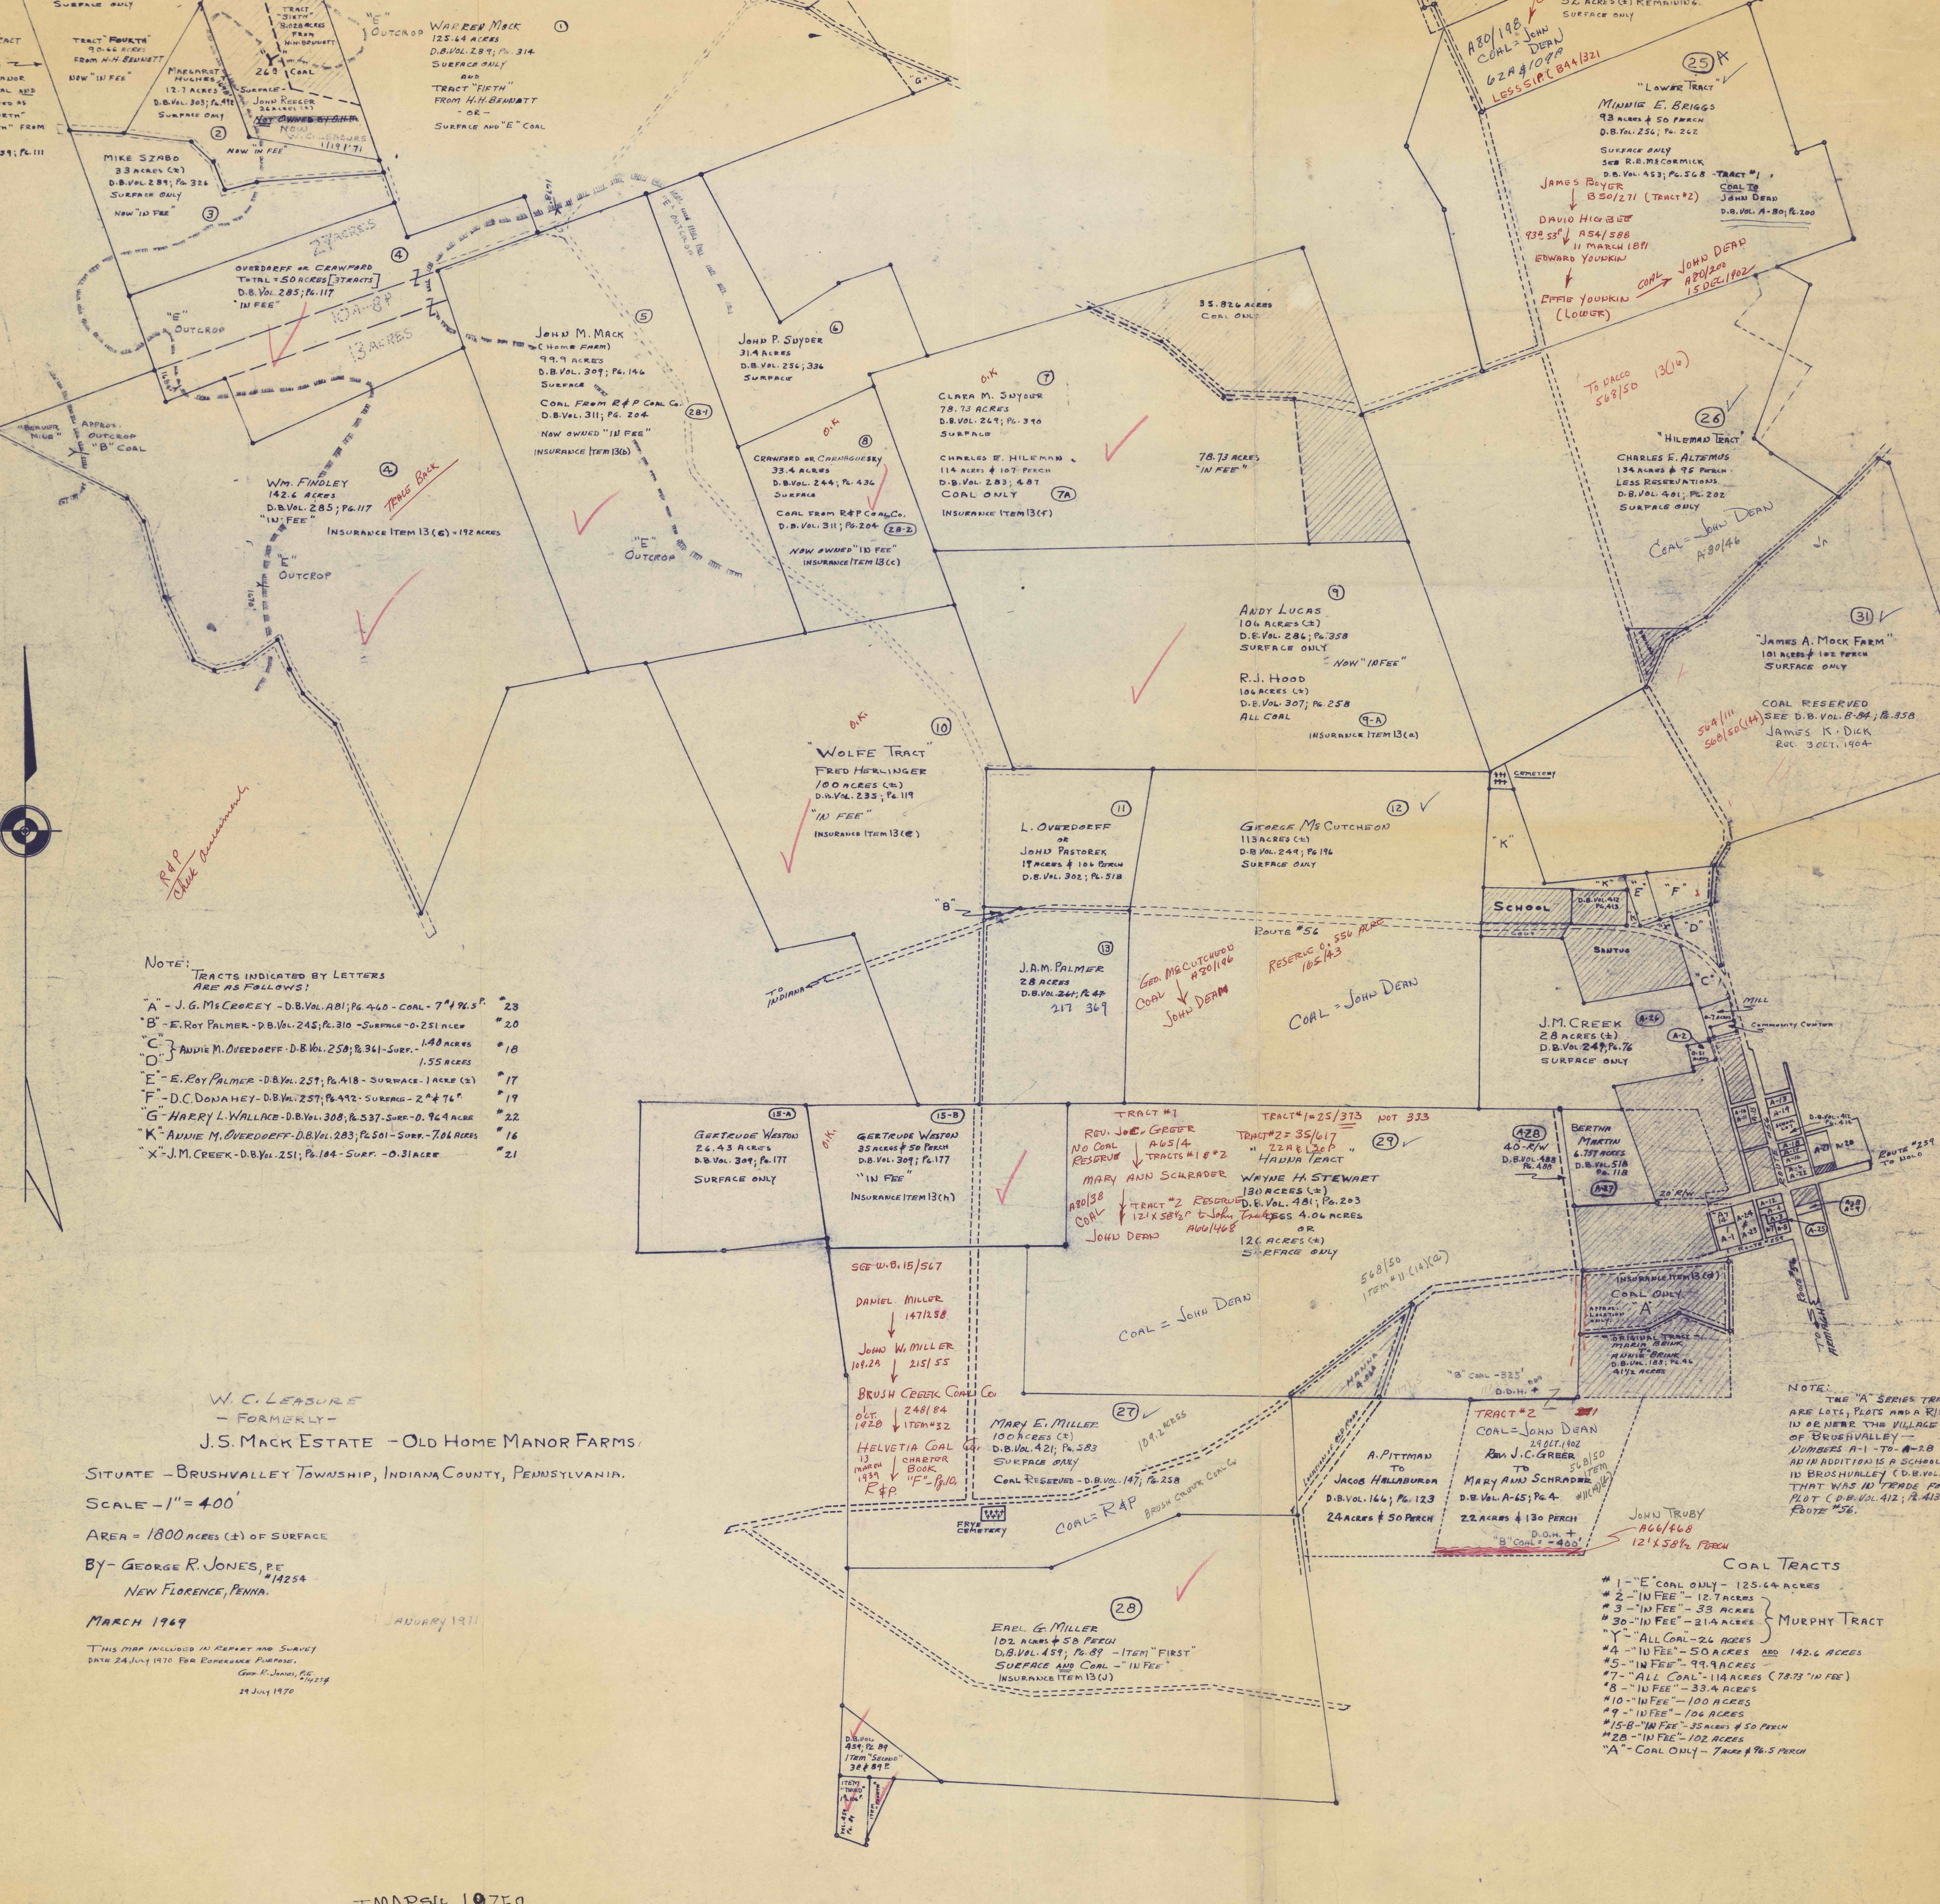

NOTE:

- TRACTS INDICATED BY LETTERS
ARE AS FOLLOWS:
 - "B" - E. Roy Palmer - D.B. Vol. 245, Pg. 310 - SURFACE - 0.251 ACRES * 20
 - "C" - ANNIE M. OVERDOFF - D.B. Vol. 250, Pg. 361 - SURF. - 1.40 ACRES * 18
 - "G" - HARRY L. WALLACE - D.B. Vol. 308, Pg. 537 - SURF. - 0.964 ACRES * 22
 - "K" - ANNIE M. OVERDOFF - D.B. Vol. 283, Pg. 501 - SURF. - 7.04 ACRES * 16
 - "X" - J.M. CREEK - D.B. Vol. 251, Pg. 104 - SURF. - 0.31 ACRES * 21

W.C. LEASURE
- FORMERLY -
J.S. MACK ESTATE - OLD HOME MANOR FARMS

SITUATE - BRUSHVALLEY TOWNSHIP, INDIANA COUNTY, PENNSYLVANIA.

SCALE - 1" = 400'

AREA = 1800 ACRES (±) OF SURFACE

BY - GEORGE R. JONES, P.E.
#14254
NEW FLORENCE, PENNA.

MARCH 1969

THIS MAP INCLUDED IN REPORT AND SURVEY
DATE 24 JULY 1970 FOR PURPOSES OF
GEO. R. JONES, P.E.
24 JULY 1970

NOTE:
THE "A" SERIES TRACTS
ARE LOTS, PLOTS AND A R/W
IN OR NEAR THE VILLAGE
OF BRUSHVALLEY -
NUMBERS A-1 TO A-28
AND IN ADDITION IS A SCHOOL LOT
IN BRUSHVALLEY (D.B. Vol. 412, Pg. 414)
THAT WAS IN TERRA FOR ANOTHER
PLOT (D.B. Vol. 412, Pg. 413) ALONG
ROUTE #56.

COAL TRACTS

- #1 - "E" COAL ONLY - 125.64 ACRES
- #2 - "IN FEE" - 12.7 ACRES
- #3 - "IN FEE" - 33 ACRES
- #4 - "IN FEE" - 50 ACRES AND 142.6 ACRES
- #5 - "IN FEE" - 99.9 ACRES
- #7 - "ALL COAL" - 114 ACRES (78.73 "IN FEE")
- #8 - "IN FEE" - 33.4 ACRES
- #10 - "IN FEE" - 100 ACRES
- #9 - "IN FEE" - 106 ACRES
- #15-B - "IN FEE" - 35 ACRES & 50 PERCH
- #28 - "IN FEE" - 102 ACRES
- "A" - COAL ONLY - 7 ACRES & 76.5 PERCH