


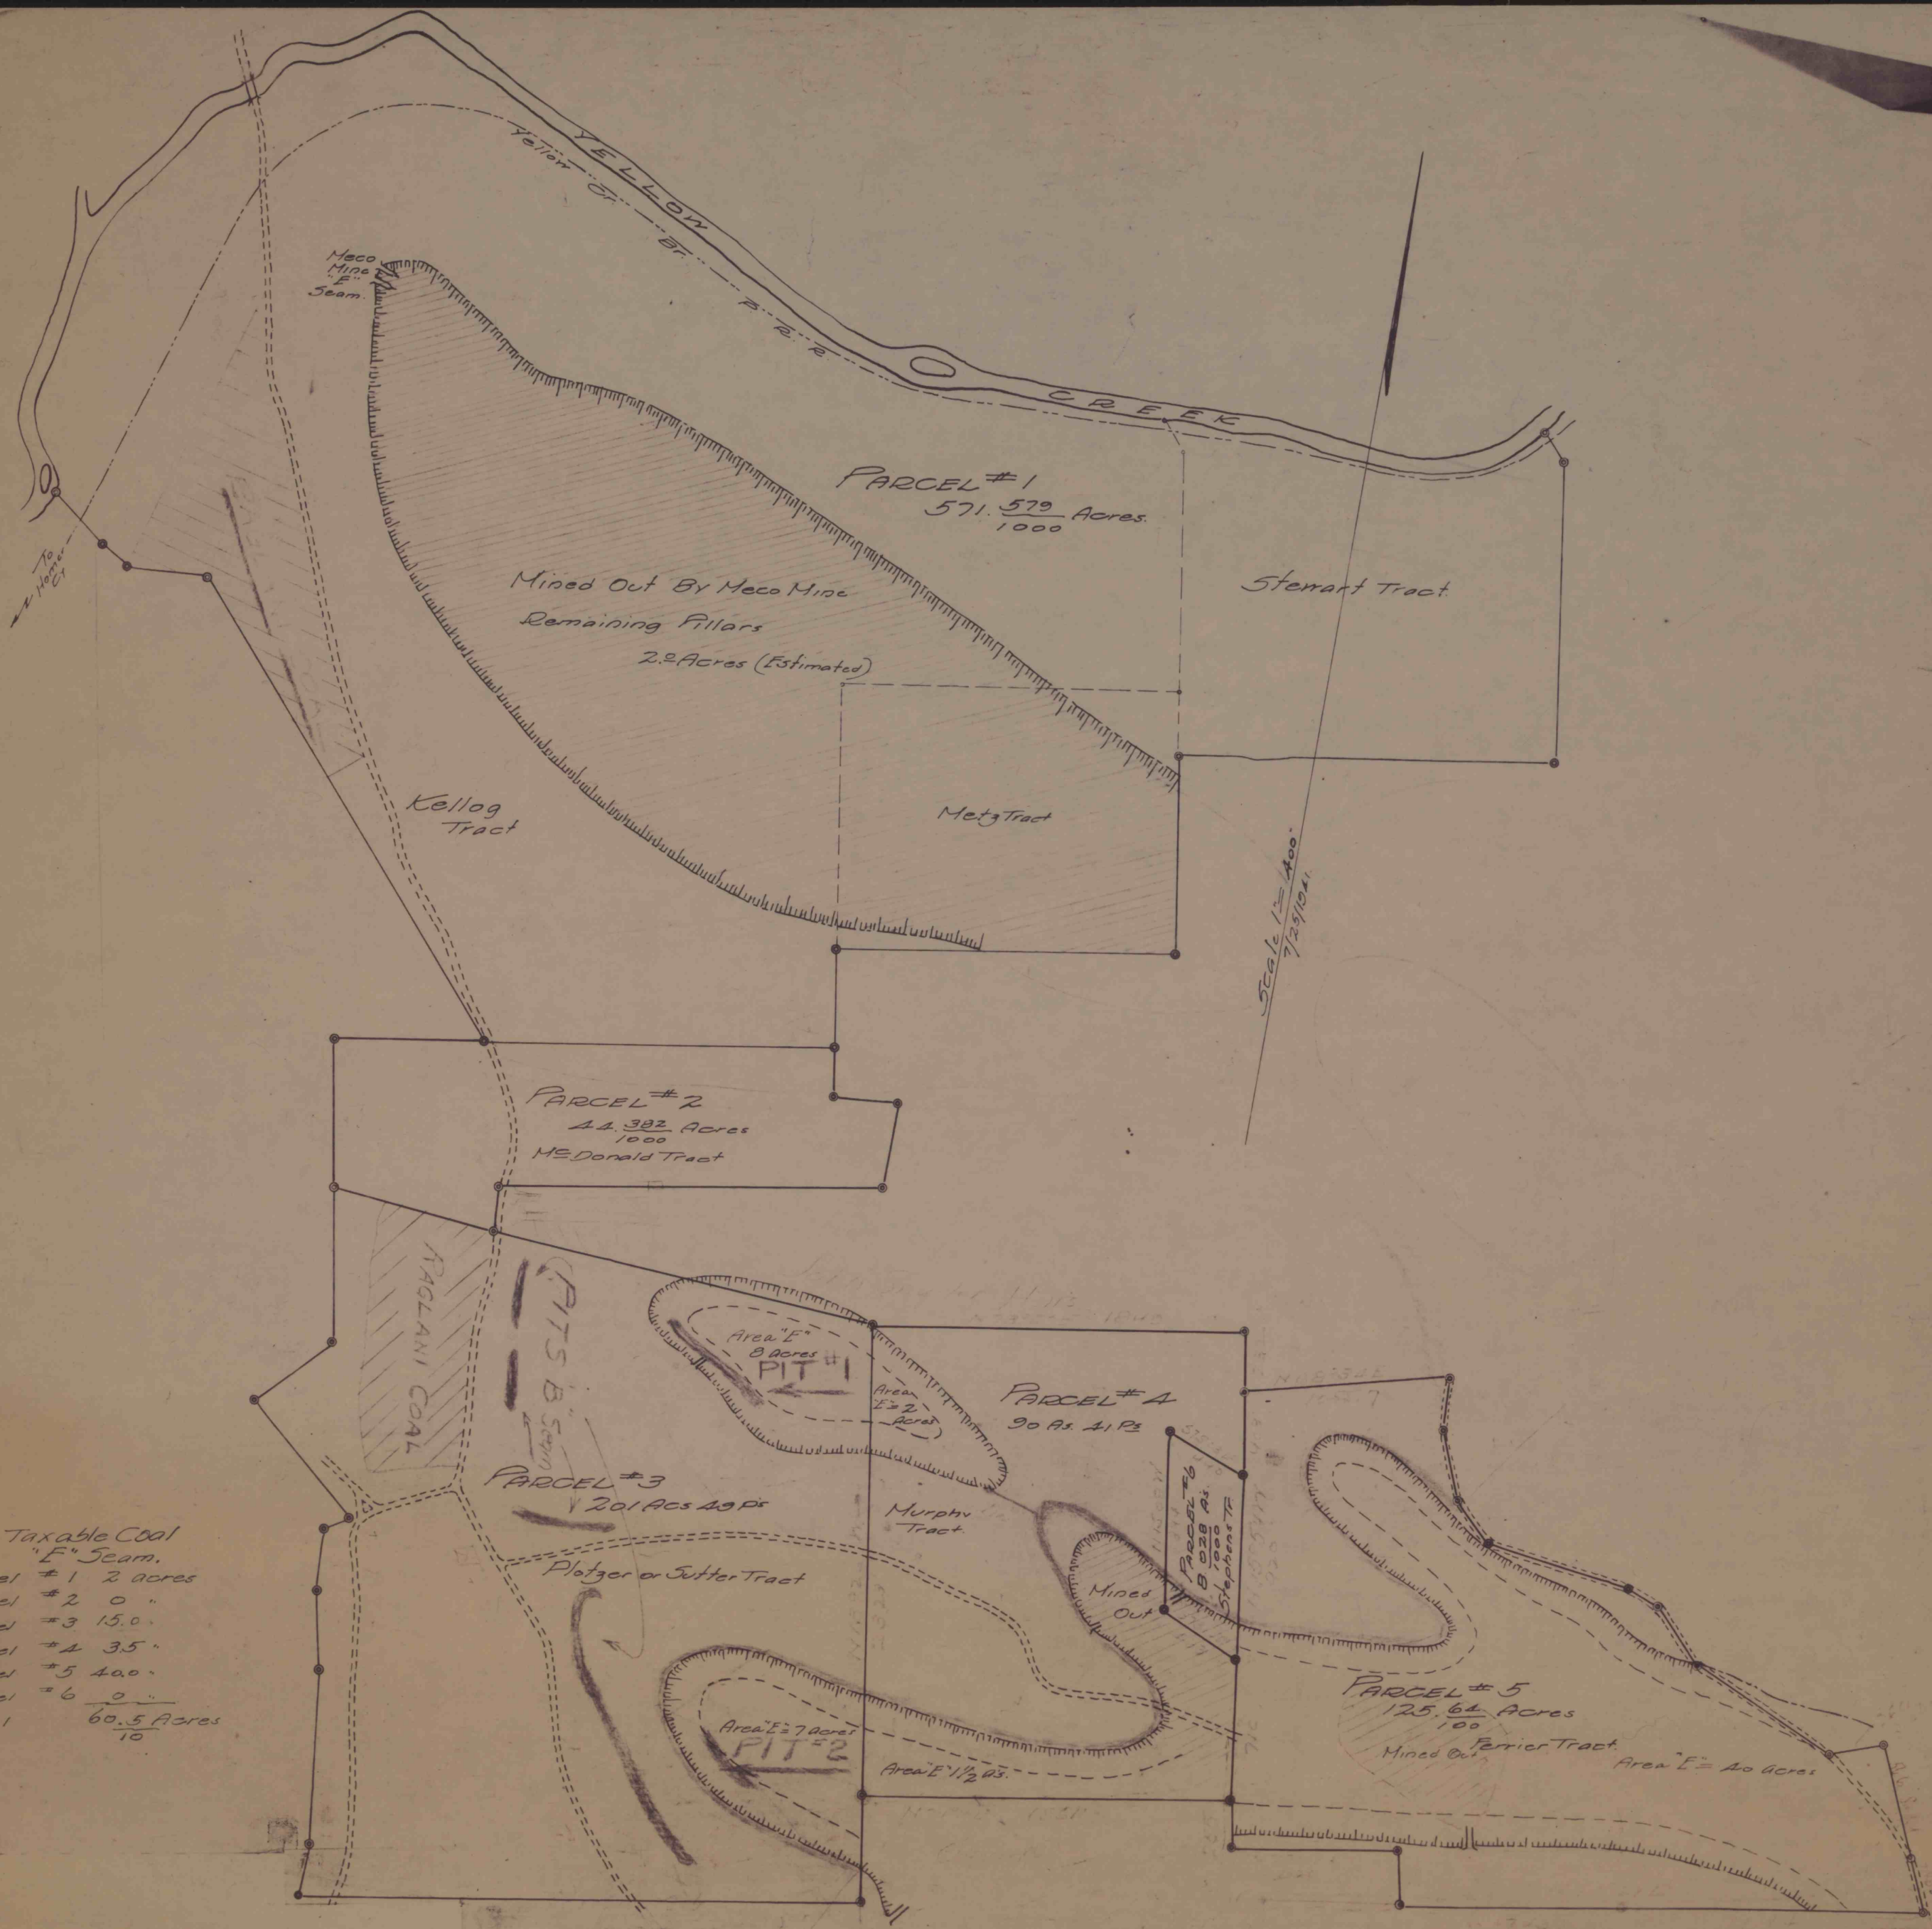

Map Showing
 Reservation of
 The Top, or Six Foot Vein of Coal ("E" Seam)
 As Described in Deed of 2/13/1931
 W.C. Bennett - H. H. Bennett and Edw. B. Bennett
 To
 The General Coal Co.
 Situate - Brush Valley Twp. Ind. Co. - Compiled from Office Records - Thos. Poler
 Reg. Engr.

IMAPS # 19765