


MINE

No. 6.

P.T.R.R. & C. Co.

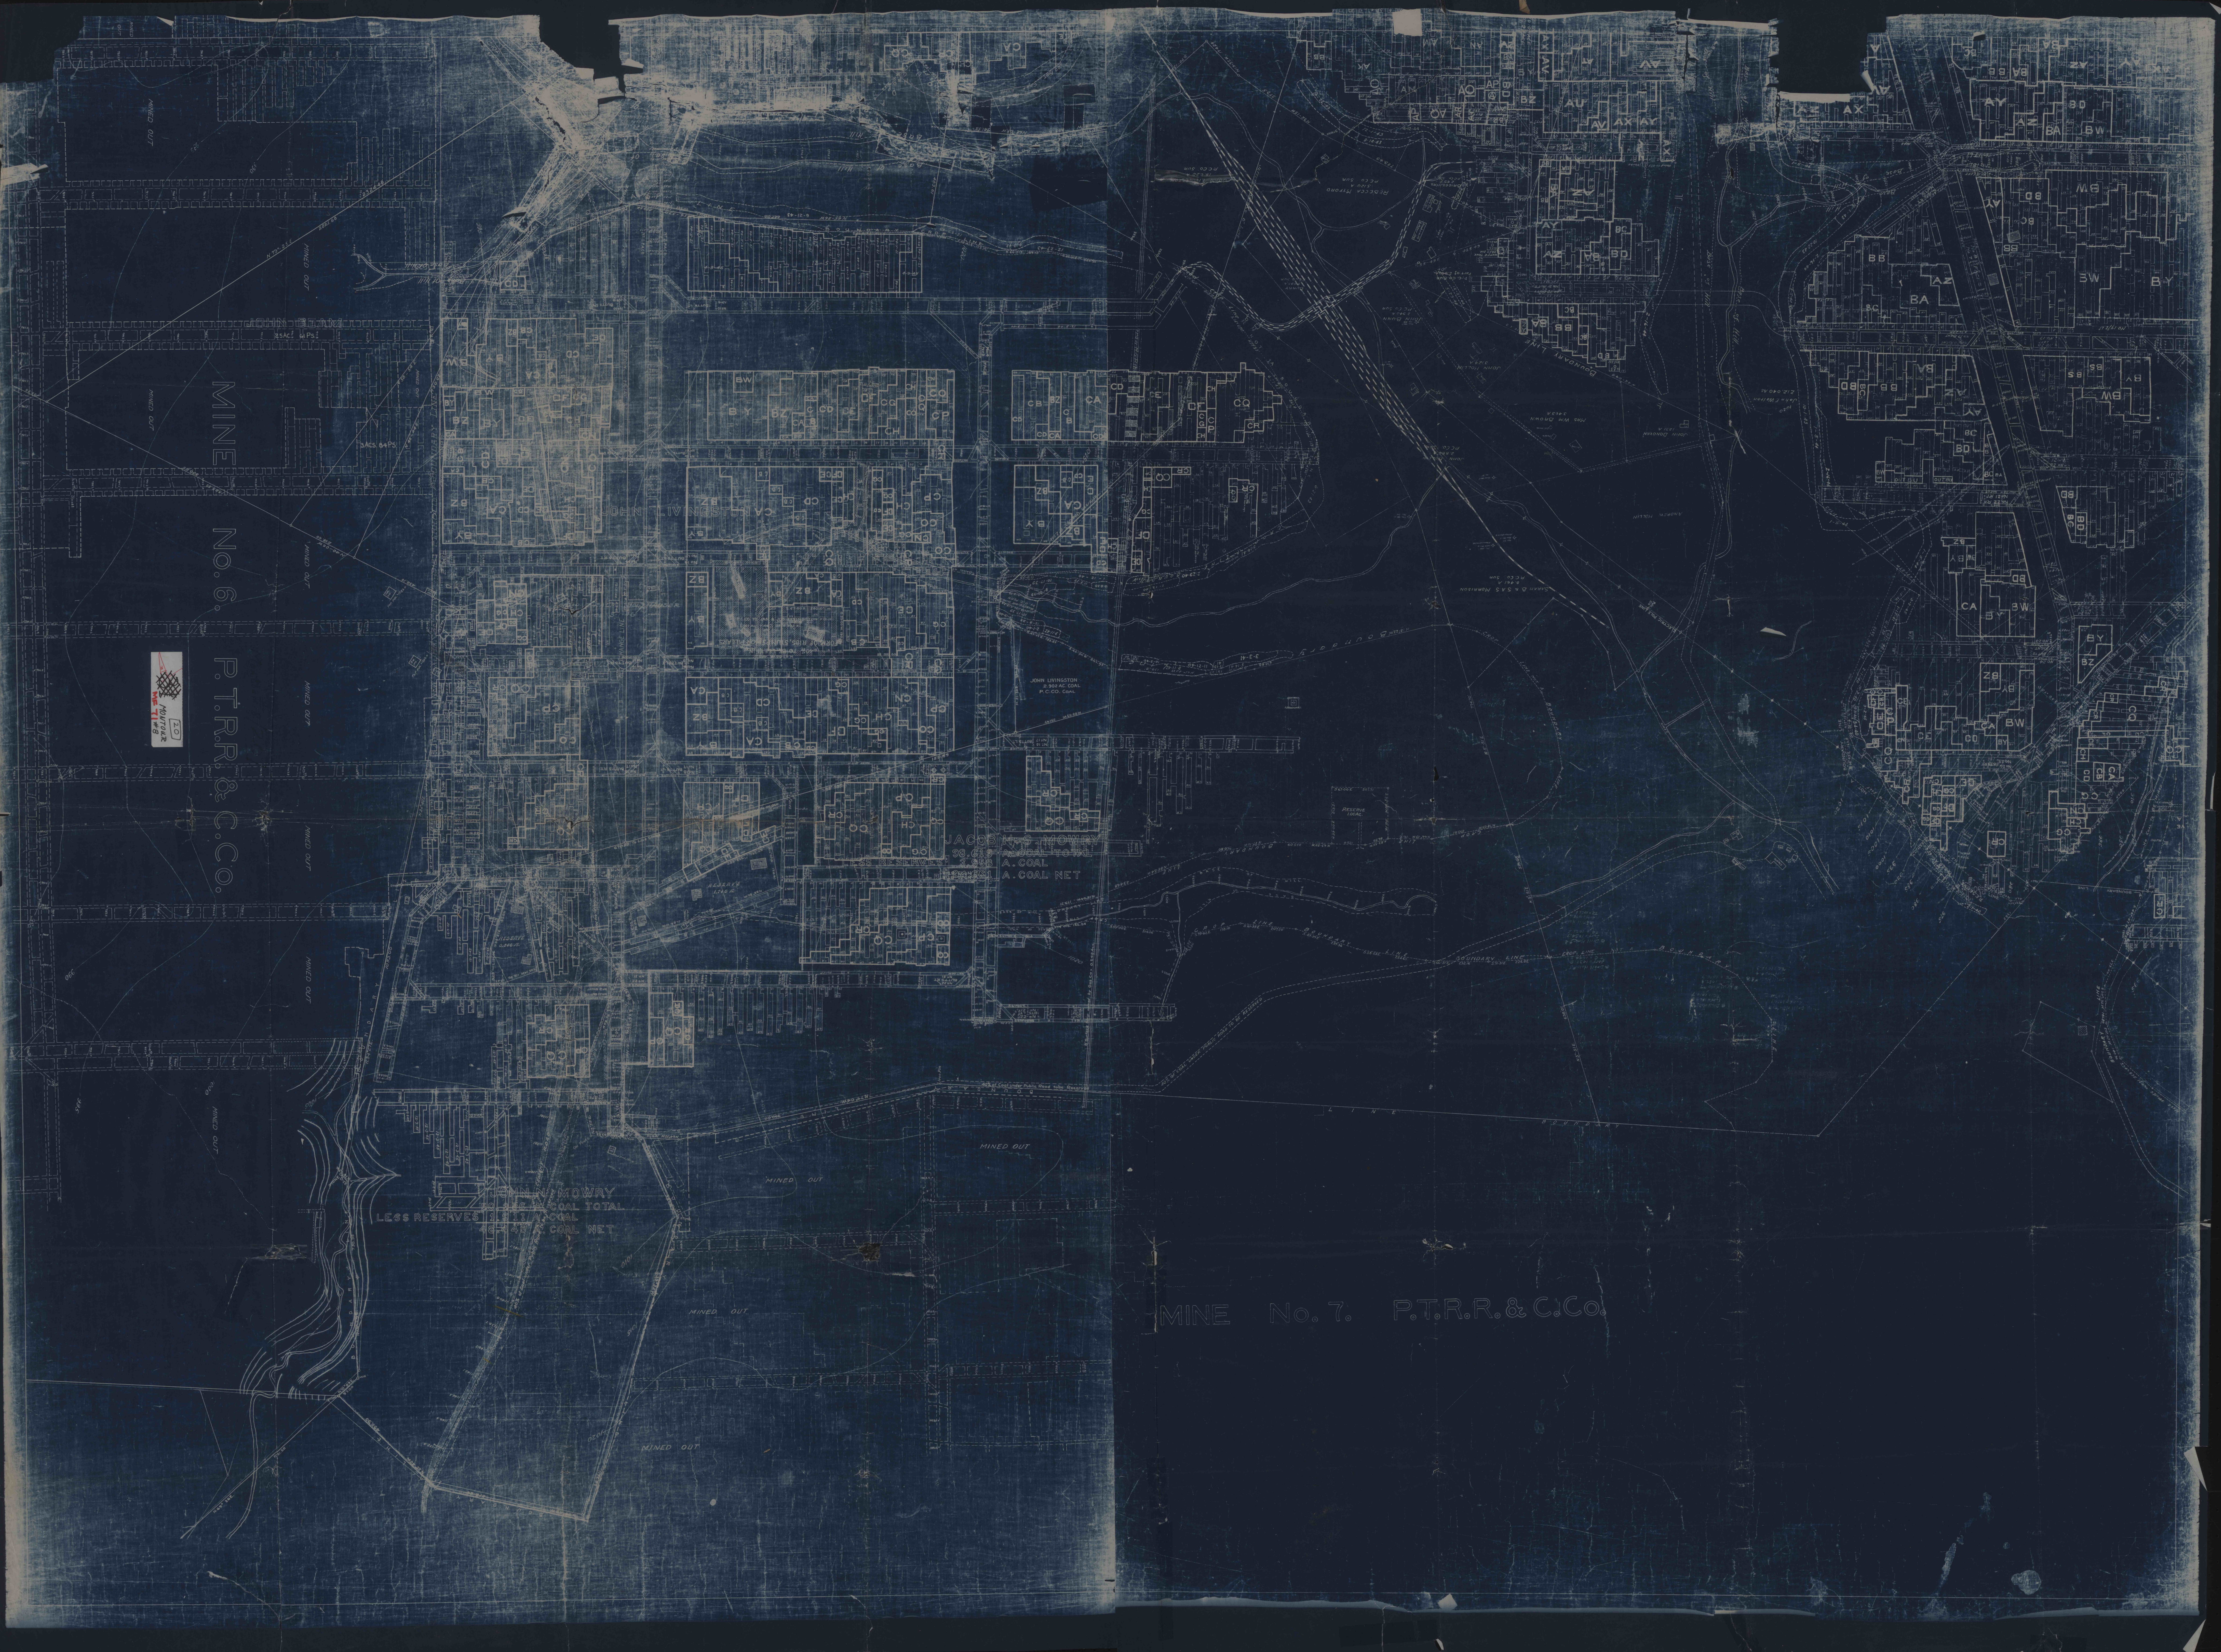

JOHN LIVINGSTON
LESS RESERVES
A. COAL NET

JACOBSON'S MOWRY
LESS RESERVES
A. COAL NET

MINE No. 7. P.T.R.R. & C. Co.