


KEYSTONE COAL MINING CORP.
JANE MINE
 PLUMCREEK & COWANSHANNOCK TWP.
 ARMSTRONG CO.
 PERMIT NO. 03831305
 FINAL MINING
 SCALE 1"=400'

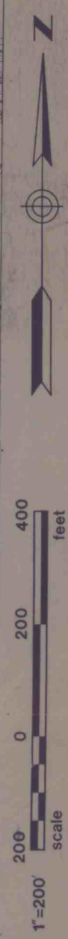

David A Cobough

569-20 1995
 Dept. of Environmental Protection
 Mcmurray District Office



POSTING DATE 12 - 31 - 1975
 Final Mining

JANE MINE (MSHA) No. 3600823
 JANE MINE PERMIT (DER) No. 03831305

(COAL SEAM)
 LOWER FREEPORT

JANE MINE
 KEYSTONE COAL MINING CORP.
 PLUMCREEK & COWANSHANNOCK TWP. ARMSTRONG CO.
 Sheet 2 of Permit Maps
 JANE 400-02